



113+00
 END APPROACH/BEGIN PROJECT STA. 113+00

EXCAVATION ~ (4.25' X 63') + (2.5' X 1.42') = 282 SF
 DENSE GRADED ~ 2.00' X 63' = 126 SF
 SAND BORROW ~ 1.50' X 63' = 94.5 SF

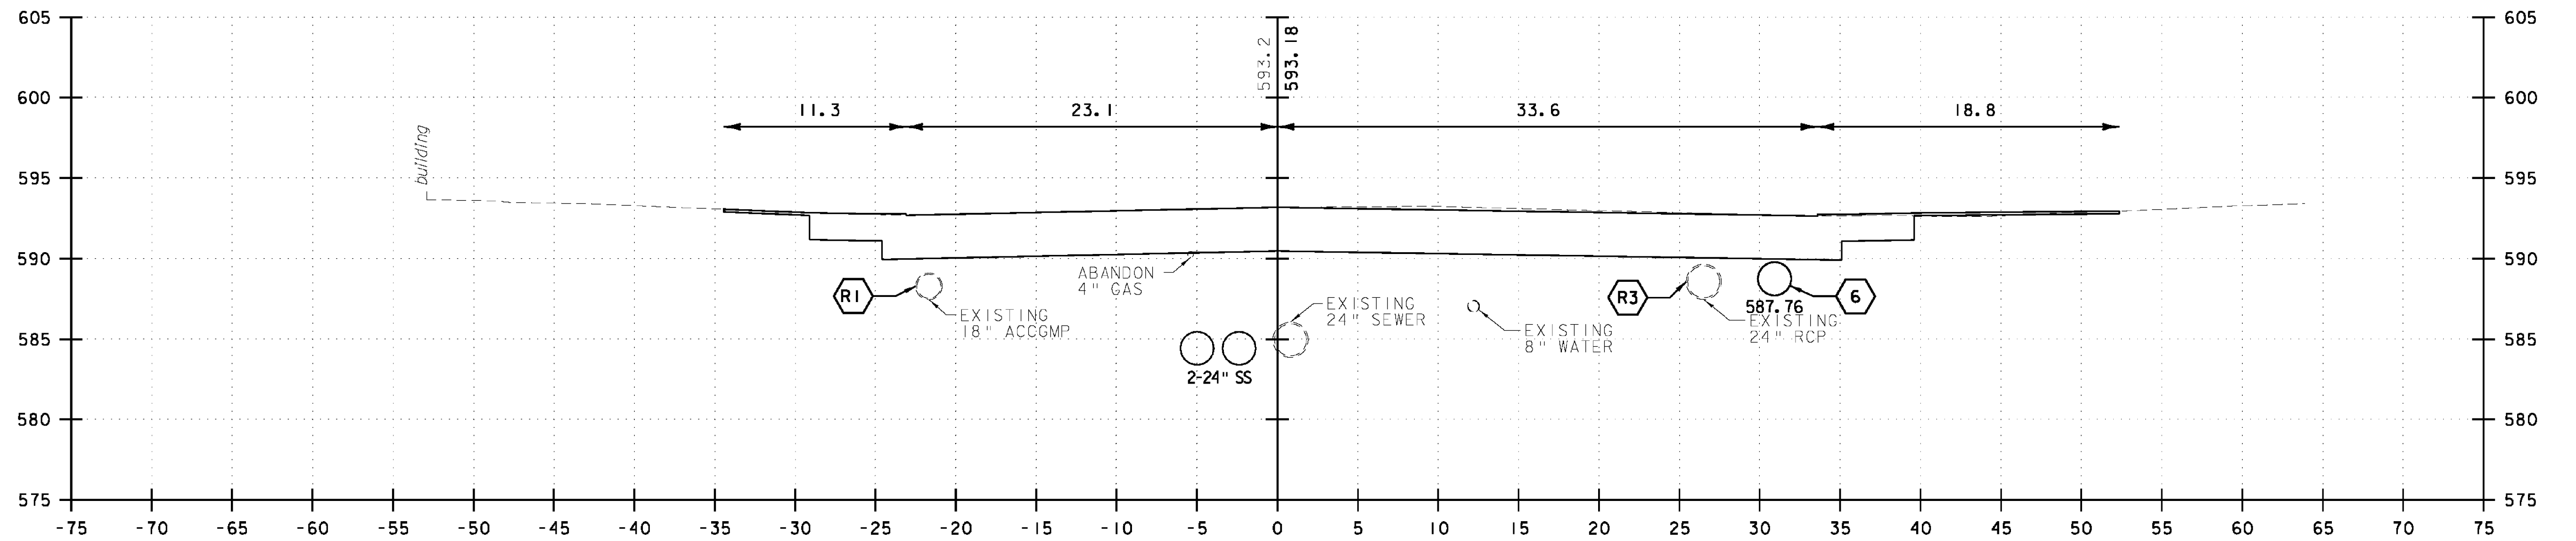

112+55

+55
 DRIVE R NORTH MAIN STREET (US 302)

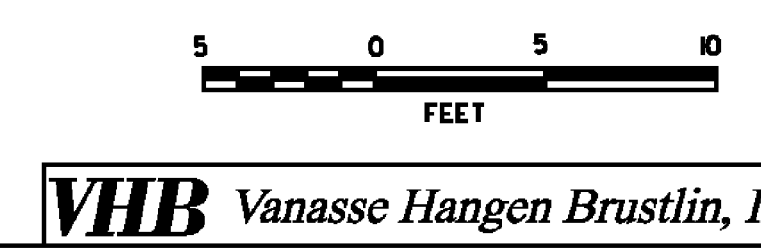

VHB Vanasse Hangen Brustlin, Inc.

PROJECT NAME:	BARRE CITY	PLOT DATE:	3/9/2011
PROJECT NUMBER:	FEGC F 026-(134) C/2	DRAWN BY:	DMP / JAR
FILE NAME:	85b010_xsl.Cu+1.C2	CHECKED BY:	
PROJECT LEADER:	G. BAKOS	SHEET	233 OF 339
DESIGNED BY:	DMP / MDS		
CROSS SECTIONS			