



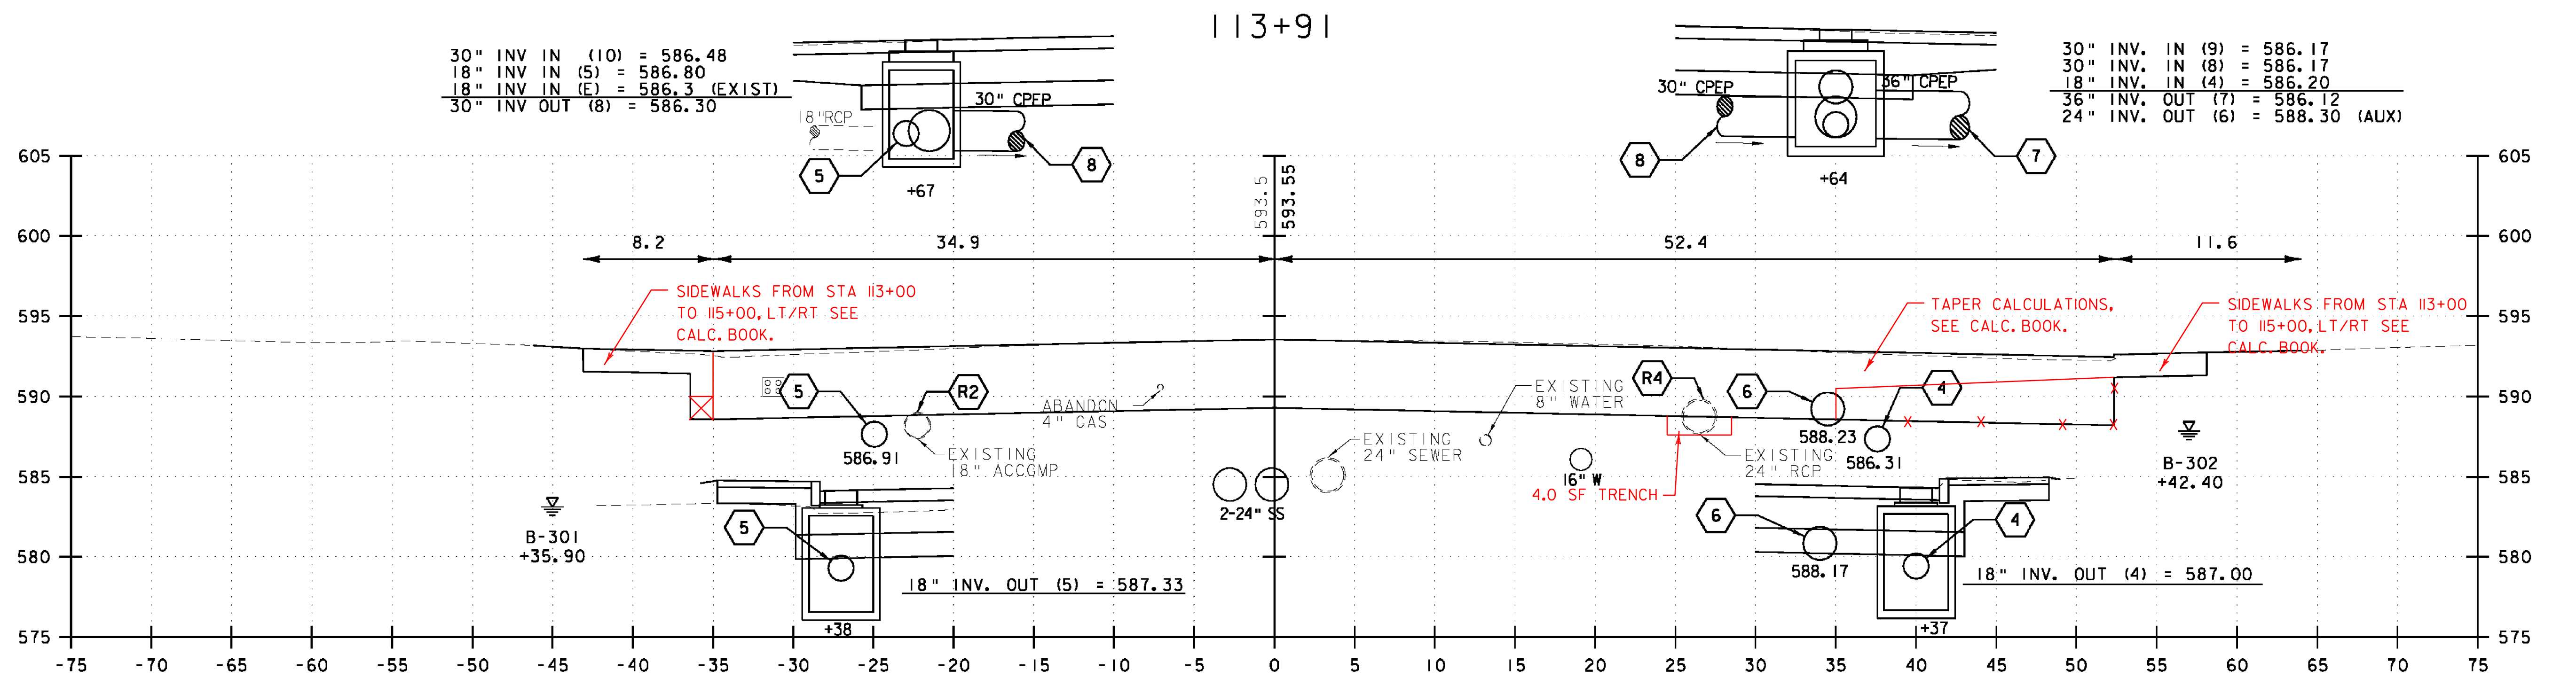

113+50 DENSE GRADED ~ 2.00' X 70' = 140 SF
SAND BORROW ~ 1.50' X 70' = 105 SF

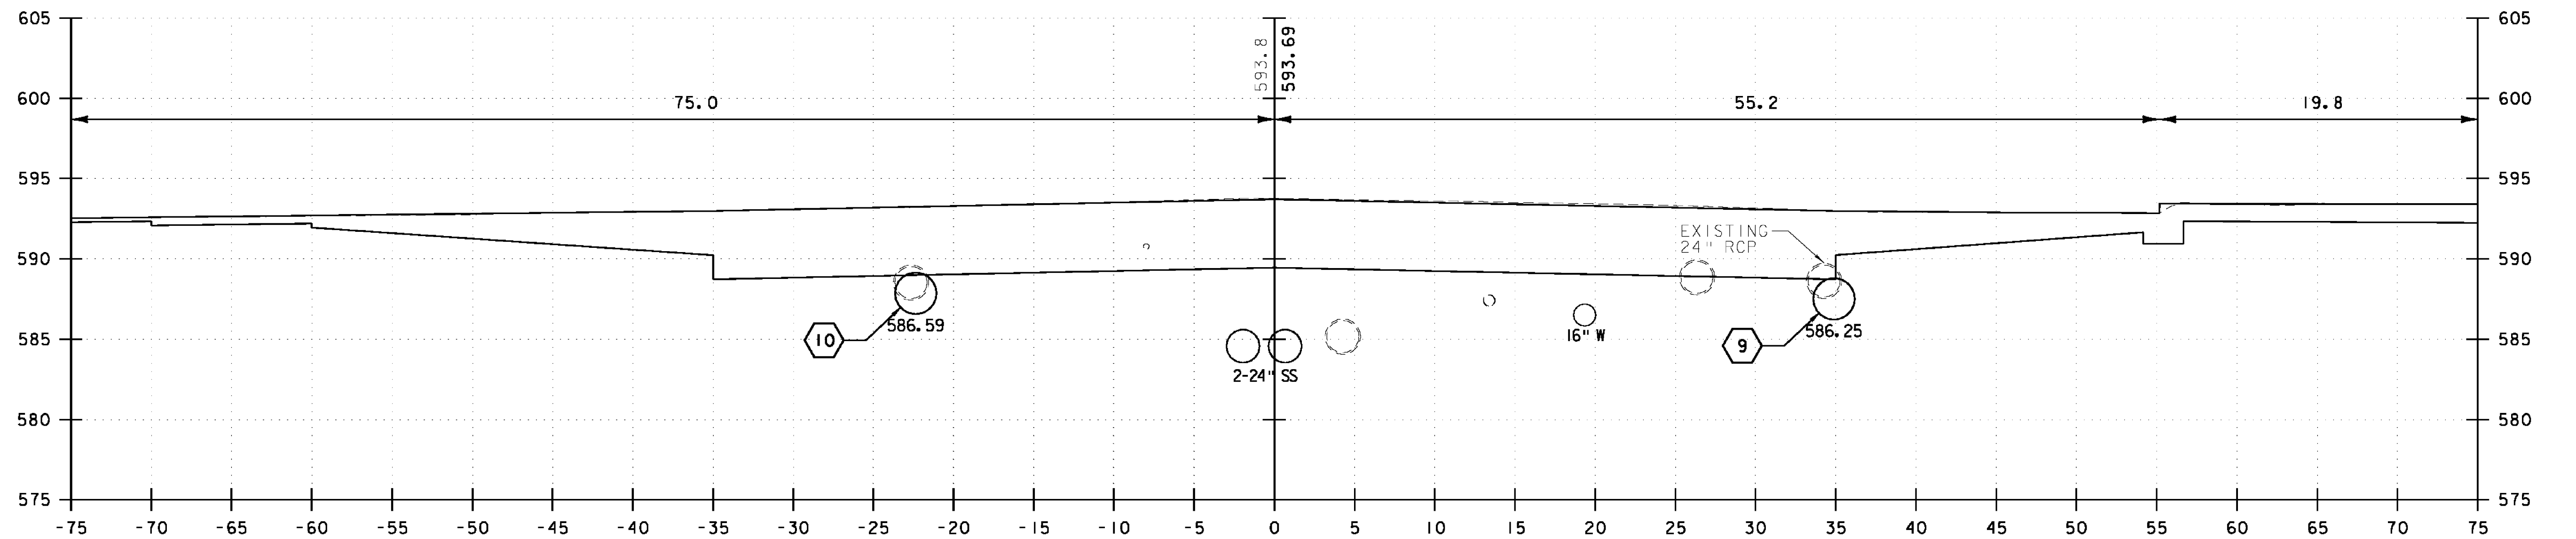

VHB Vanasse Hangen Brustlin, Inc.

NORTH MAIN STREET (US 302)

PROJECT NAME: BARRE CITY
PROJECT NUMBER: FECC F 026-1(34) C/2

FILE NAME: 85b010_xsl.Cut_C2
PROJECT LEADER: G. BAKOS
DESIGNED BY: DMP / MDS
CROSS SECTIONS

PLOT DATE: 3/9/2011
DRAWN BY: DMP / JAR
CHECKED BY:
SHEET 234 OF 339