



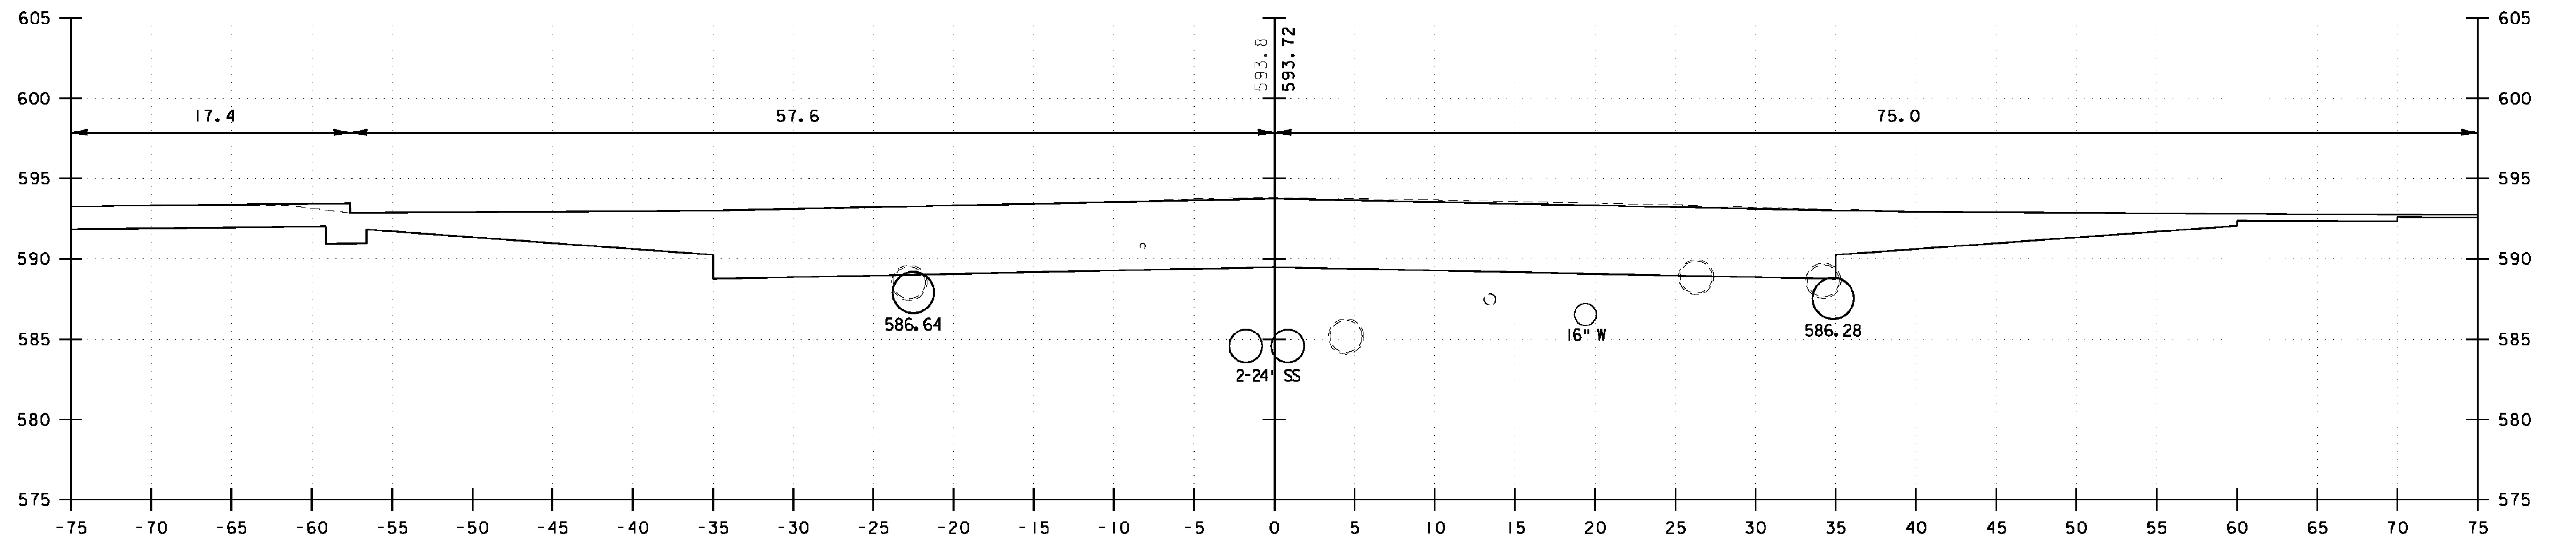

114+01

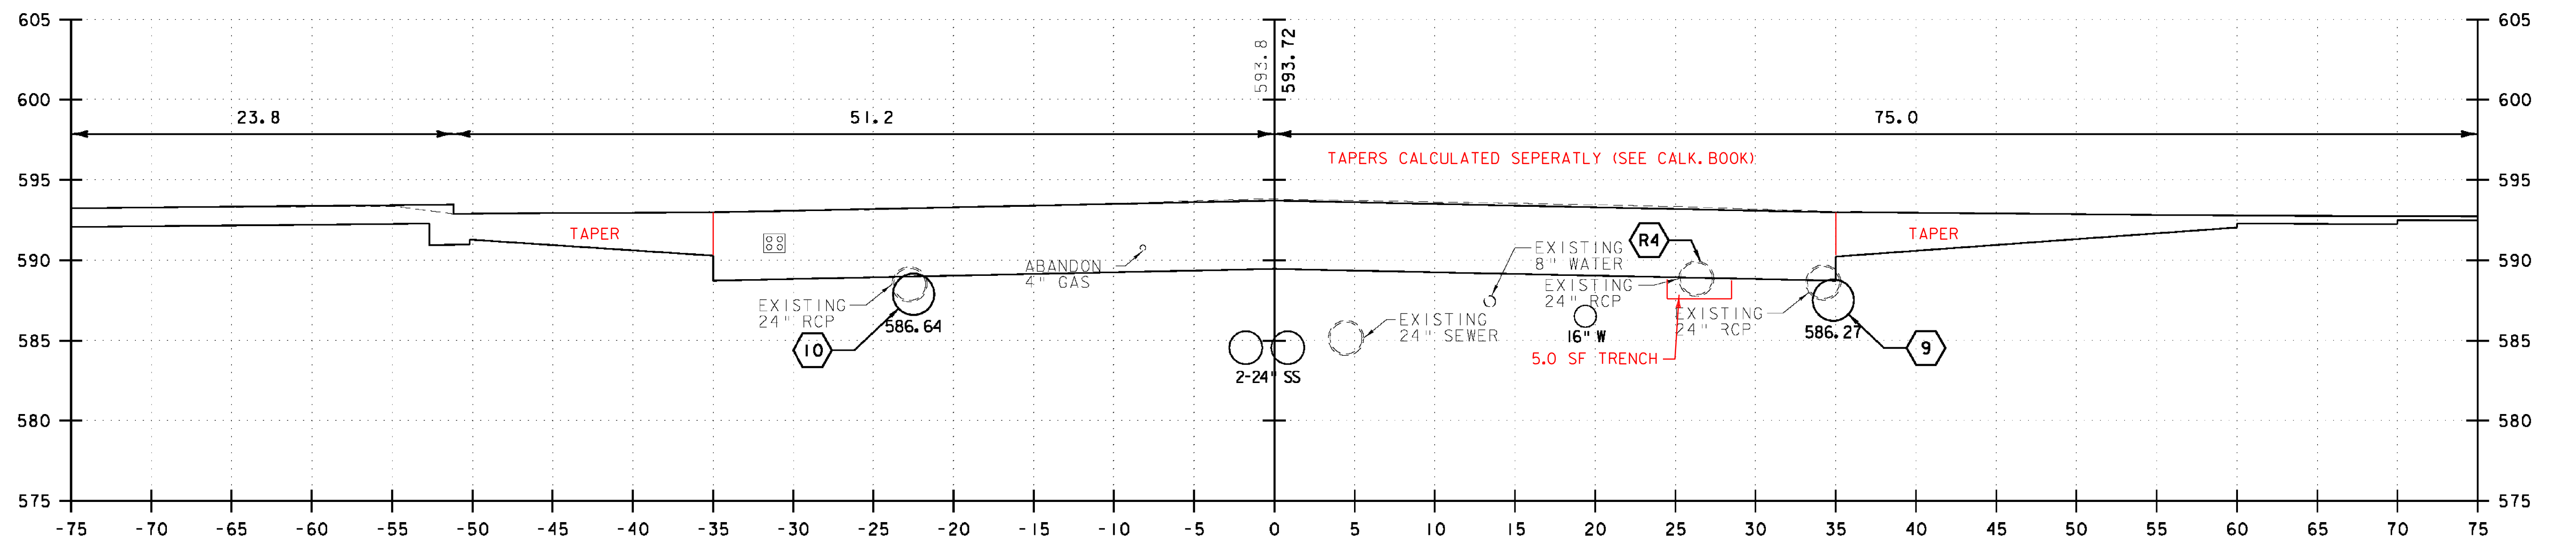

114+00

DENSE GRADED ~ 2.00' X 70' = 140 SF  
SAND BORROW ~ 1.50' X 70' = 105 SF



**VHB** Vanasse Hangen Brustlin, Inc.

NORTH MAIN STREET (US 302)

PROJECT NAME: BARRE CITY  
PROJECT NUMBER: FECC F 026-1(34) C/2

FILE NAME: 85b010.xml.Cut.C2  
PROJECT LEADER: G. BAKOS  
DESIGNED BY: DMP / MDS  
CROSS SECTIONS

PLOT DATE: 3/9/2011  
DRAWN BY: DMP / JAR  
CHECKED BY:  
SHEET 235 OF 339