





DENSE GRADED ~ 2.00' X 59' = 118 SF
SAND BORROW ~ 1.50' X 59' = 88.5 SF

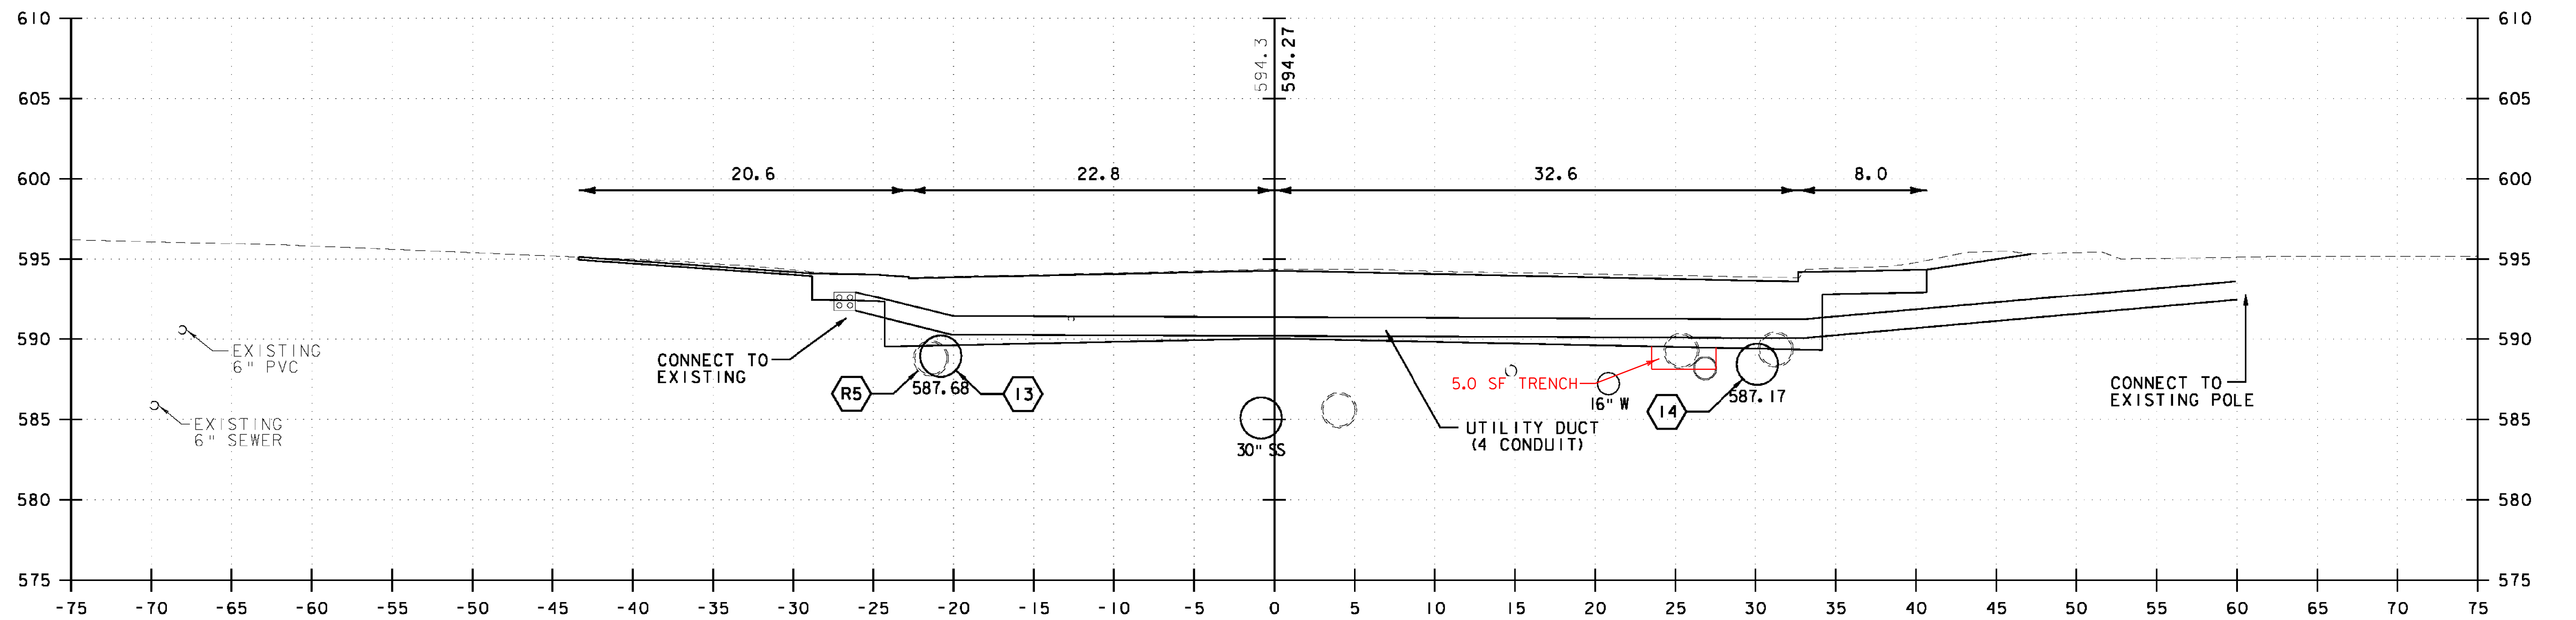

+84
DRIVE LT

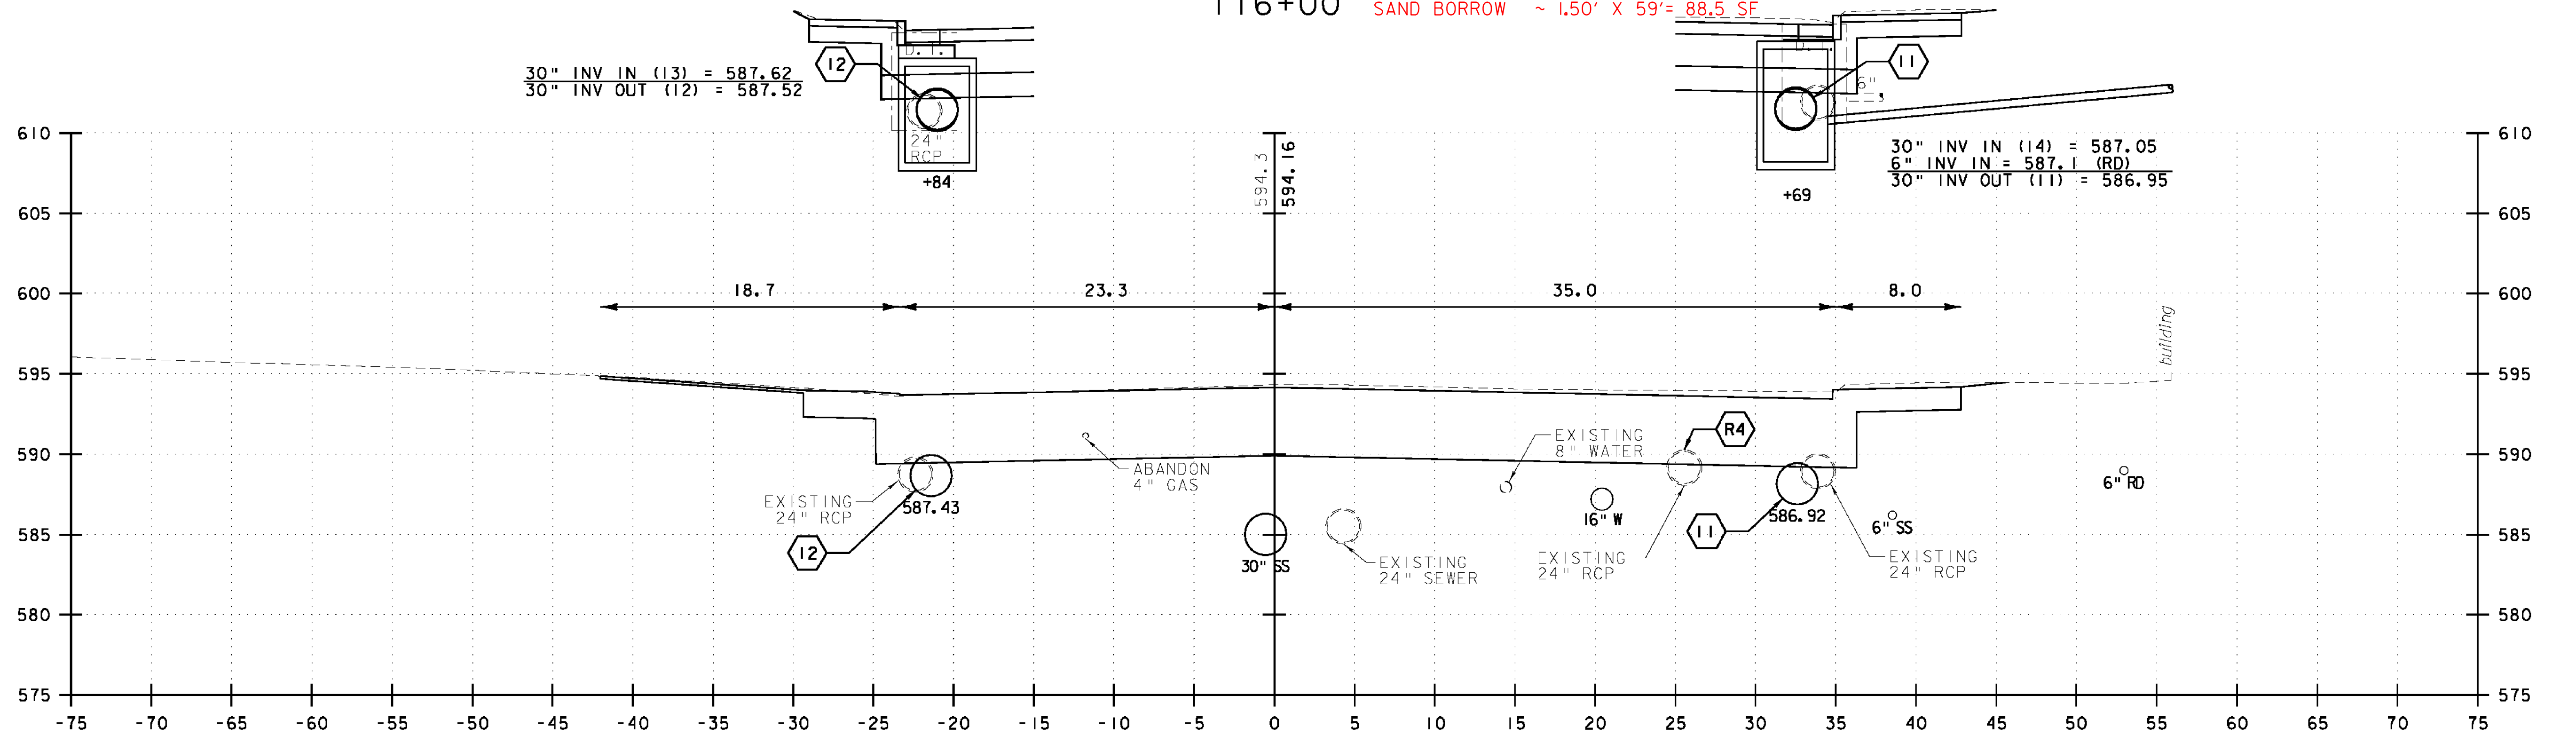

VHB Vanasse Hangen Brustlin, Inc.

NORTH MAIN STREET (US 302)

PROJECT NAME: BARRE CITY
PROJECT NUMBER: FECC F 026-1(34) C/2

FILE NAME: 85b010.xml.Cut.C2
PROJECT LEADER: G. BAKOS
DESIGNED BY: DMP / MDS
CROSS SECTIONS

PLOT DATE: 3/9/2011
DRAWN BY: DMP / JAR
CHECKED BY:
SHEET 238 OF 339