



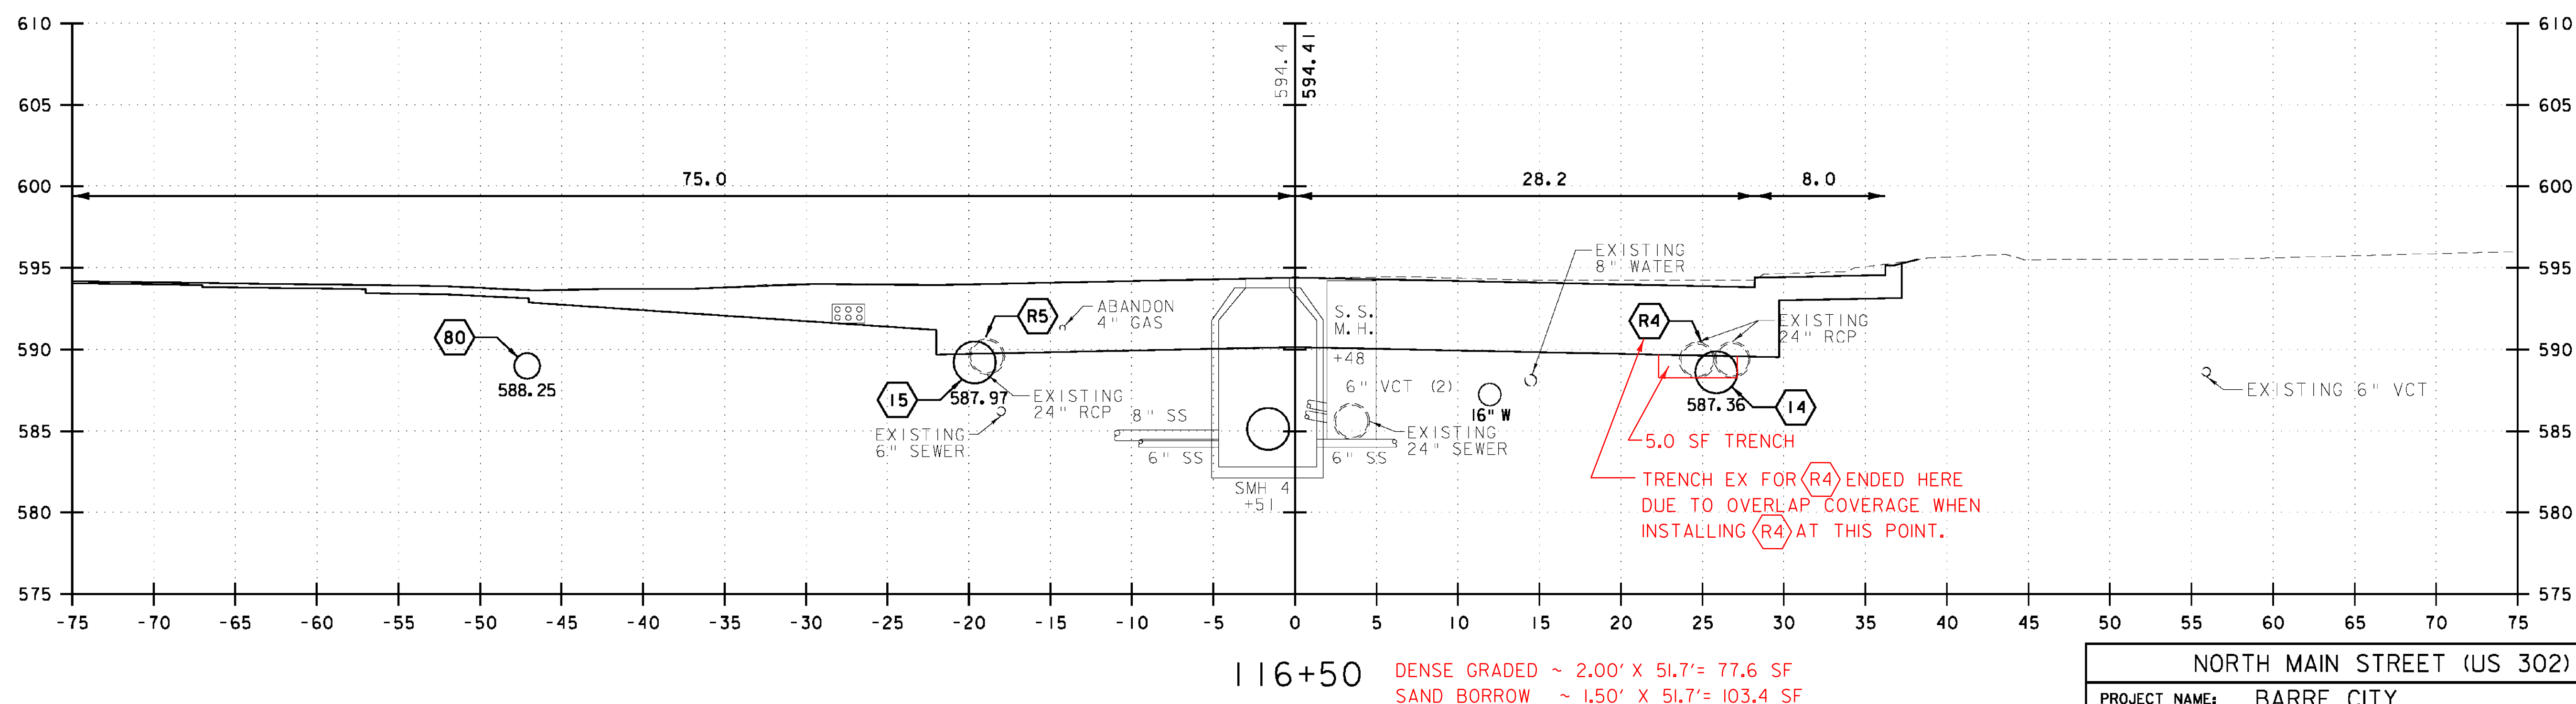

DENSE GRADED ~ 2.00' X 51.7' = 77.6 SF
SAND BORROW ~ 1.50' X 51.7' = 103.4 SF

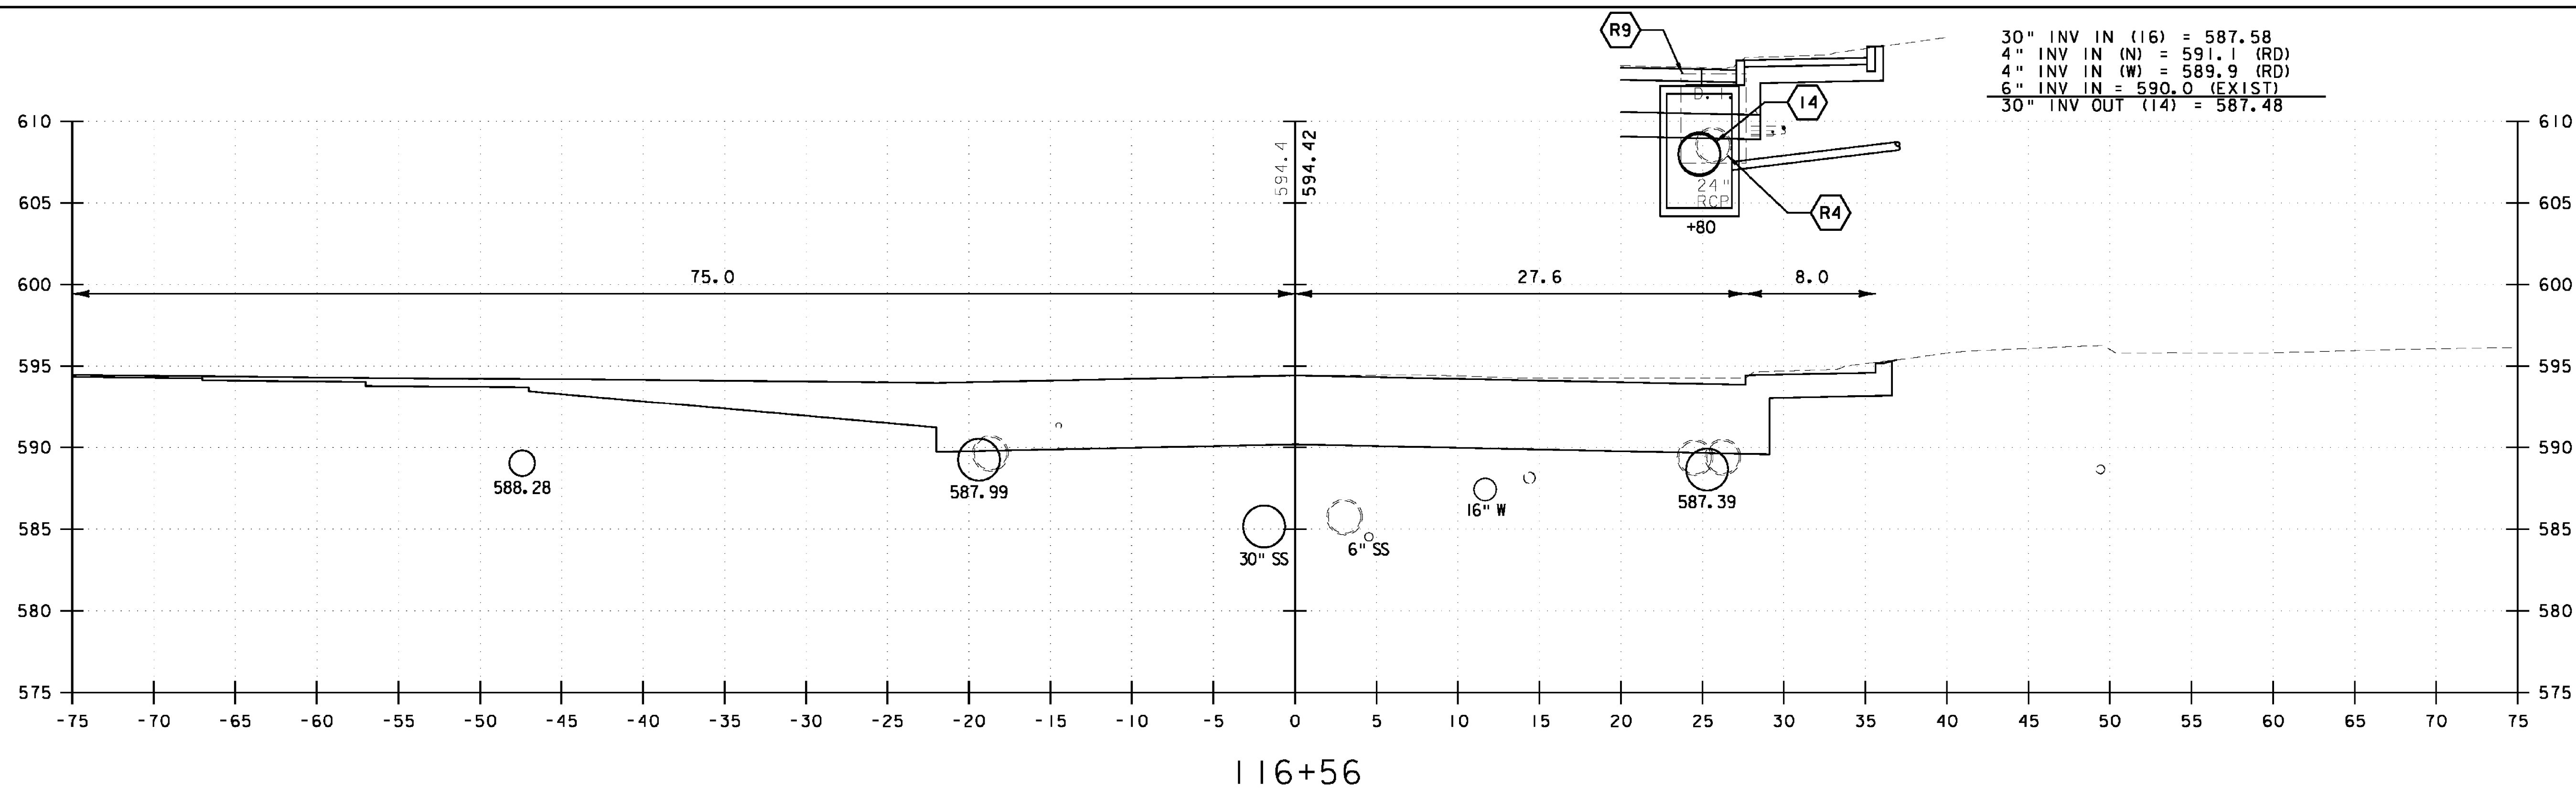

VHB Vanasse Hangen Brustlin, Inc.

NORTH MAIN STREET (US 302)			
PROJECT NAME:	BARRE CITY		
PROJECT NUMBER:	FEGC F 026-(134) C/2		
FILE NAME:	85b010_xsl.Cut_C2	PLOT DATE:	3/9/2011
PROJECT LEADER:	G. BAKOS	DRAWN BY:	DMP / JAR
DESIGNED BY:	DMP / MDS	CHECKED BY:	
CROSS SECTIONS		SHEET	240 OF 339