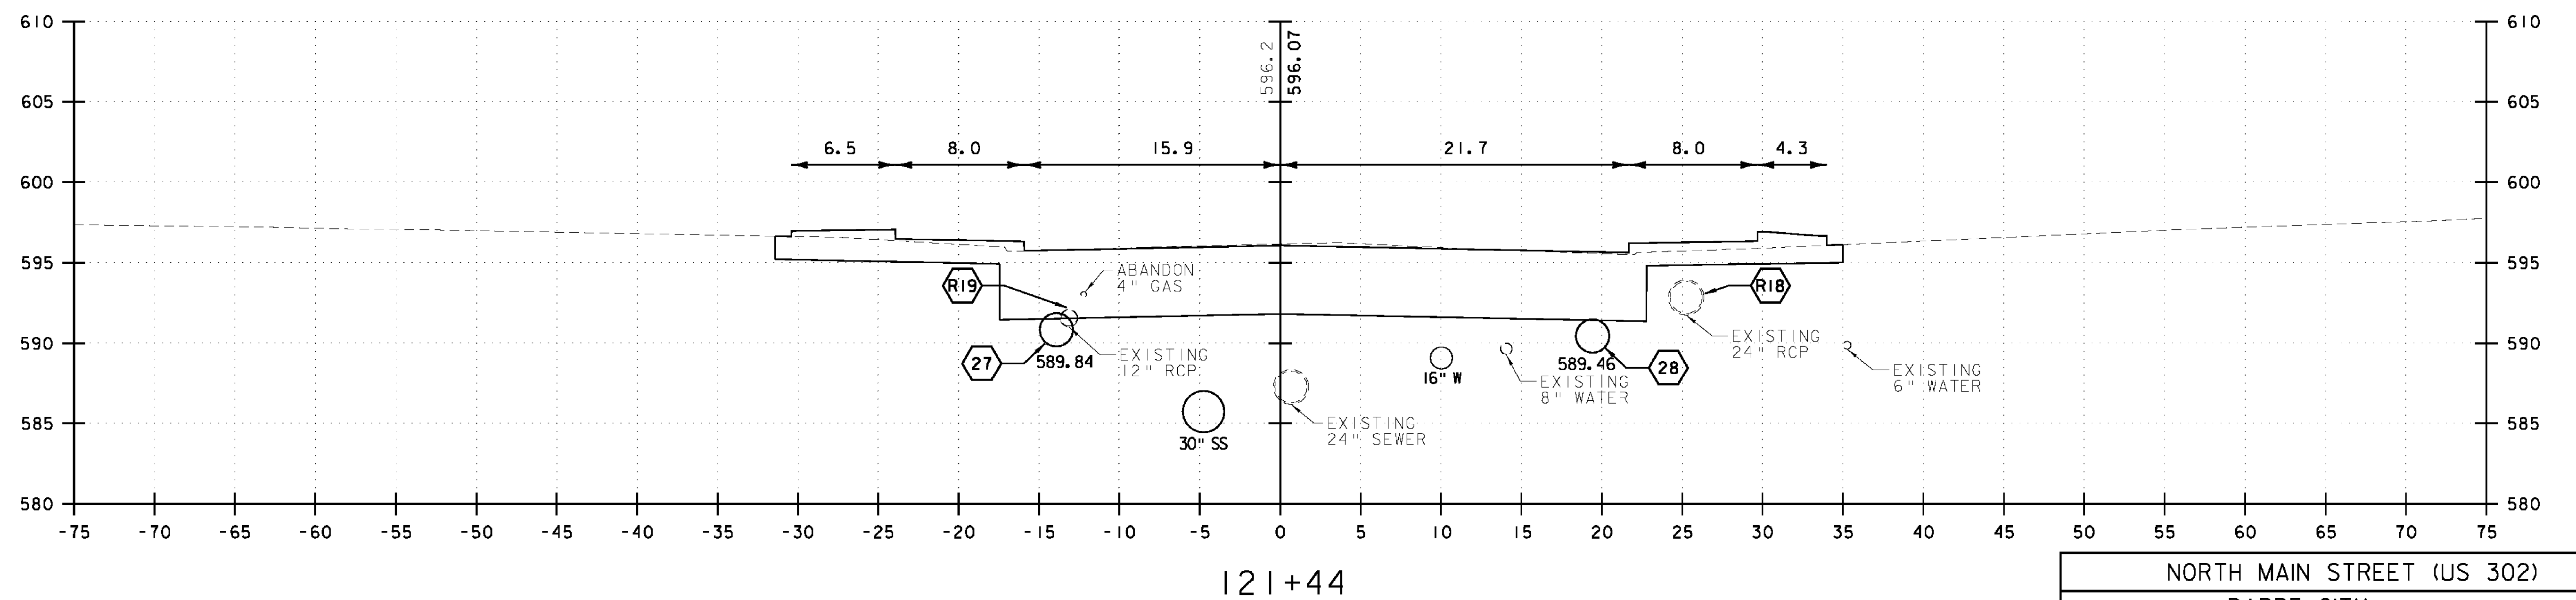


NORTH MAIN STREET (US 302)	
PROJECT NAME:	BARRE CITY
PROJECT NUMBER:	FEGC F 026-I(34) C/2
FILE NAME:	85b0i0_xsl_Cut_C2
PROJECT LEADER:	G. BAKOS
DESIGNED BY:	DMP / MDS
CROSS SECTIONS	
	PLOT DATE: 3/9/2011
	DRAWN BY: DMP / JAR
	CHECKED BY:
	SHEET 248 OF 339