



123+50 SAND BORROW ~ 1.50' X 47.0' = 70.5 SF  
 SUBBASE ~ 2.00' X 47.0' = 94.0 SF

6" INV IN (RD) = 590.7  
 18" INV OUT (36) = 590.67

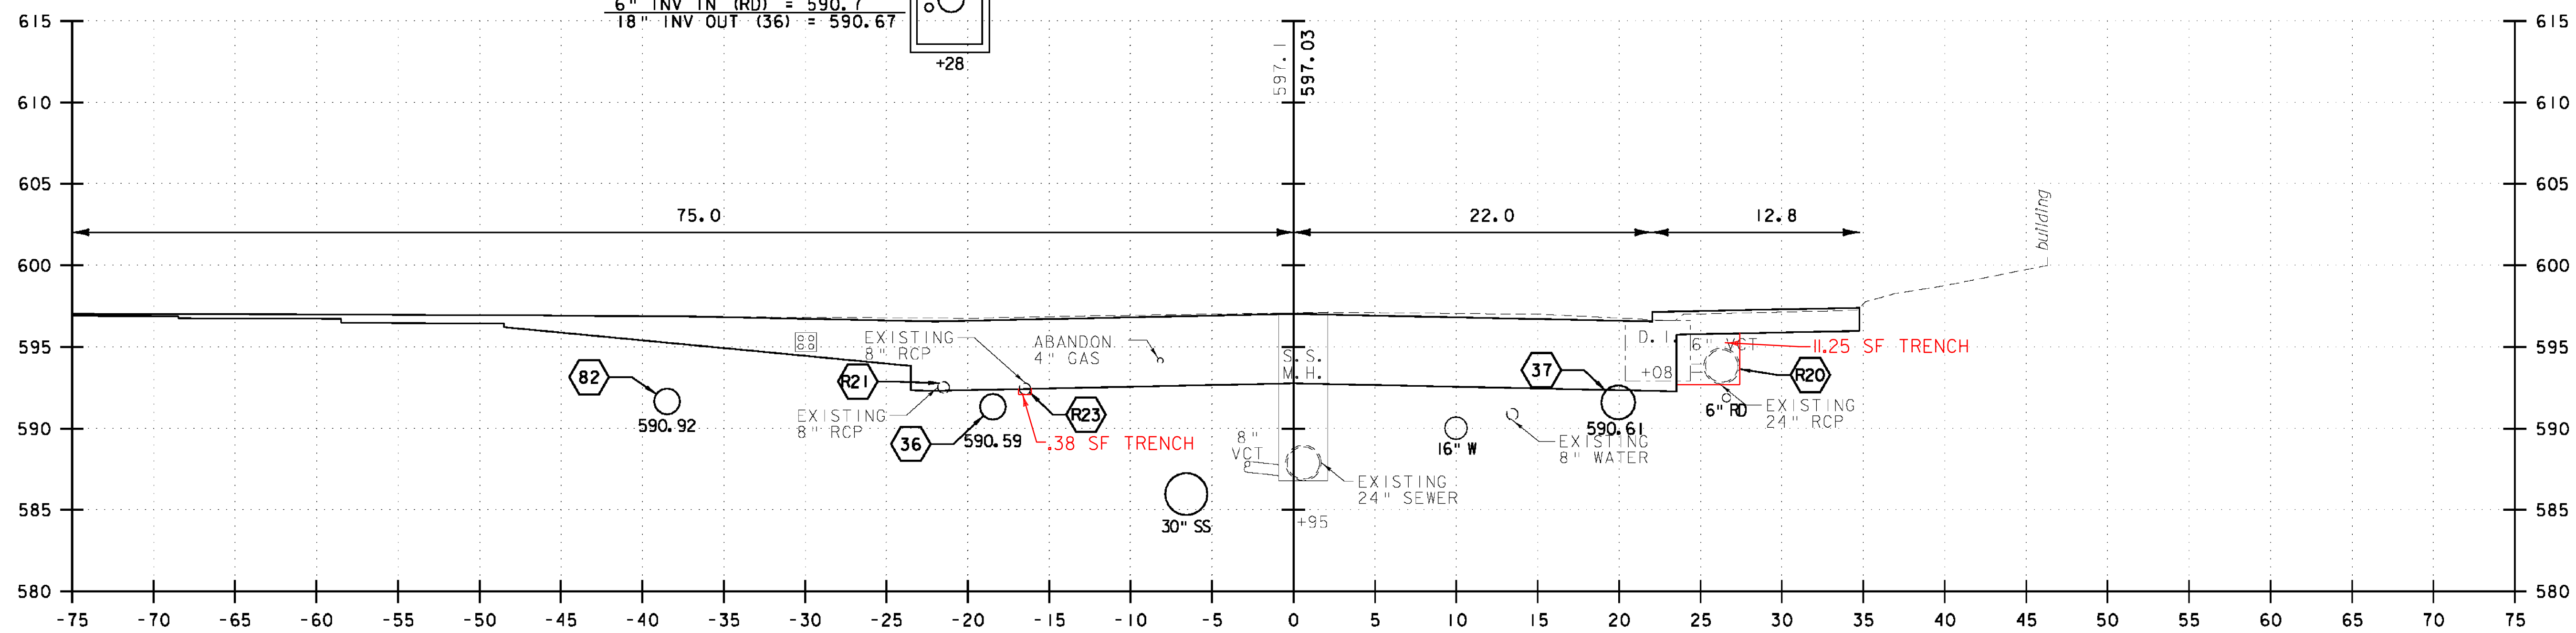

123+00 SAND BORROW ~ 1.50' X 47.0' = 70.5 SF  
 SUBBASE ~ 2.00' X 47.0' = 94.0 SF

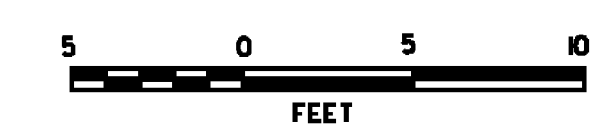

**VHB** Vanasse Hangen Brustlin, Inc.

NORTH MAIN STREET (US 302)	
PROJECT NAME:	BARRE CITY
PROJECT NUMBER:	FEGC F 026-(134) C/2
FILE NAME:	85b010_xsl.Cu+1_C2
PROJECT LEADER:	G. BAKOS
DESIGNED BY:	DMP / MDS
CROSS SECTIONS	
PLOT DATE:	3/9/2011
DRAWN BY:	DMP / JAR
CHECKED BY:	
SHEET	251 OF 339