


125+50

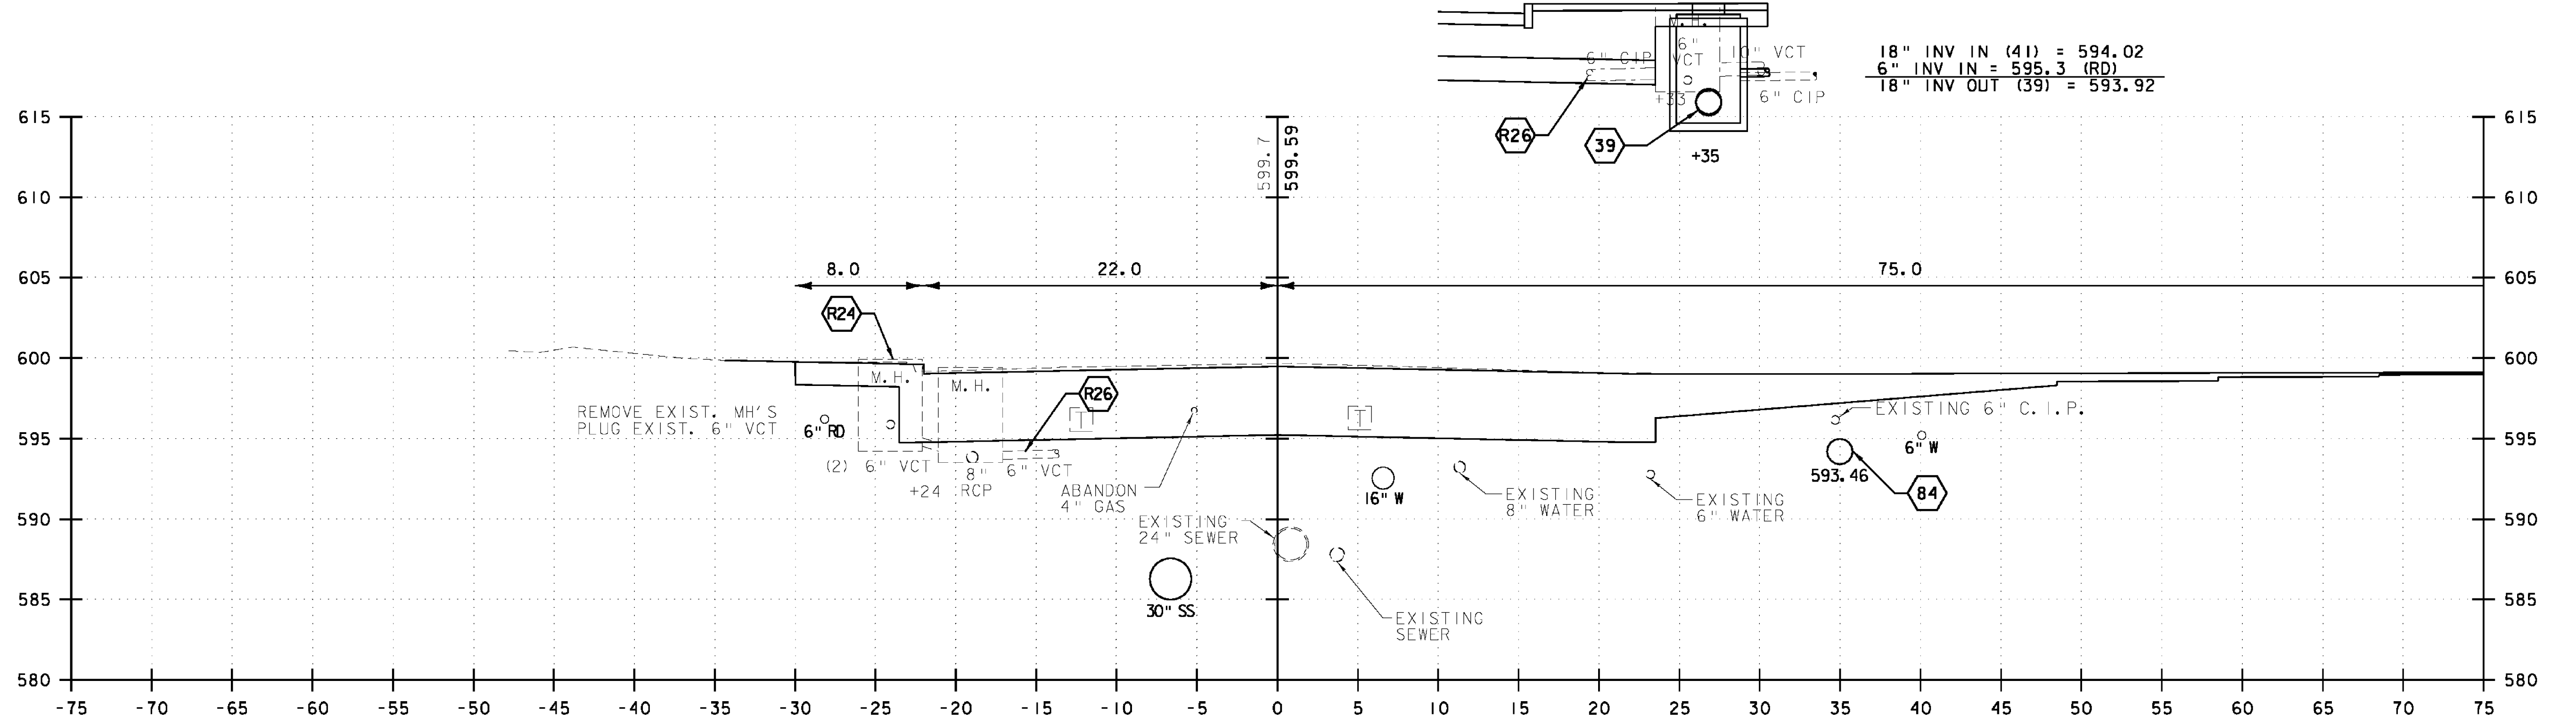

125+08

NORTH MAIN STREET (US 302)

PROJECT NAME:	BARRE CITY	PLOT DATE:	3/9/2011
PROJECT NUMBER:	FEGC F 026-(134) C/2	DRAWN BY:	DMP / JAR
FILE NAME:	85b010_xsl.Cut_C2	DESIGNED BY:	DMP / MDS
PROJECT LEADER:	G. BAKOS	CHECKED BY:	
CROSS SECTIONS			SHEET 254 OF 339

5 0 5 10
 FEET

VHB Vanasse Hangen Brustlin, Inc.