




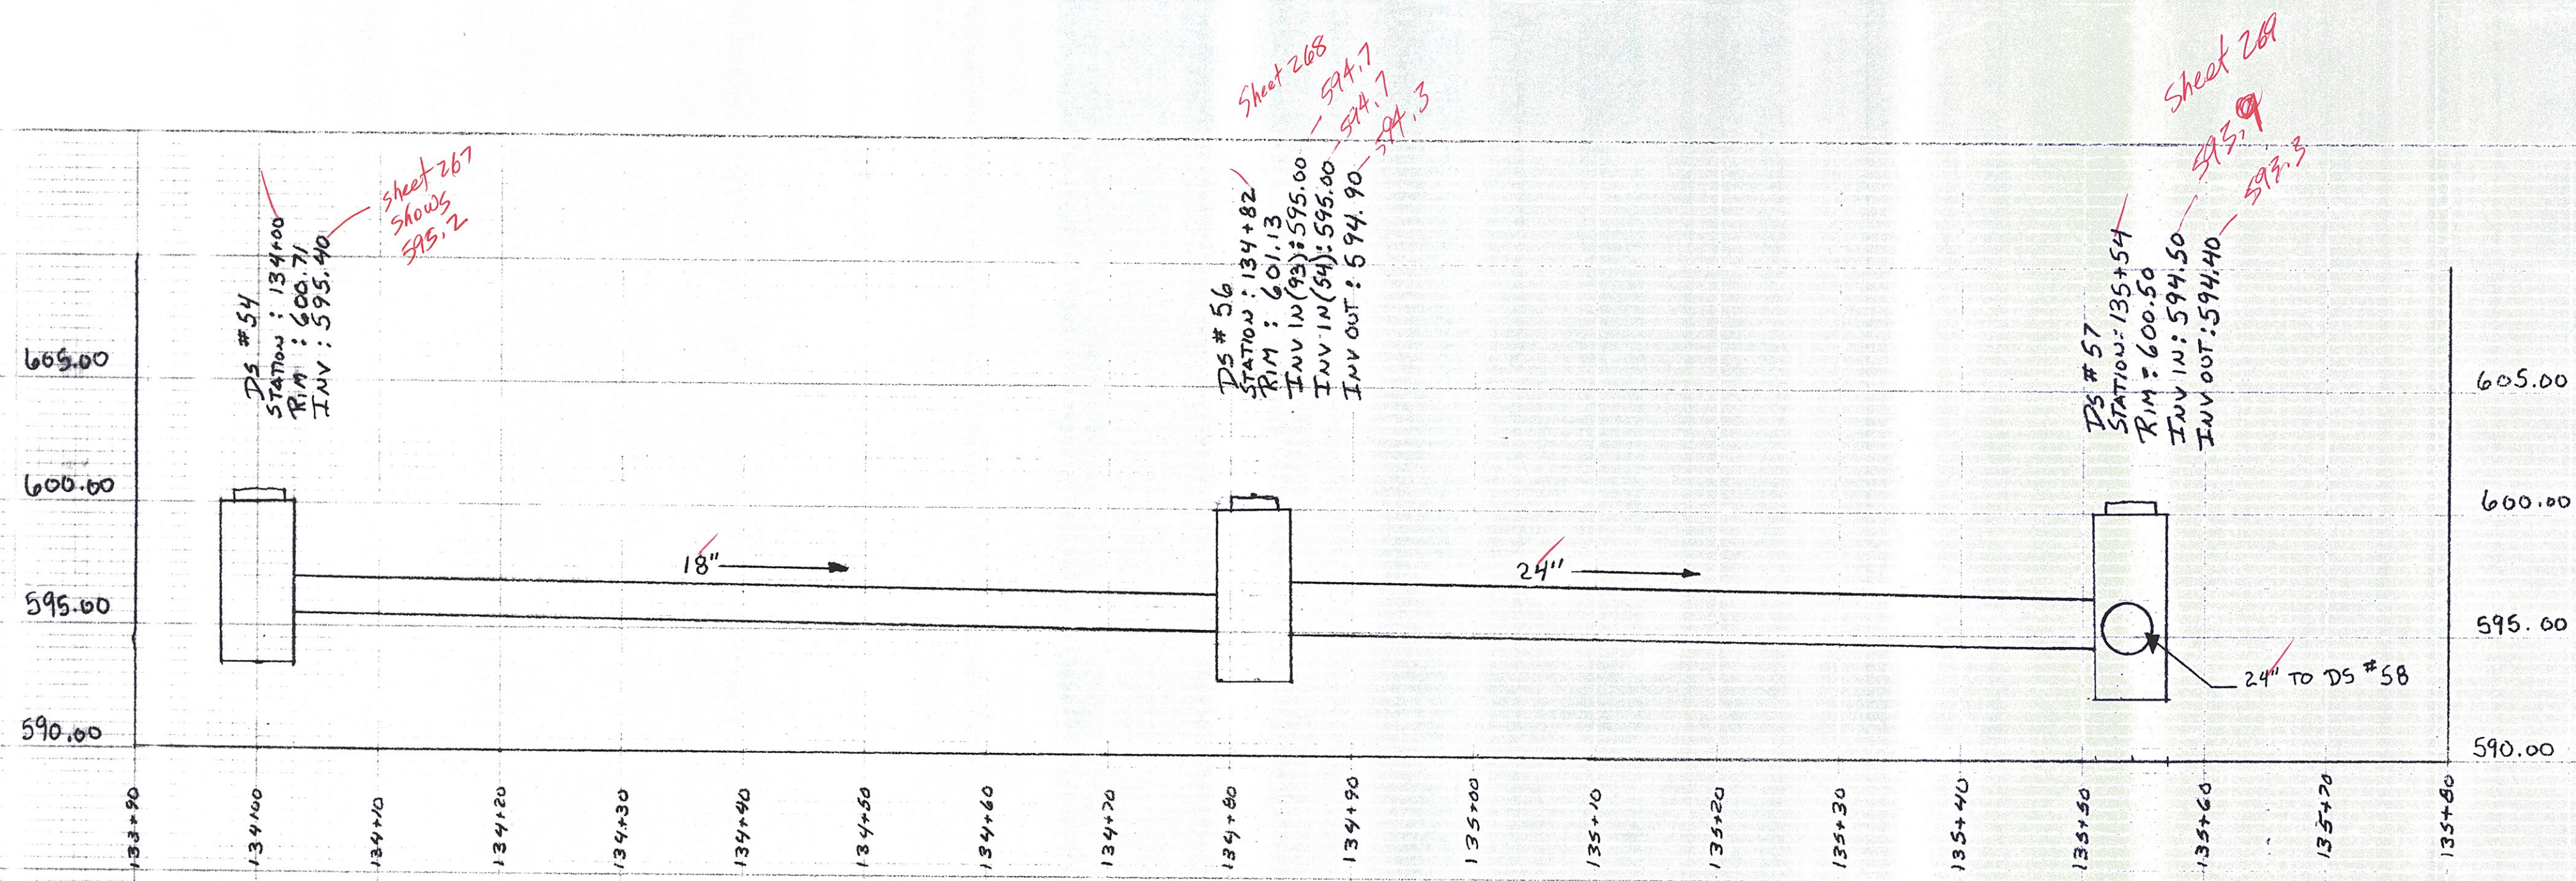

DRAINAGE RUN (54) TO (57)

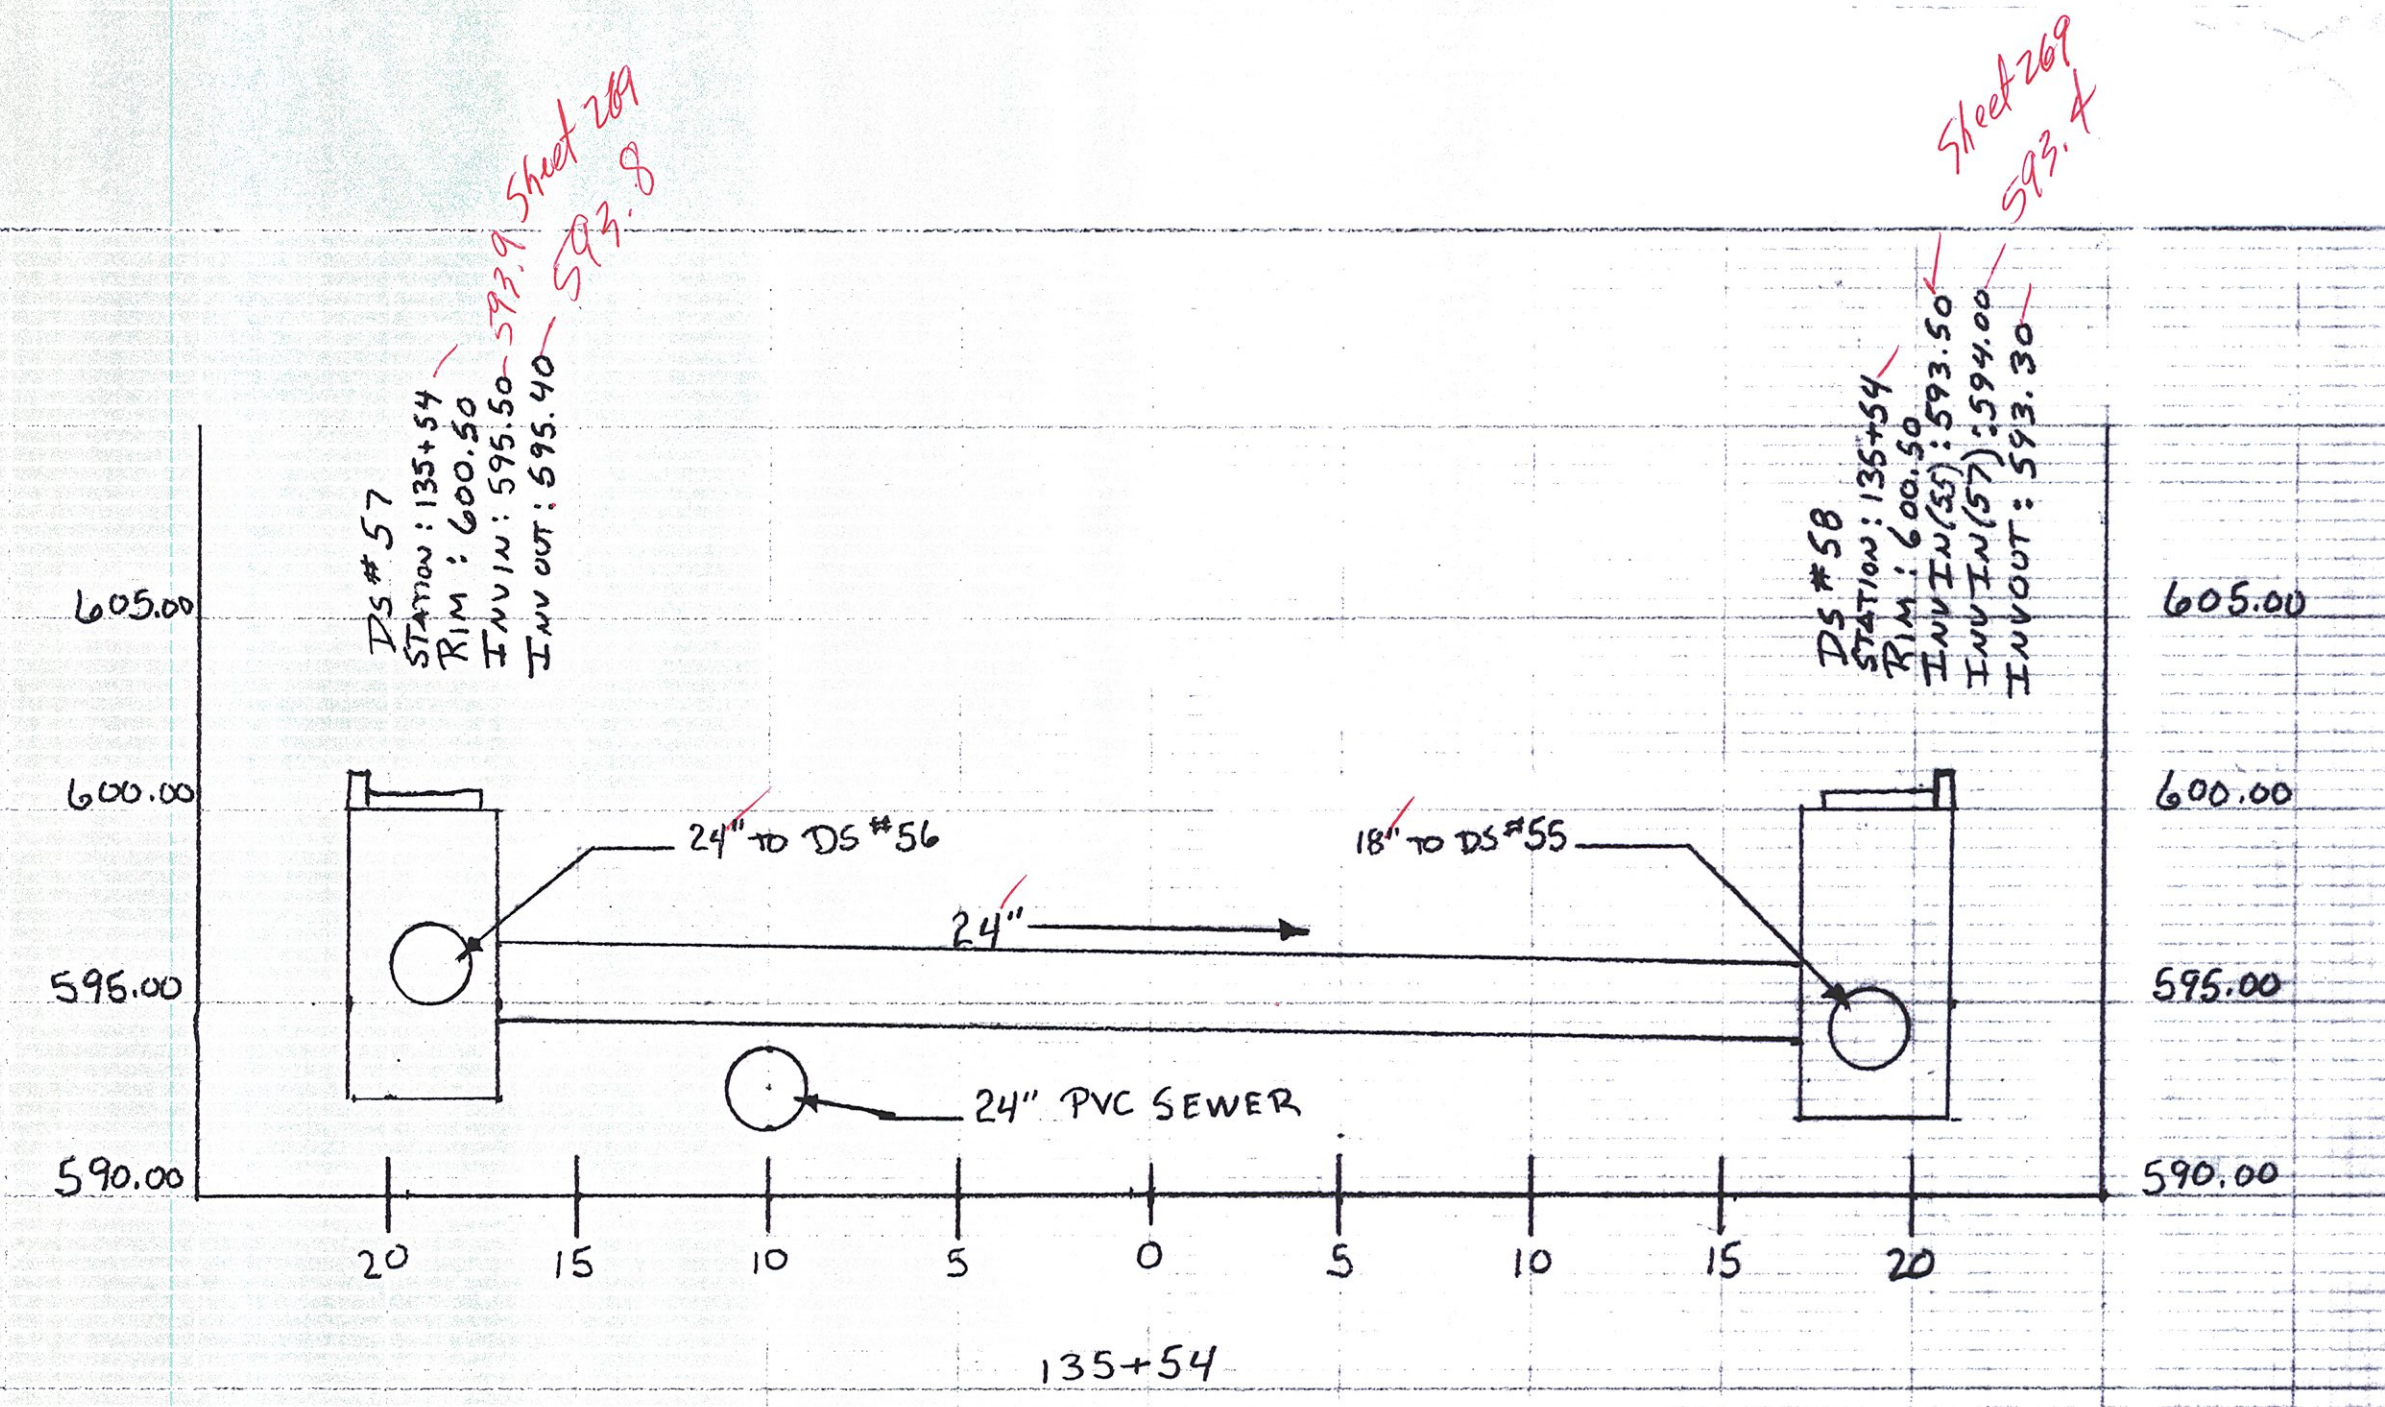

DRAINAGE X-ING (57) TO (58)

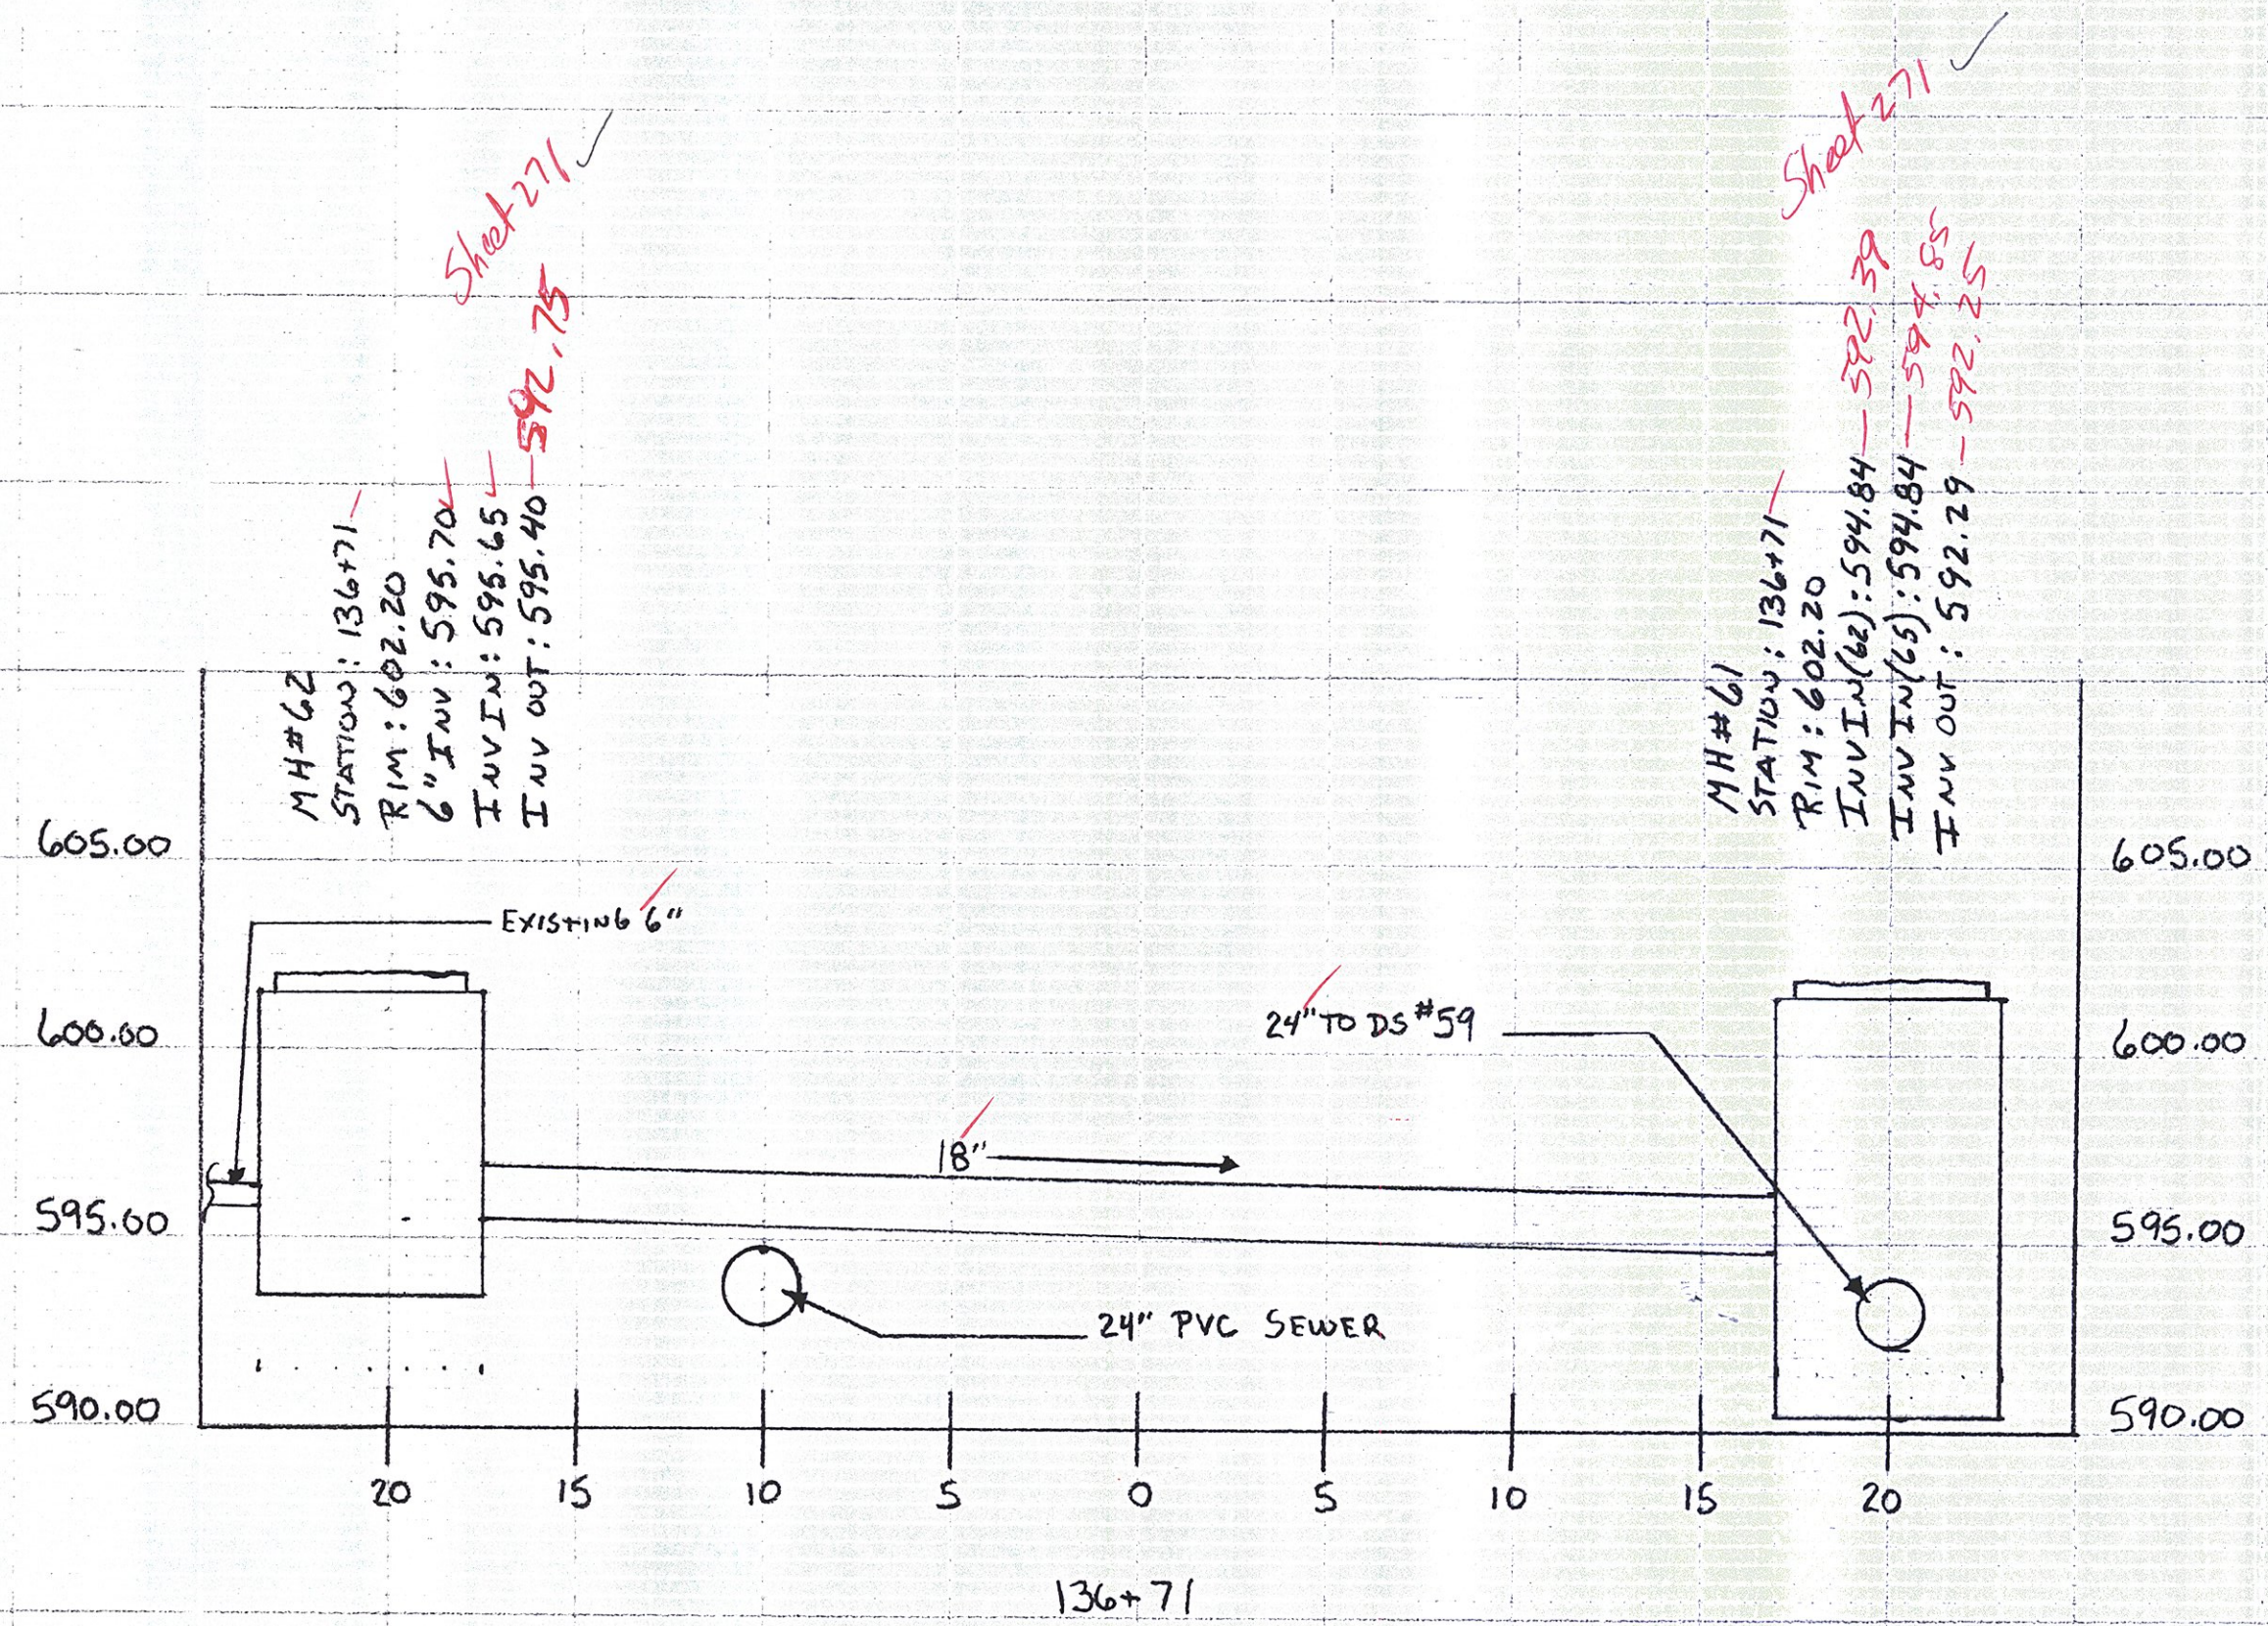

PROJECT NAME: BARRE CITY PROJECT NUMBER: FEGC F 026-1(34) C/2 FILE NAME: SAN PROFILES MANAGER: J. LUCK DRAWN BY: C. KEMPNEY		NOTES / REVISIONS	
		ISSUED: 2/7/2012	
PROPOSED REDESIGN STORM SEWER PROFILES			