




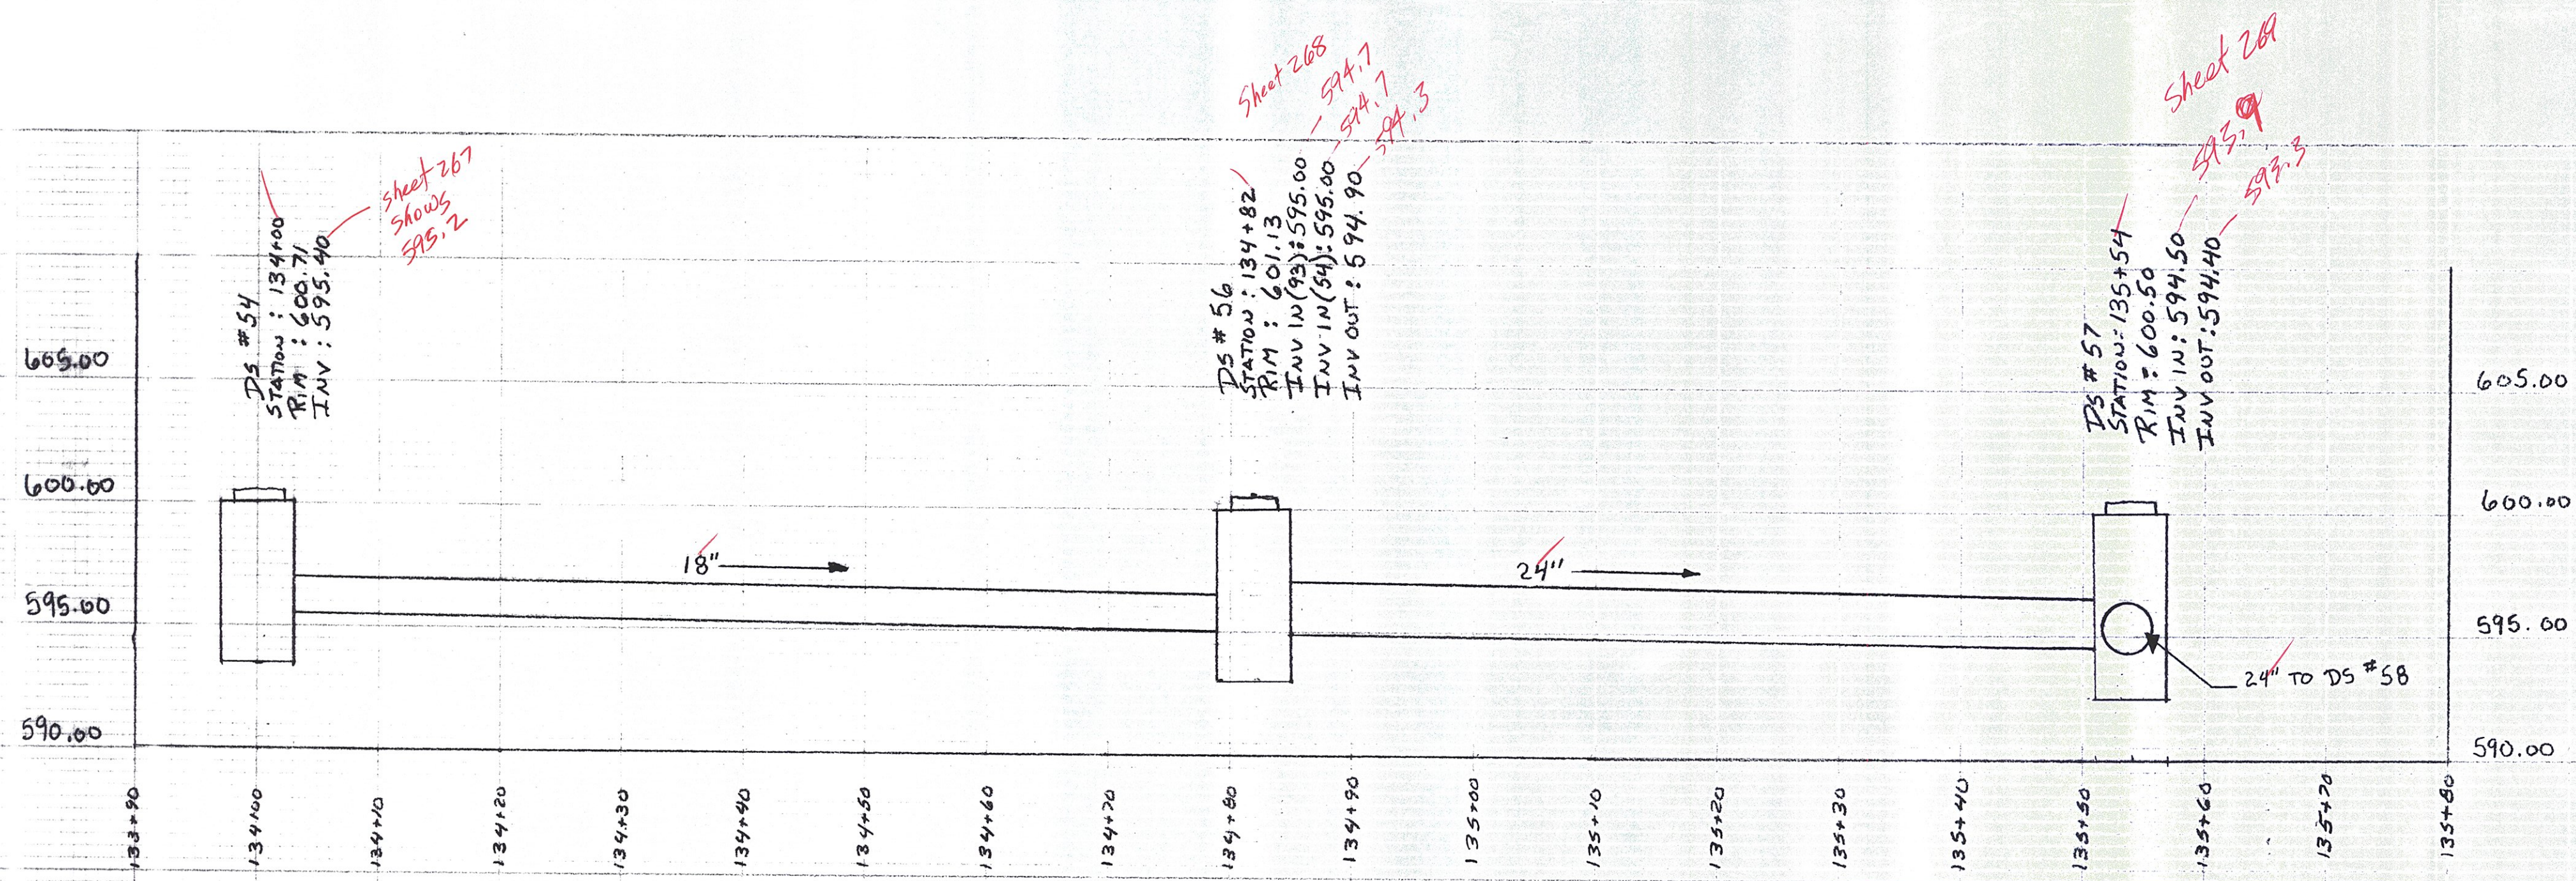

DRAINAGE RUN (54) TO (57)

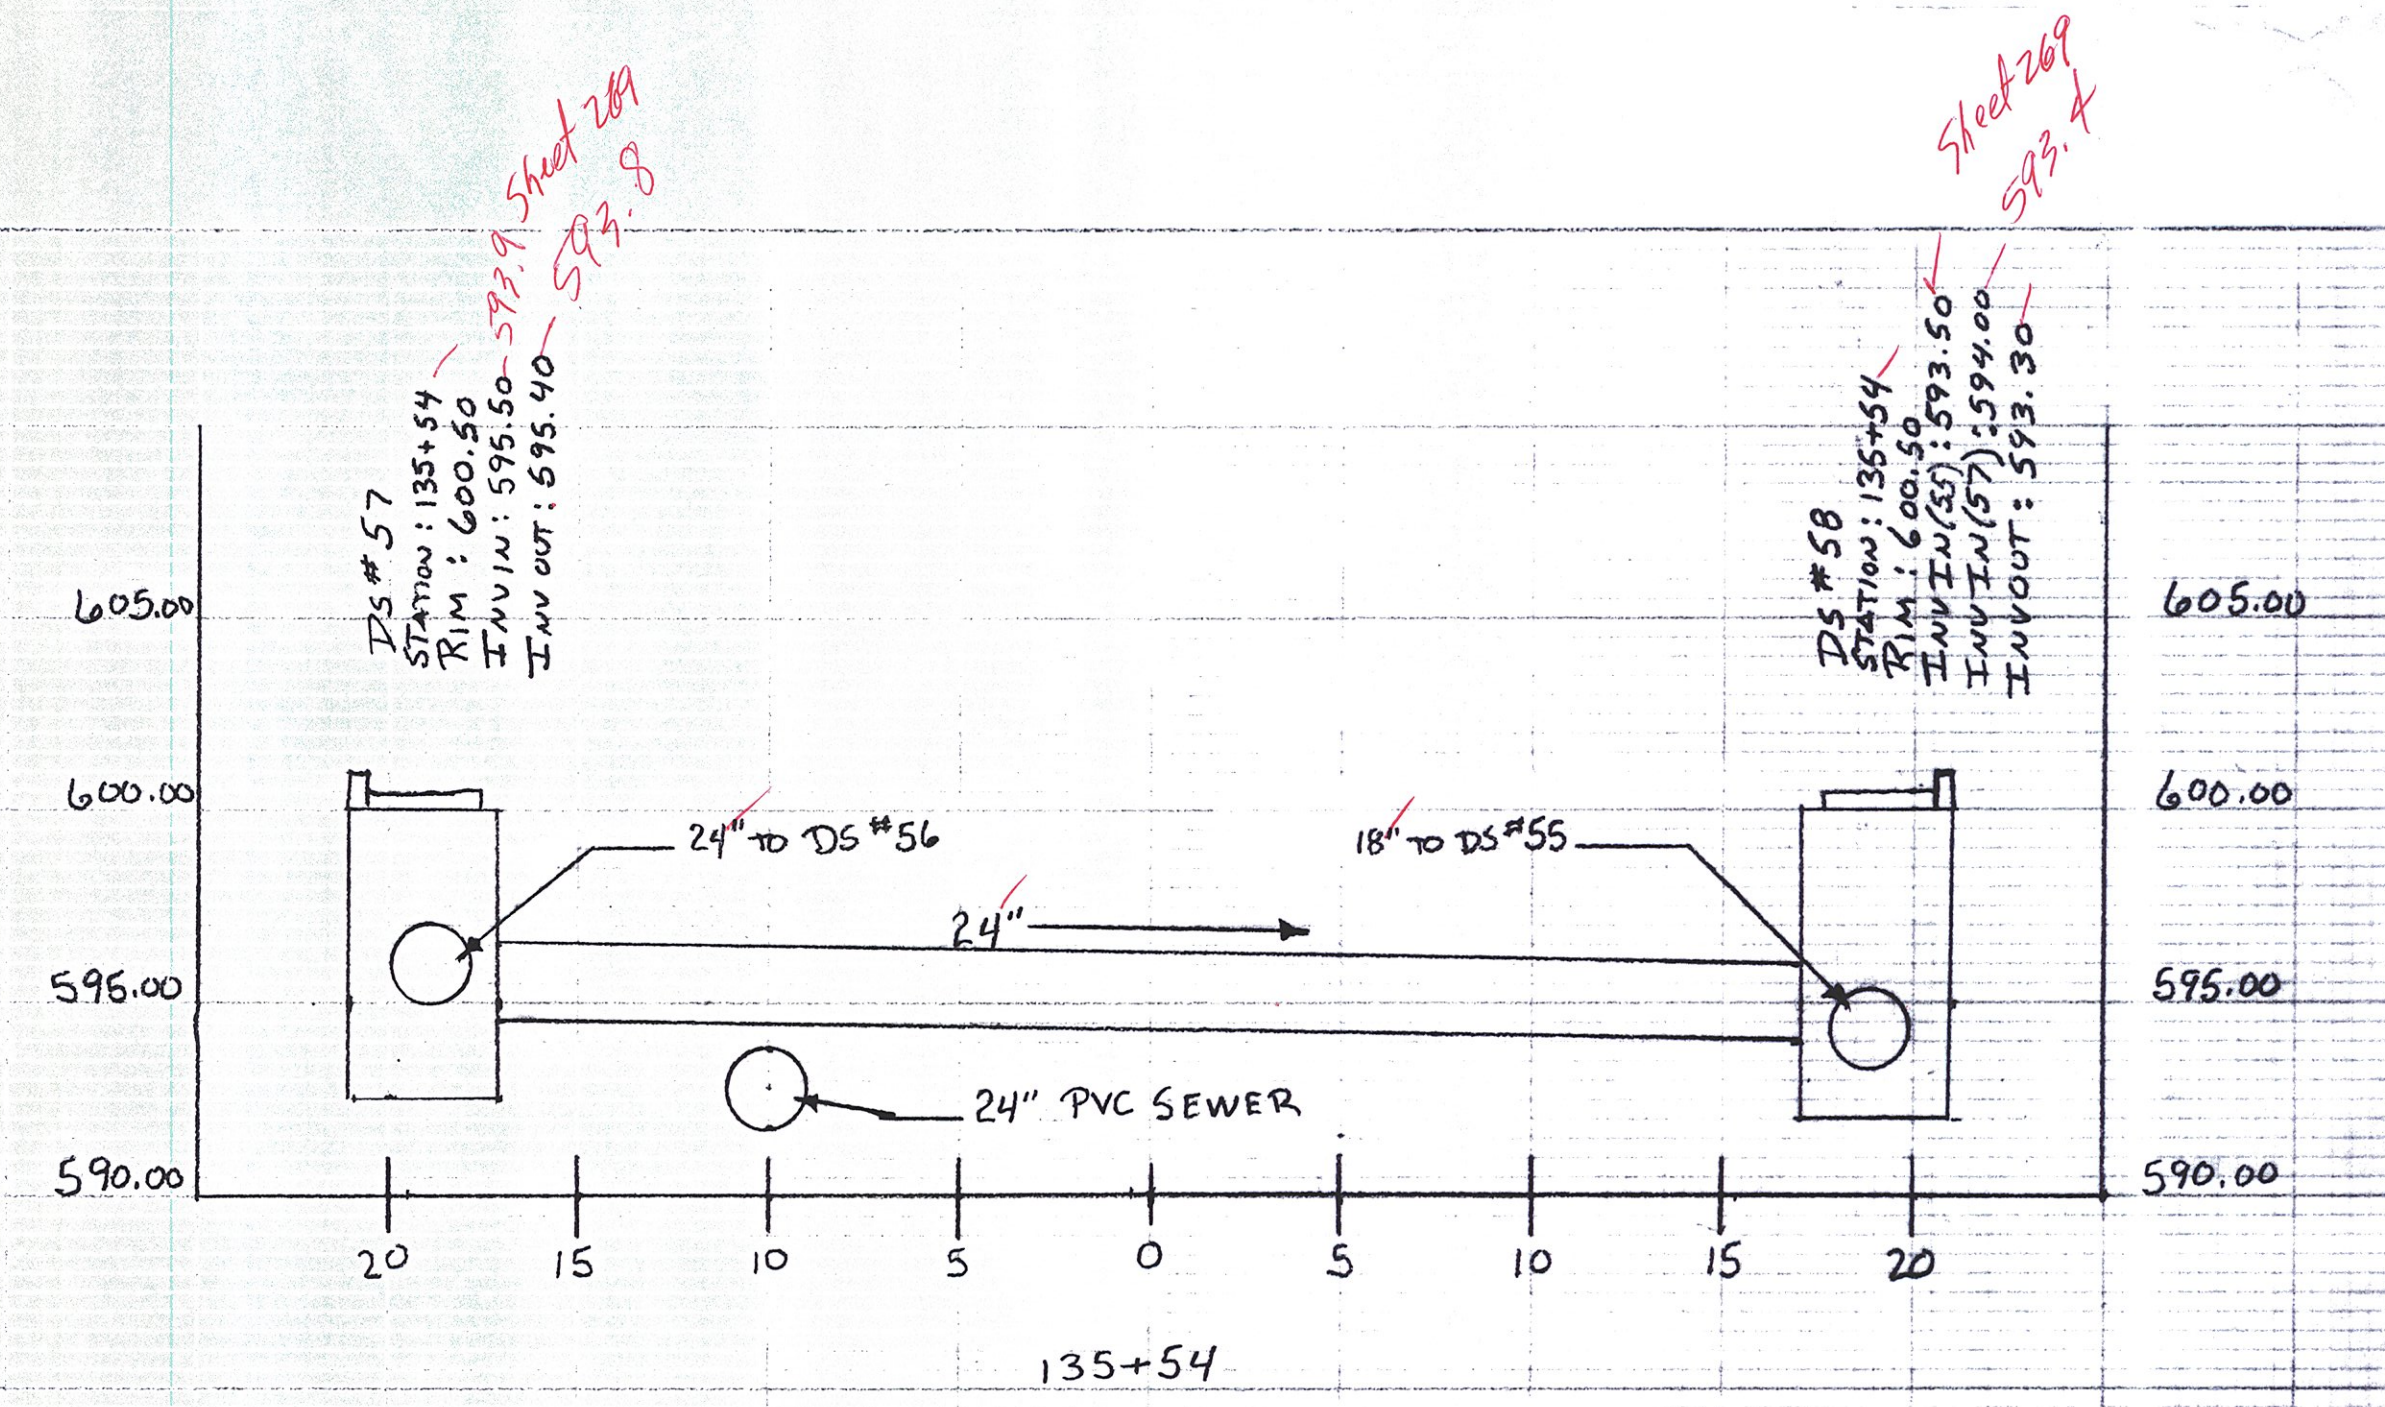

DRAINAGE X-ING (57) TO (58)

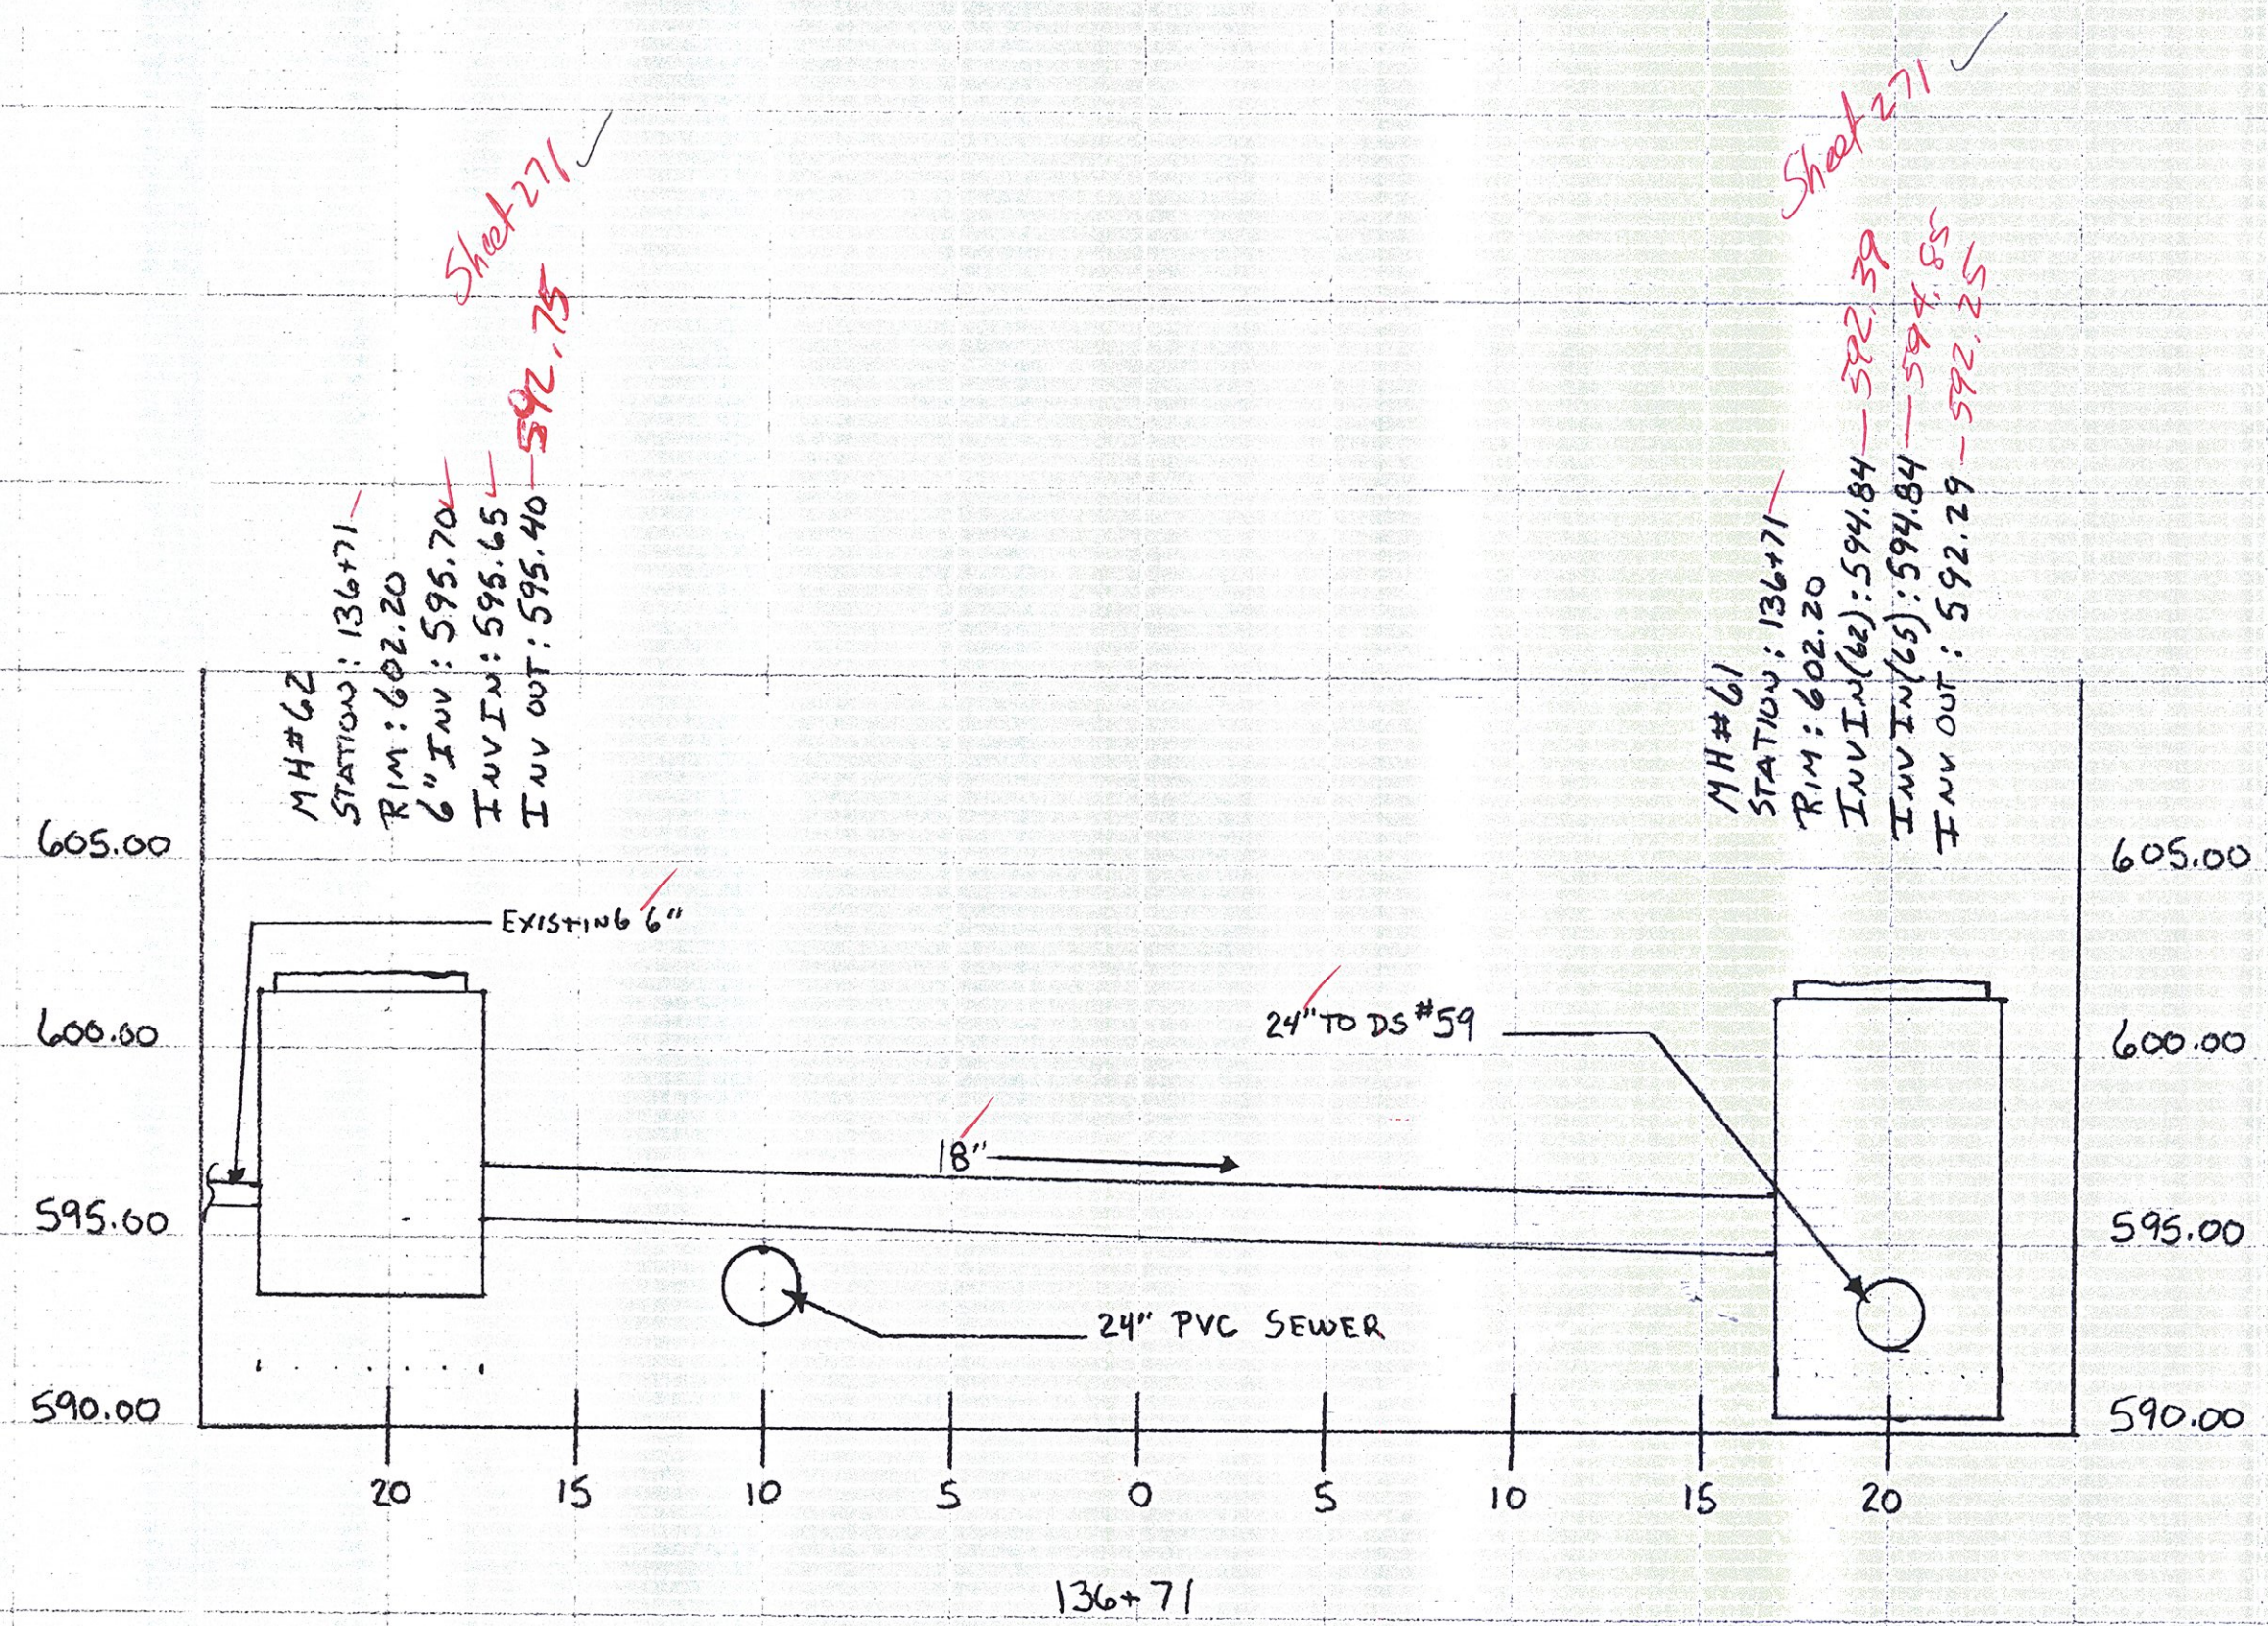

PROJECT NAME: BARRE CITY

PROJECT NUMBER: FECC F 026-1(34) C/2

FILE NAME: SAN PROFILES

MANAGER: J. LUCK

DRAWN BY: C. KEMPNEY

| NOTES / REVISIONS |          |
|-------------------|----------|
| ISSUED:           | 2/7/2012 |
|                   |          |
|                   |          |
**PROPOSED REDESIGN STORM SEWER PROFILES**