
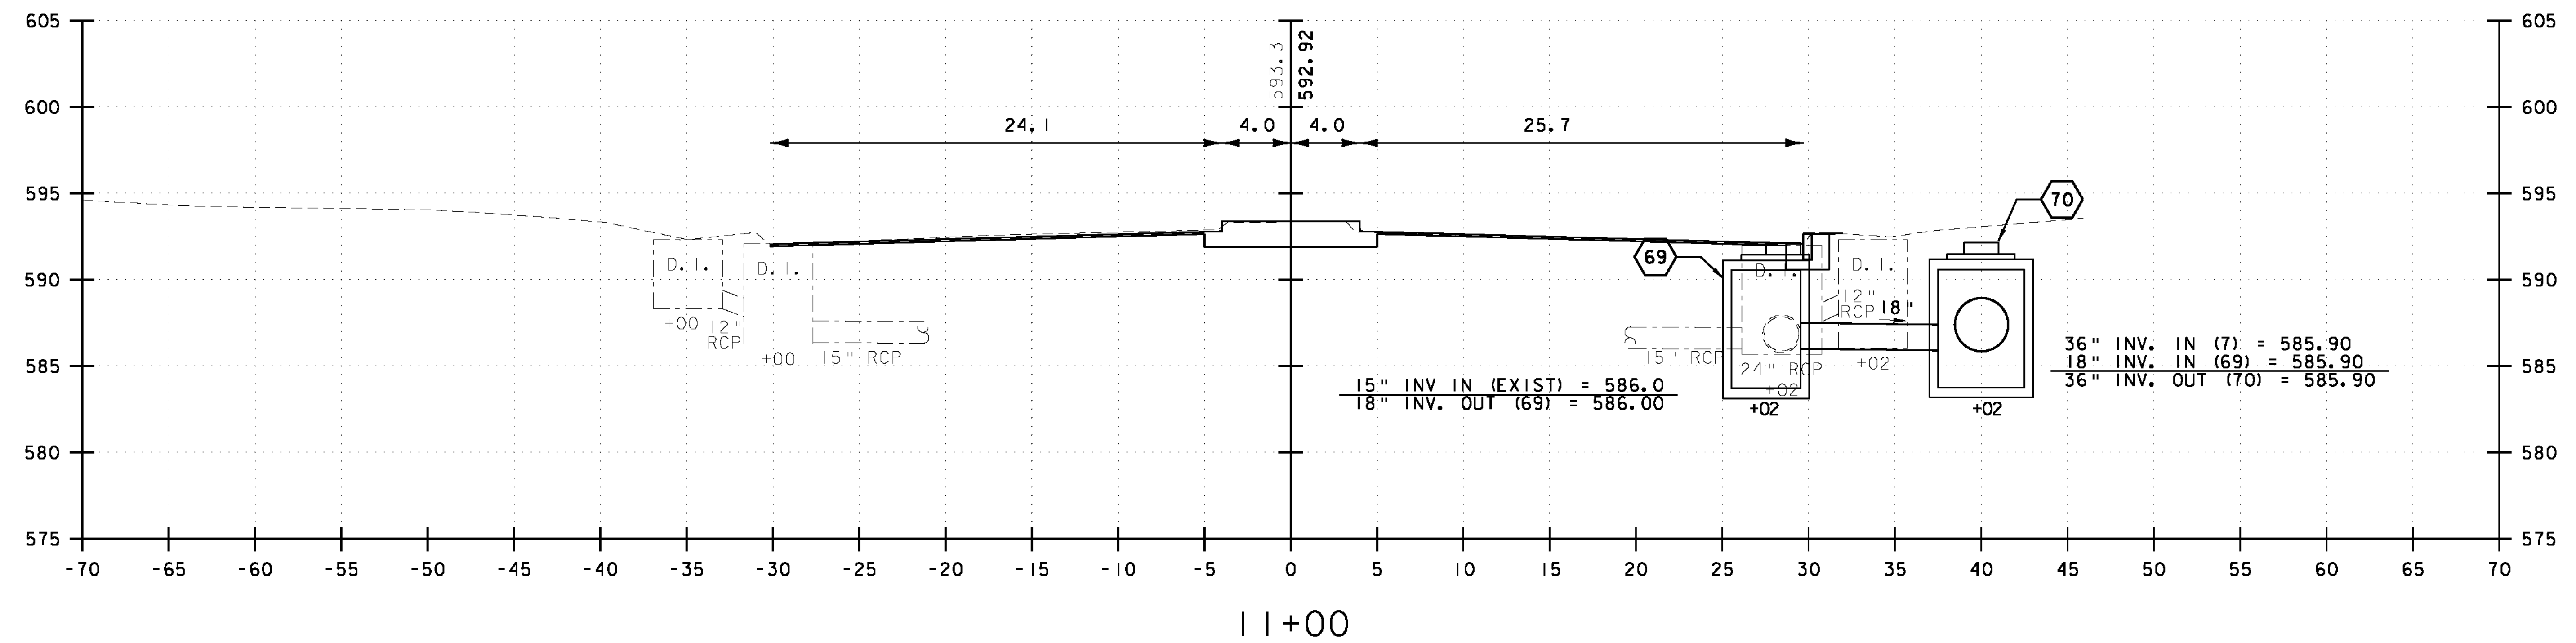


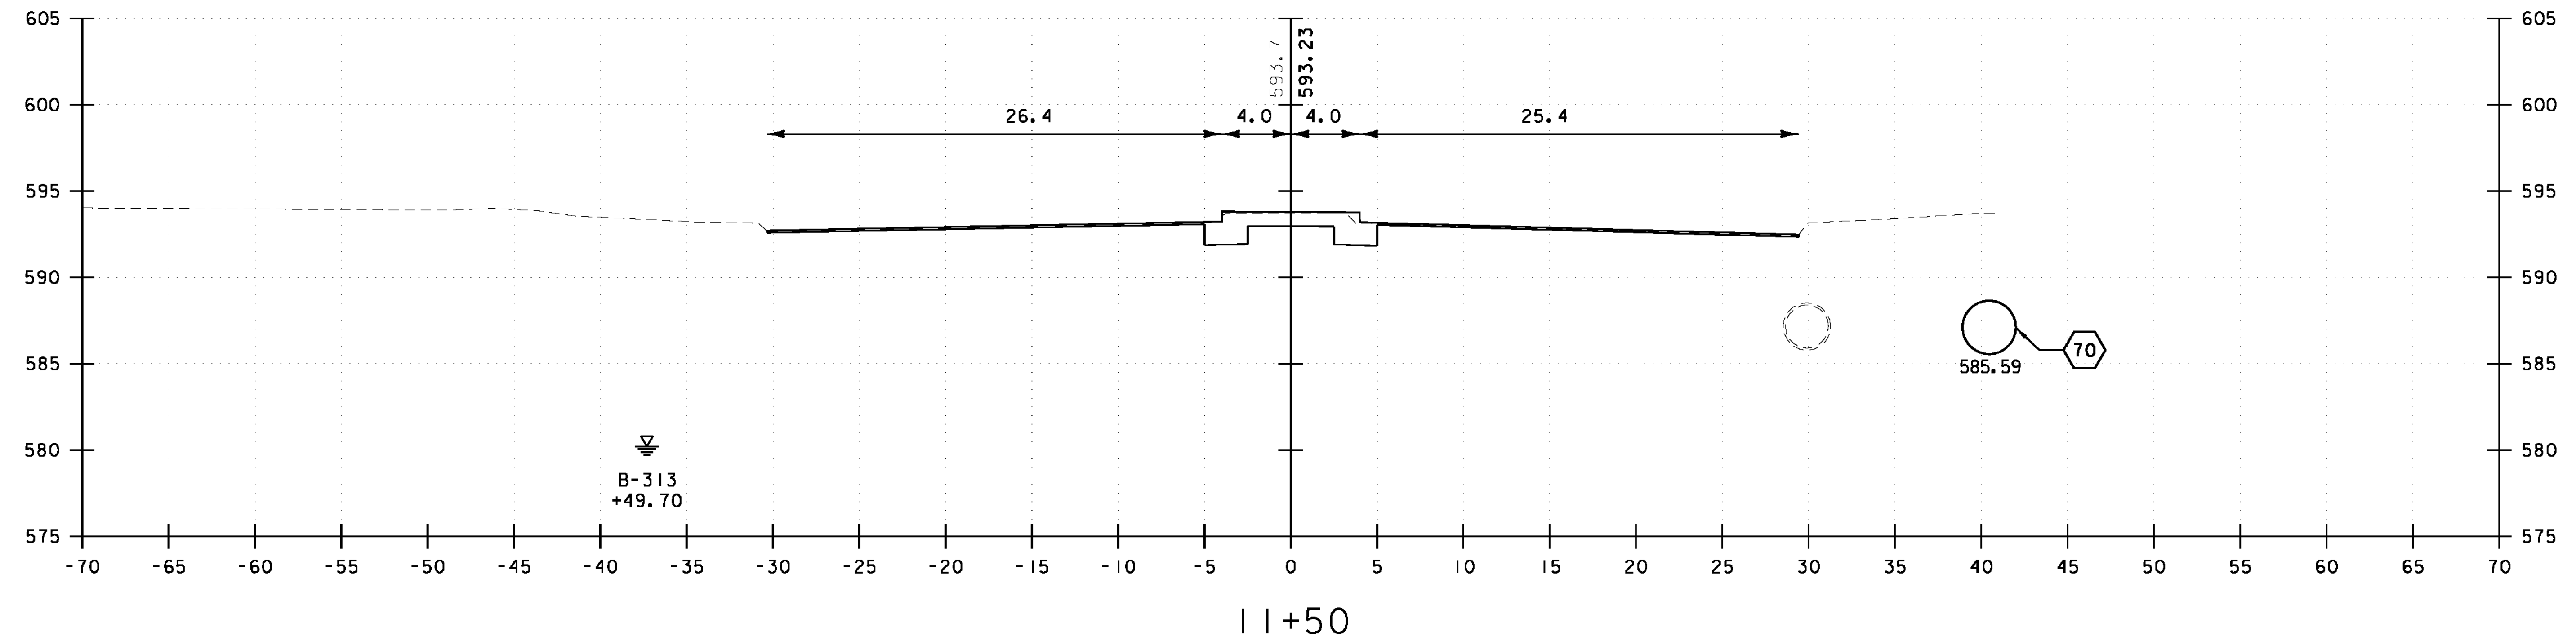

VHB Vanasse Hangen Brustlin, Inc.

ROUTE 62			
PROJECT NAME:	BARRE CITY		
PROJECT NUMBER:	FEGC F 026-1(34) C/2		
FILE NAME:	85b010_xs2_Cut_C2	PROJECT LEADER:	G. BAKOS
DESIGNED BY:	DMP / MDS	CHECKED BY:	
CROSS SECTIONS		SHEET	277 OF 339