





31+25

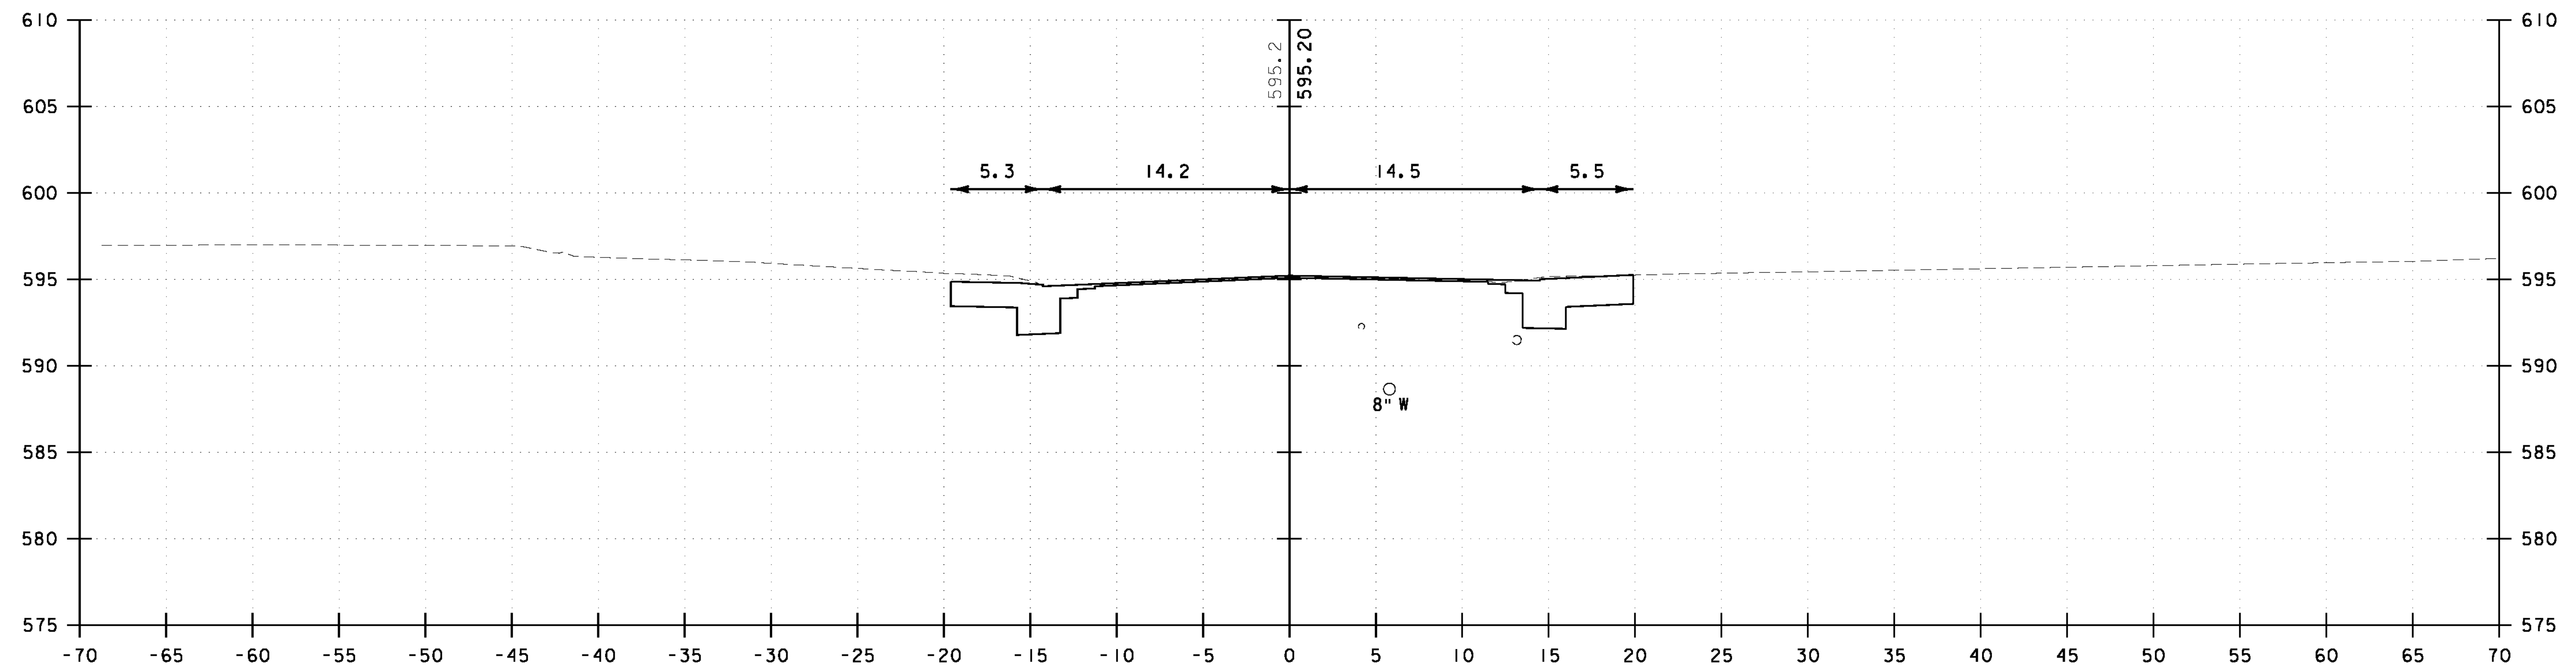

31+00

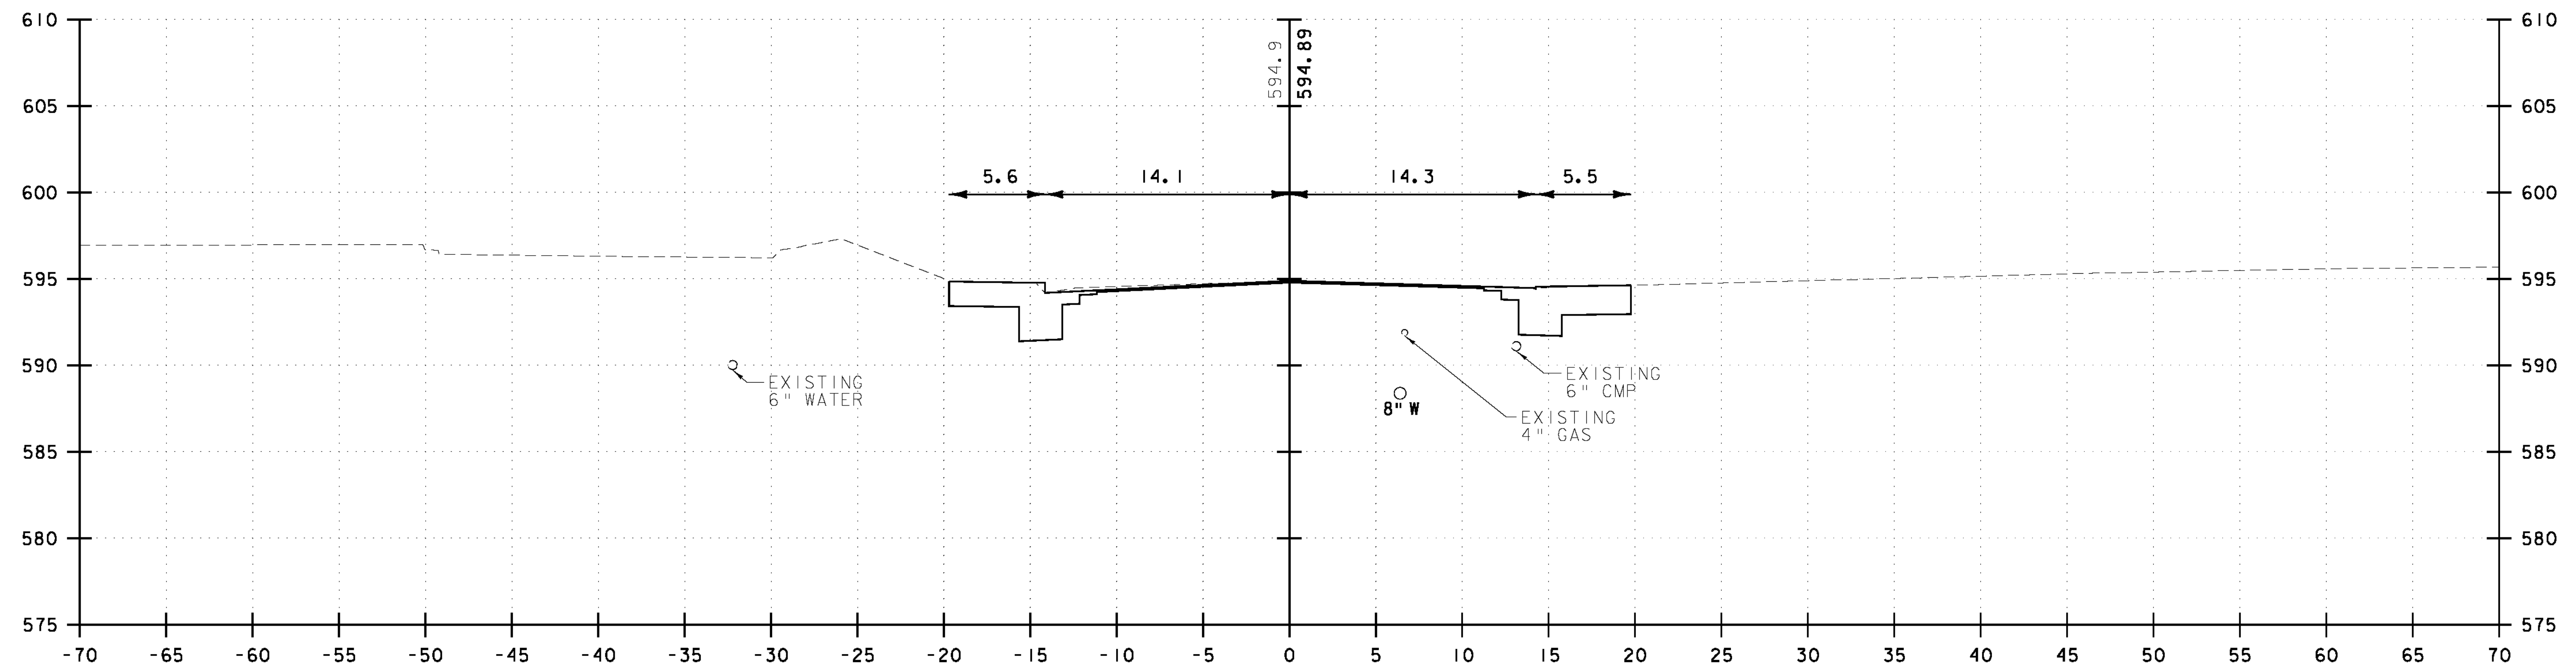

VHB Vanasse Hangen Brustlin, Inc.

COTTAGE STREET			
PROJECT NAME:		BARRE CITY	
PROJECT NUMBER:		FEGC F 026-(34) C/2	
FILE NAME:		85b010_xs2_Cut_C2	
PROJECT LEADER:		G. BAKOS	
DESIGNED BY:		DMP / MDS	
CROSS SECTIONS		SHEET 291 OF 339	
		PLOT DATE: 3/9/2011	
		DRAWN BY: DMP / JAR	
		CHECKED BY:	