


END APPROACH STA. 31+42

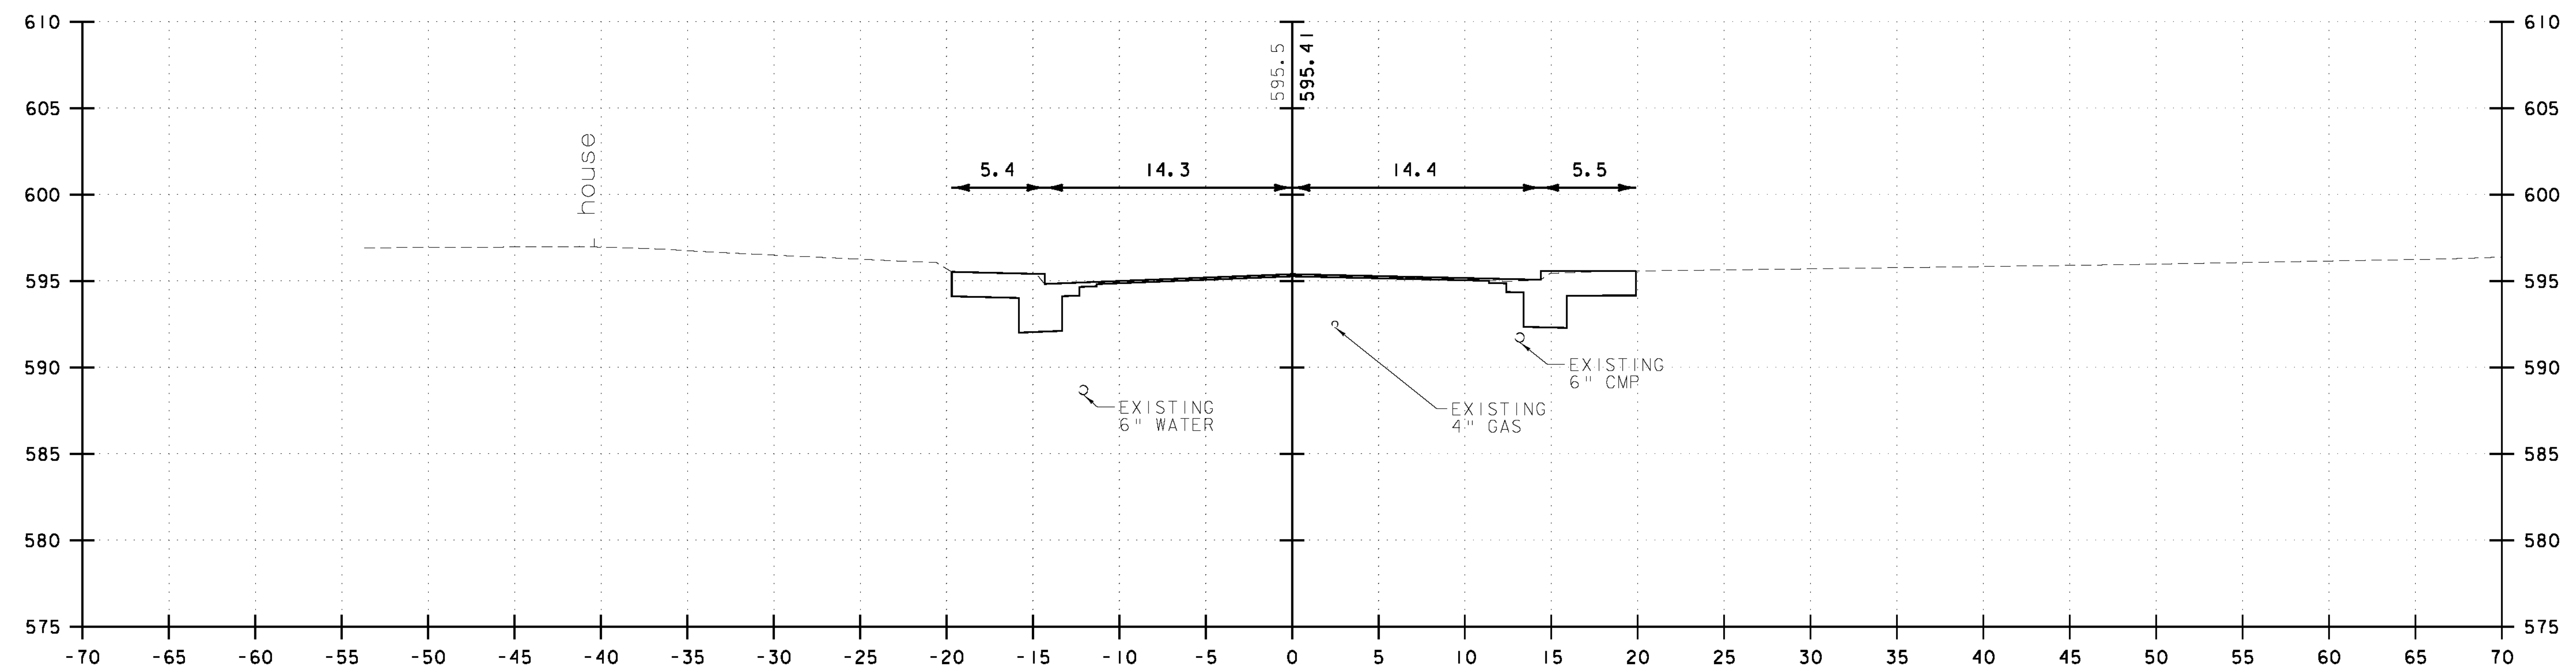

31+42



VHB Vanasse Hangen Brustlin, Inc.

COTTAGE STREET			
PROJECT NAME:	BARRE CITY		
PROJECT NUMBER:	FEGC F 026-I(34) C/2		
FILE NAME:	85b010_xs2_Cut_C2	PLOT DATE:	3/9/2011
PROJECT LEADER:	G. BAKOS	DRAWN BY:	DMP / JAR
DESIGNED BY:	DMP / MDS	CHECKED BY:	
CROSS SECTIONS		SHEET	292 OF 339