
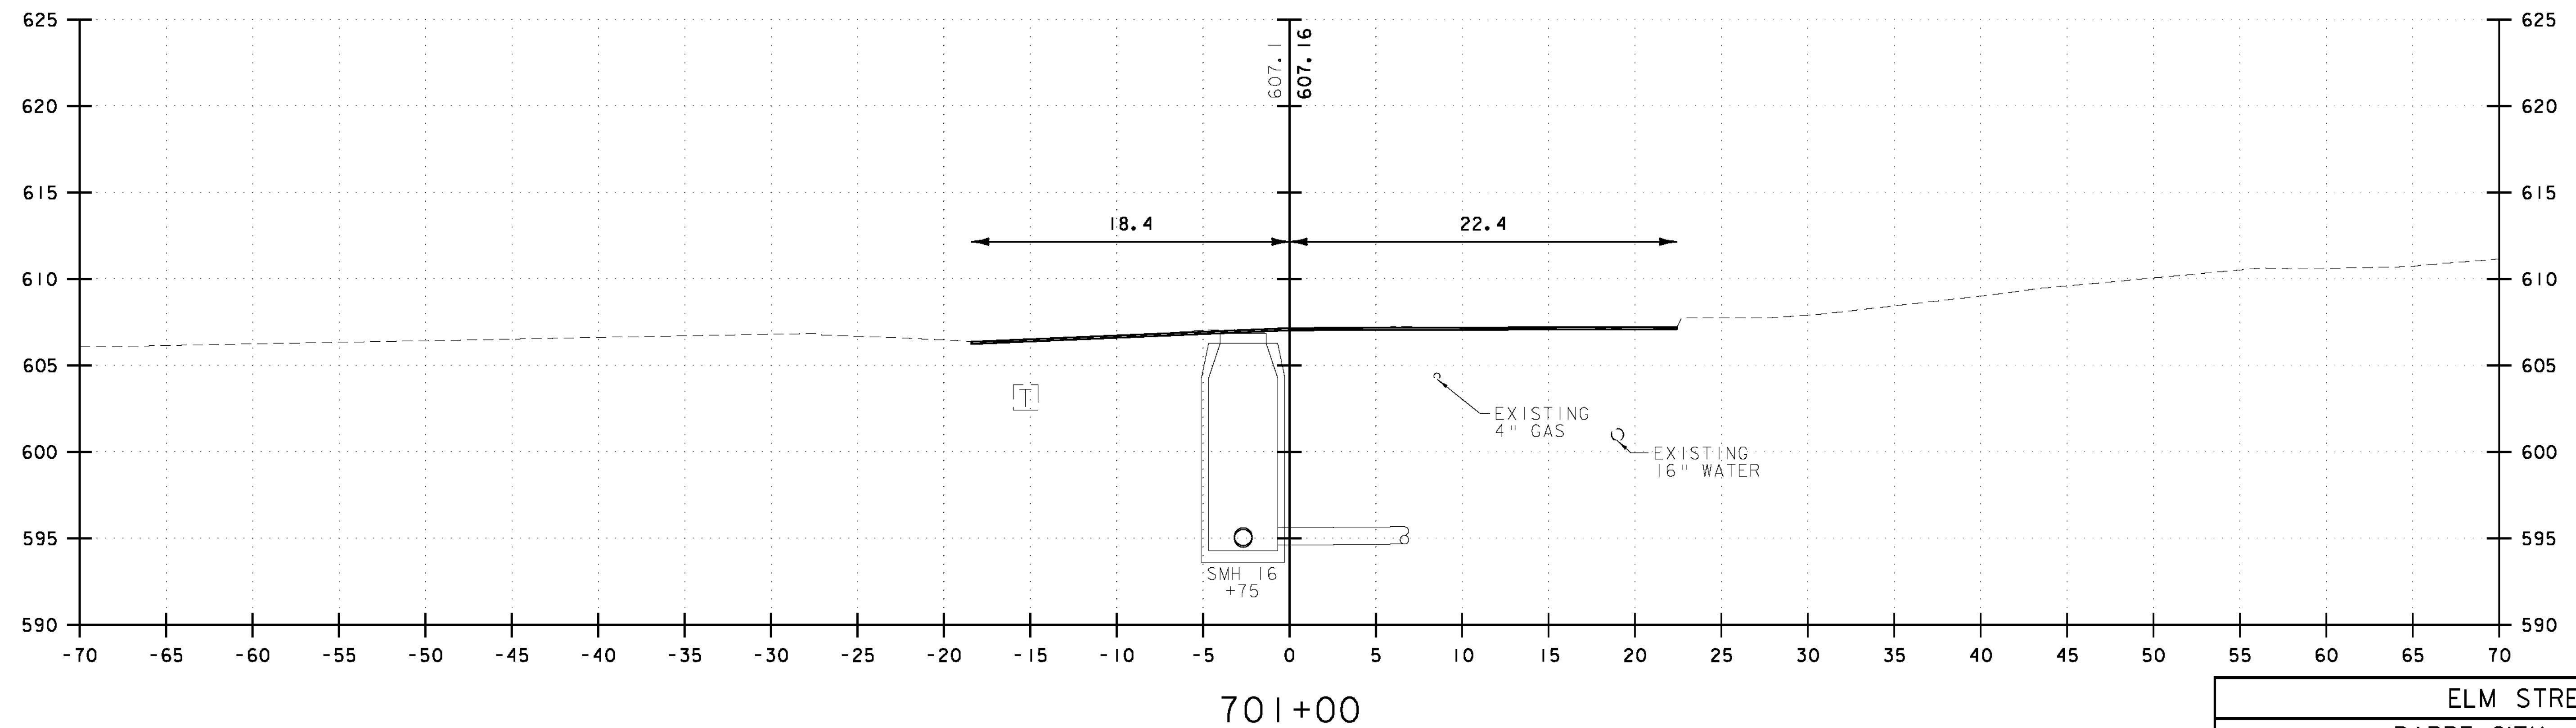


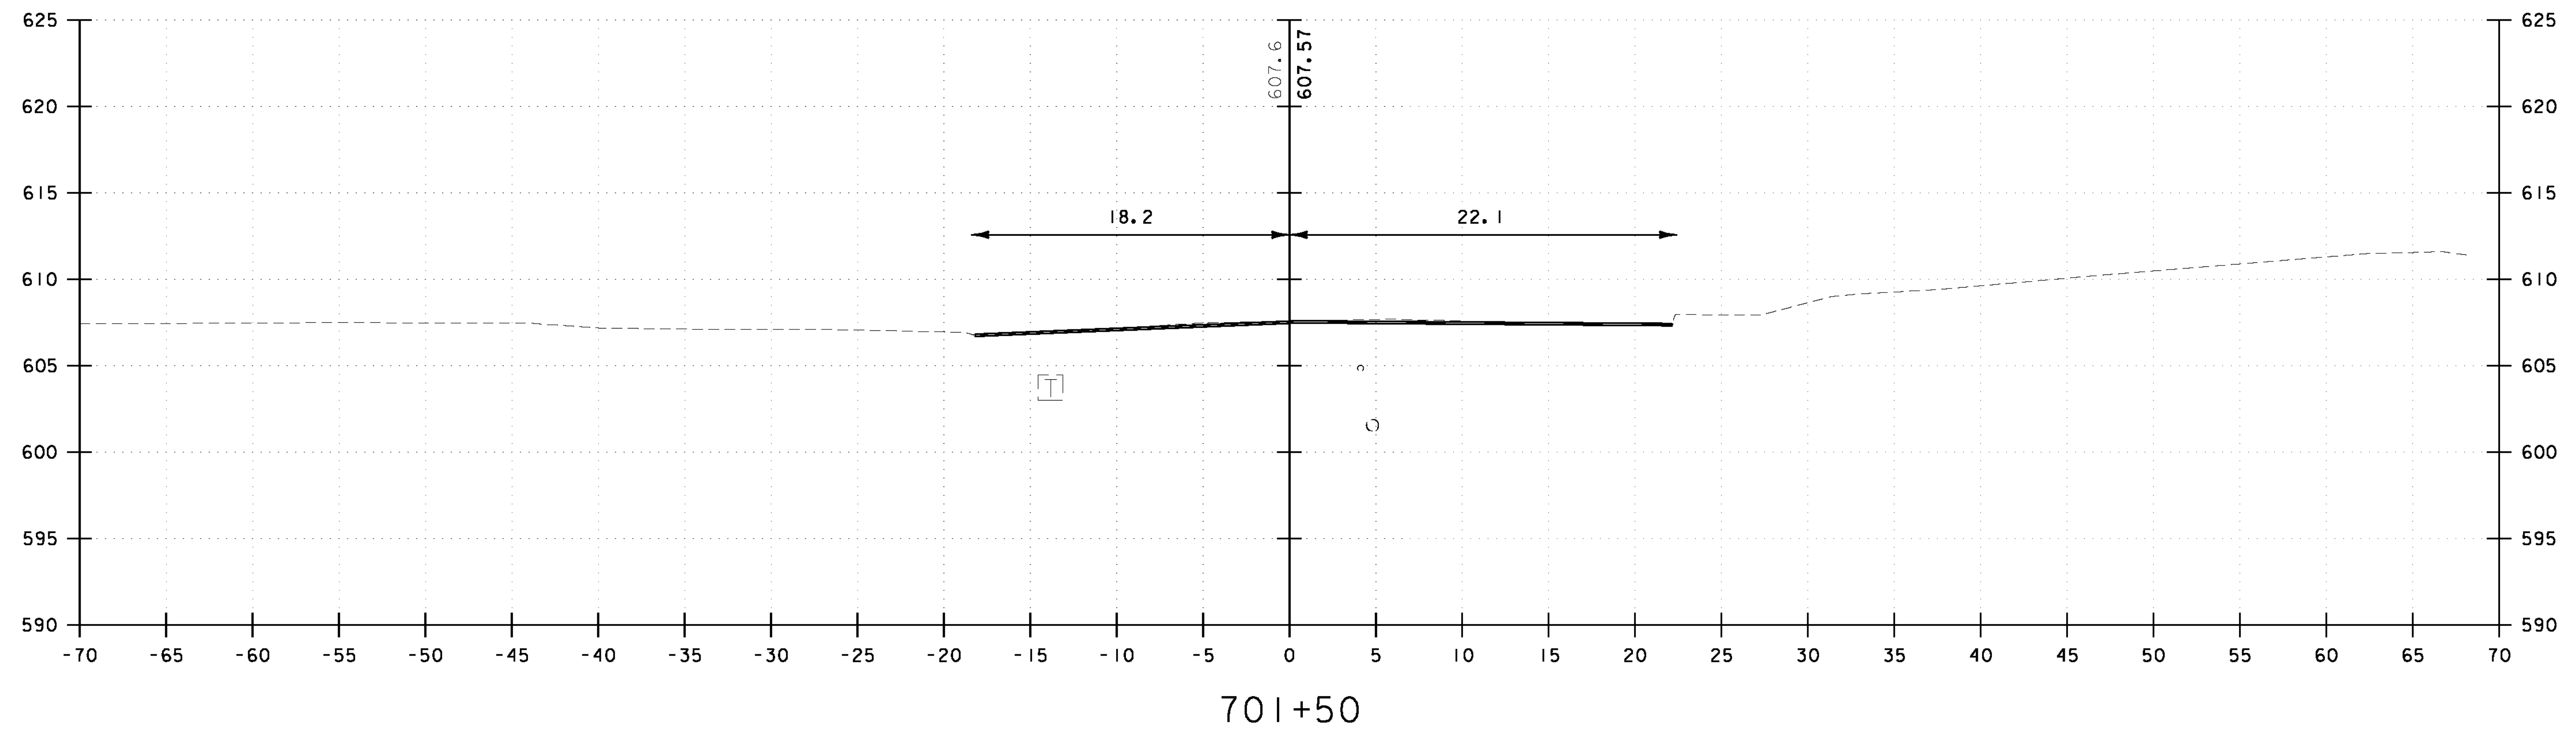

VHB Vanasse Hangen Brustlin, Inc.

ELM STREET	
PROJECT NAME:	BARRE CITY
PROJECT NUMBER:	FEGC F 026-(34) C/2
FILE NAME:	85b010_xs2_Cut_C2
PROJECT LEADER:	G. BAKOS
DESIGNED BY:	DMP / MDS
CROSS SECTIONS	
PLOT DATE:	3/9/2011
DRAWN BY:	DMP / JAR
CHECKED BY:	
SHEET	326 OF 339