


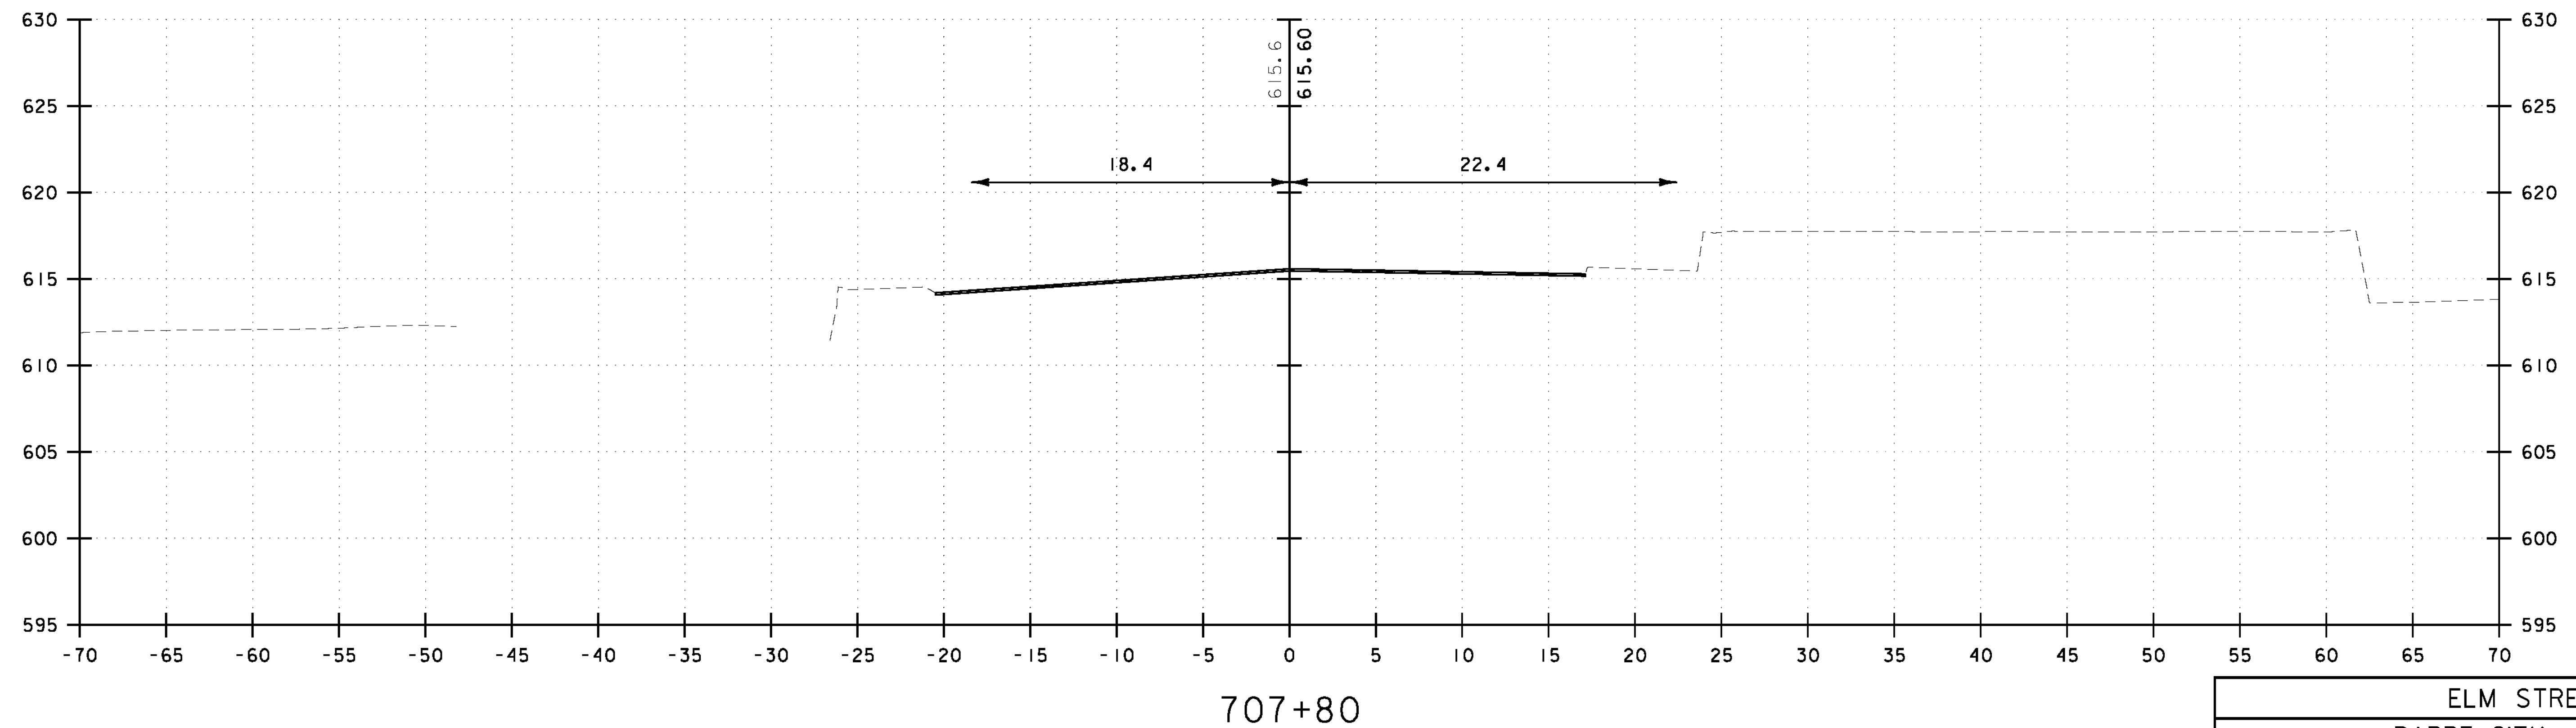

VHB Vanasse Hangen Brustlin, Inc.

ELM STREET			
PROJECT NAME:		BARRE CITY	
PROJECT NUMBER:		FEGC F 026-(34) C/2	
FILE NAME:		85b010_xs2_Cut_C2	PLOT DATE: 3/9/2011
PROJECT LEADER:		G. BAKOS	DRAWN BY: DMP / JAR
DESIGNED BY:		DMP / MDS	CHECKED BY:
CROSS SECTIONS			SHEET 333 OF 339