



SECTION VIEW

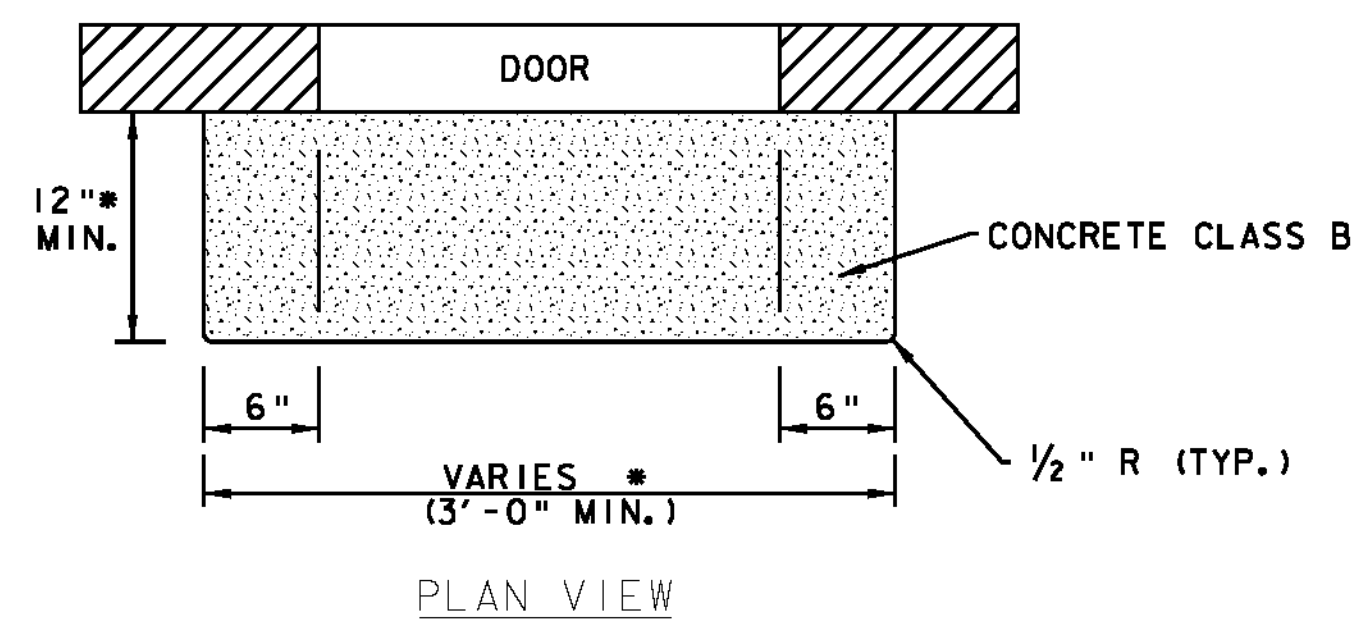


PLAN VIEW

CONCRETE STEP
N.T.S.

* MATCH EXISTING
STEP DIMENSIONS

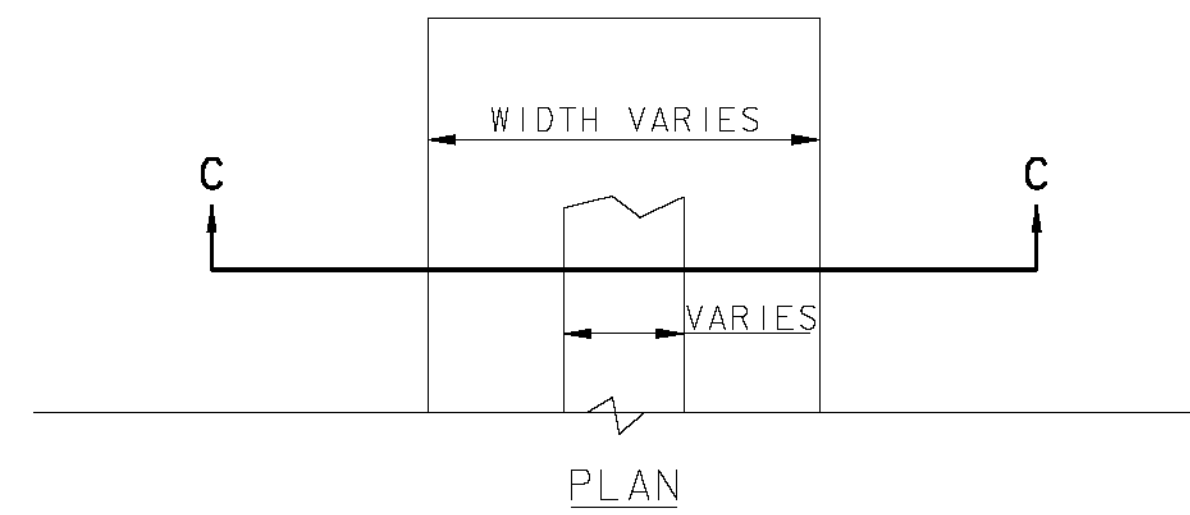


PLAN

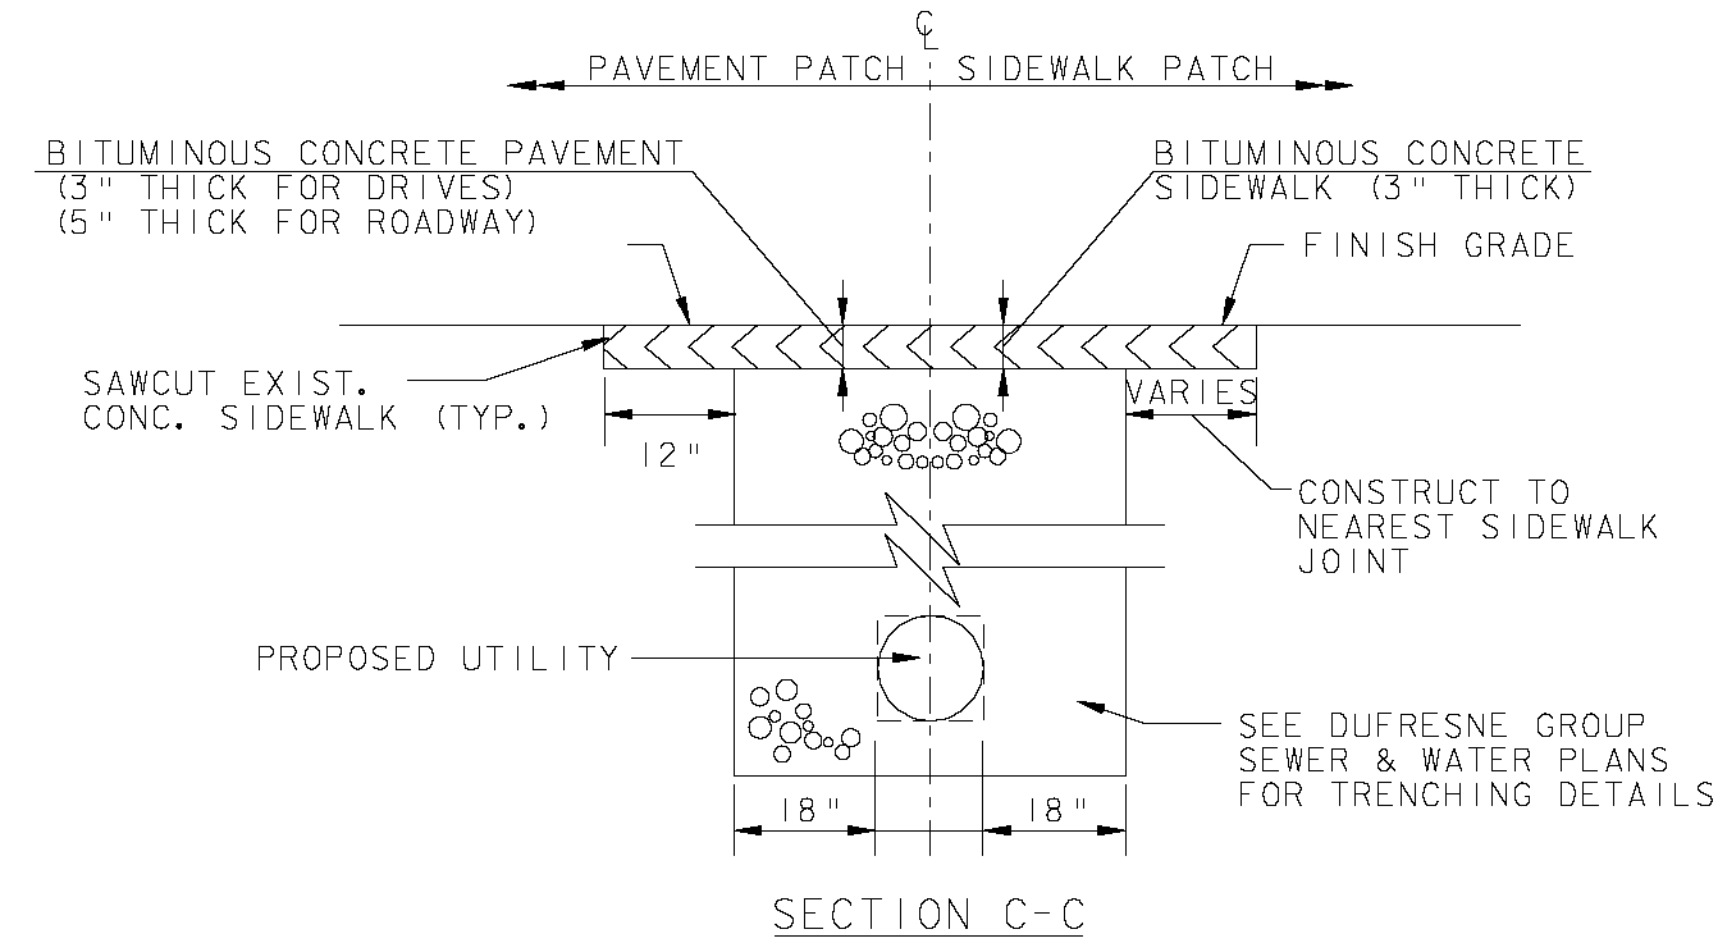


SECTION C-C


TEMPORARY BITUMINOUS CONCRETE PATCH AT UTILITY TRENCH
N.T.S.

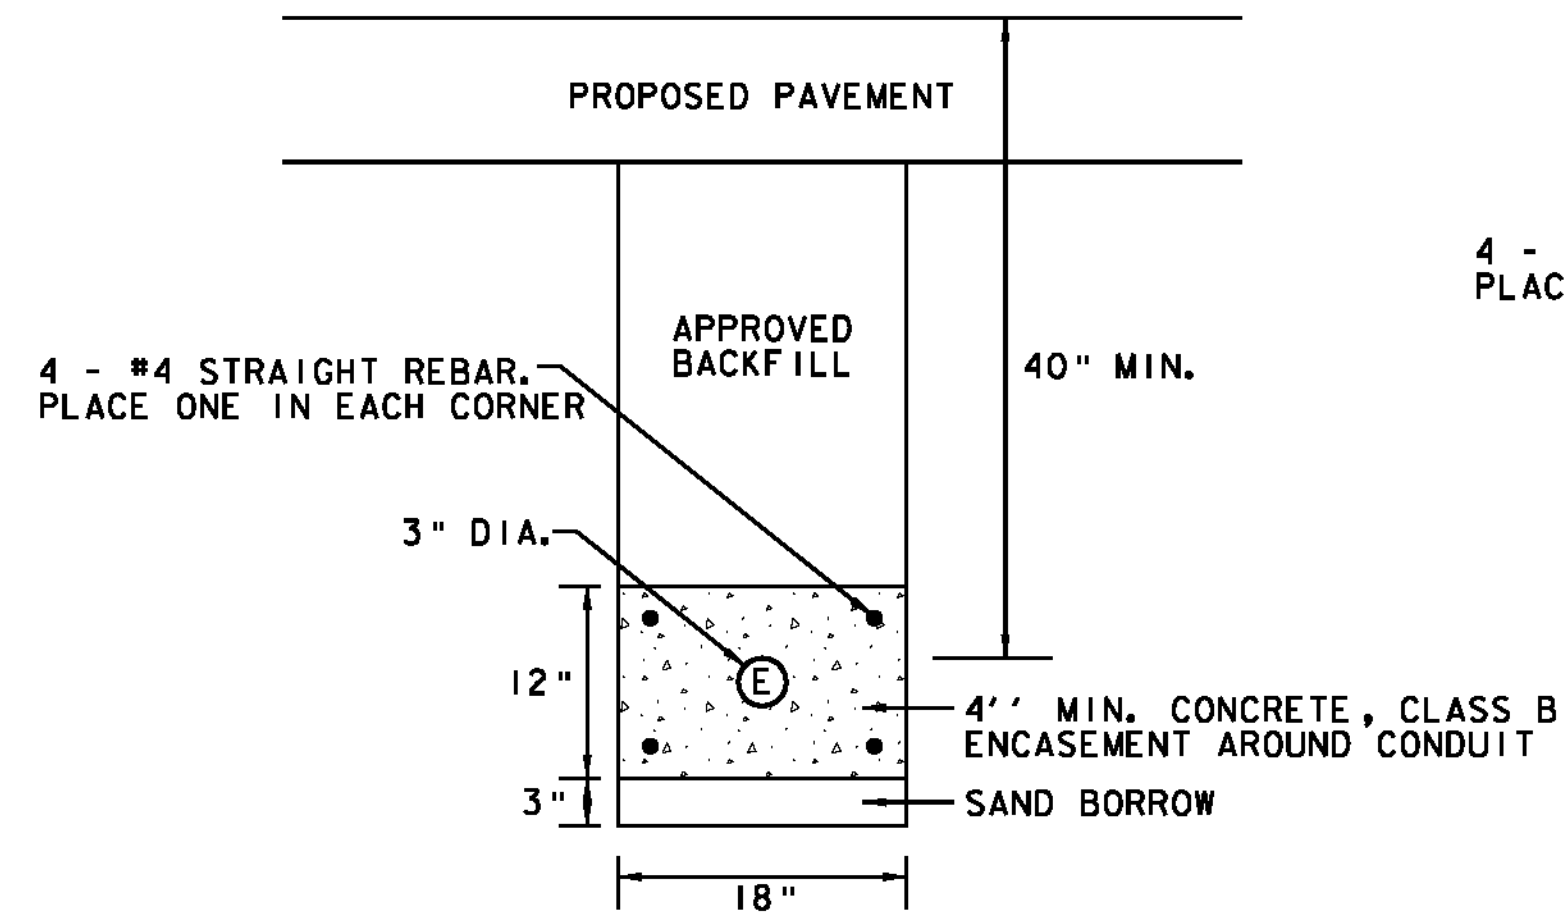

SPECIAL PROVISION (DUCT BANK) (1 CONDUIT)
SEE GENERAL PLANS FOR LOCATIONS
N.T.S.

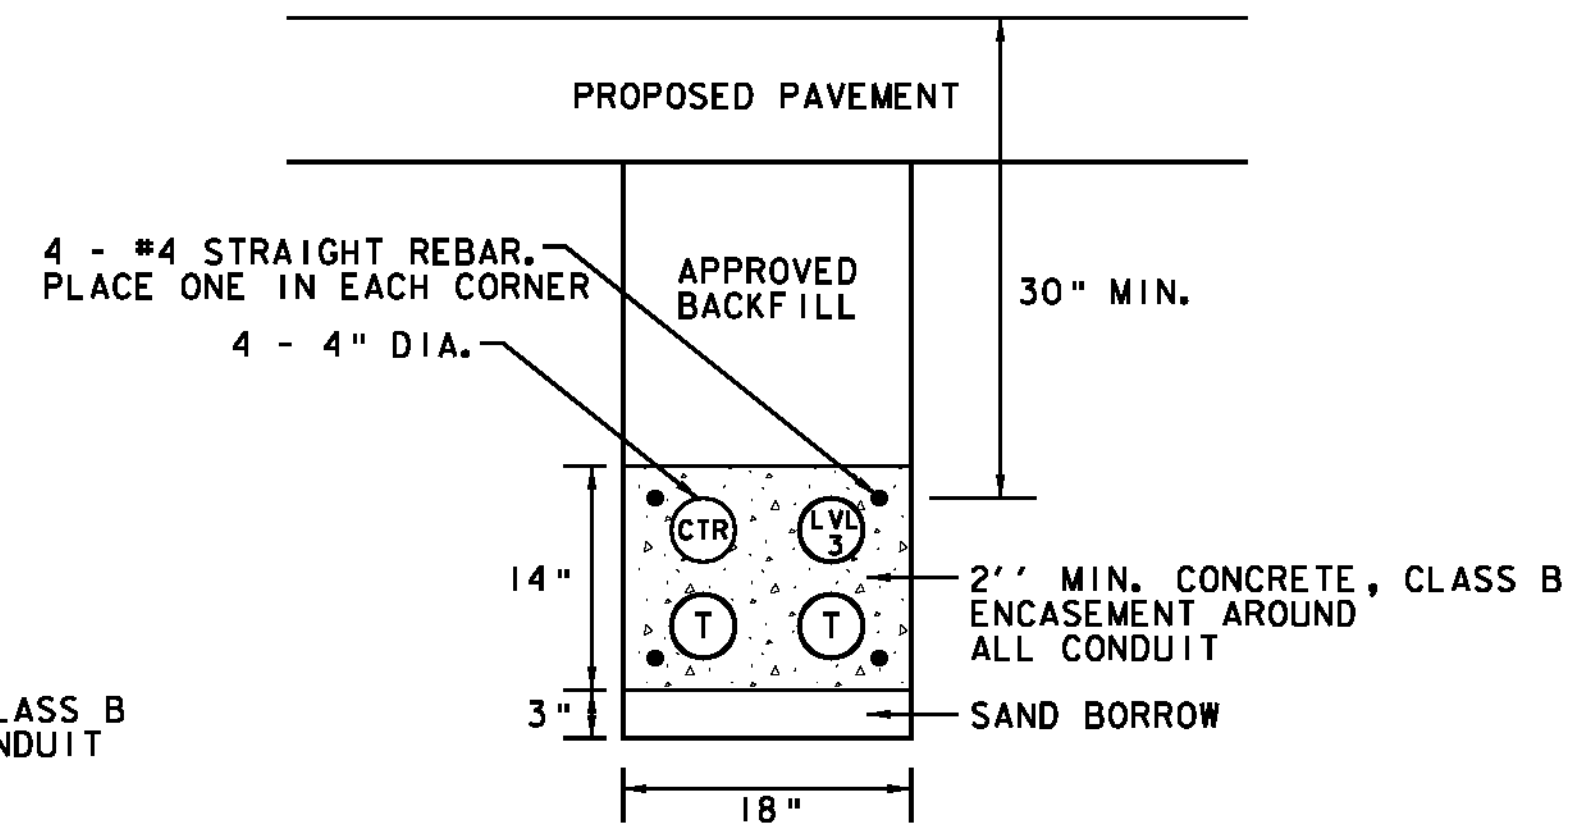

SPECIAL PROVISION (DUCT BANK) (4 CONDUIT)
SEE GENERAL PLANS FOR LOCATIONS
N.T.S.

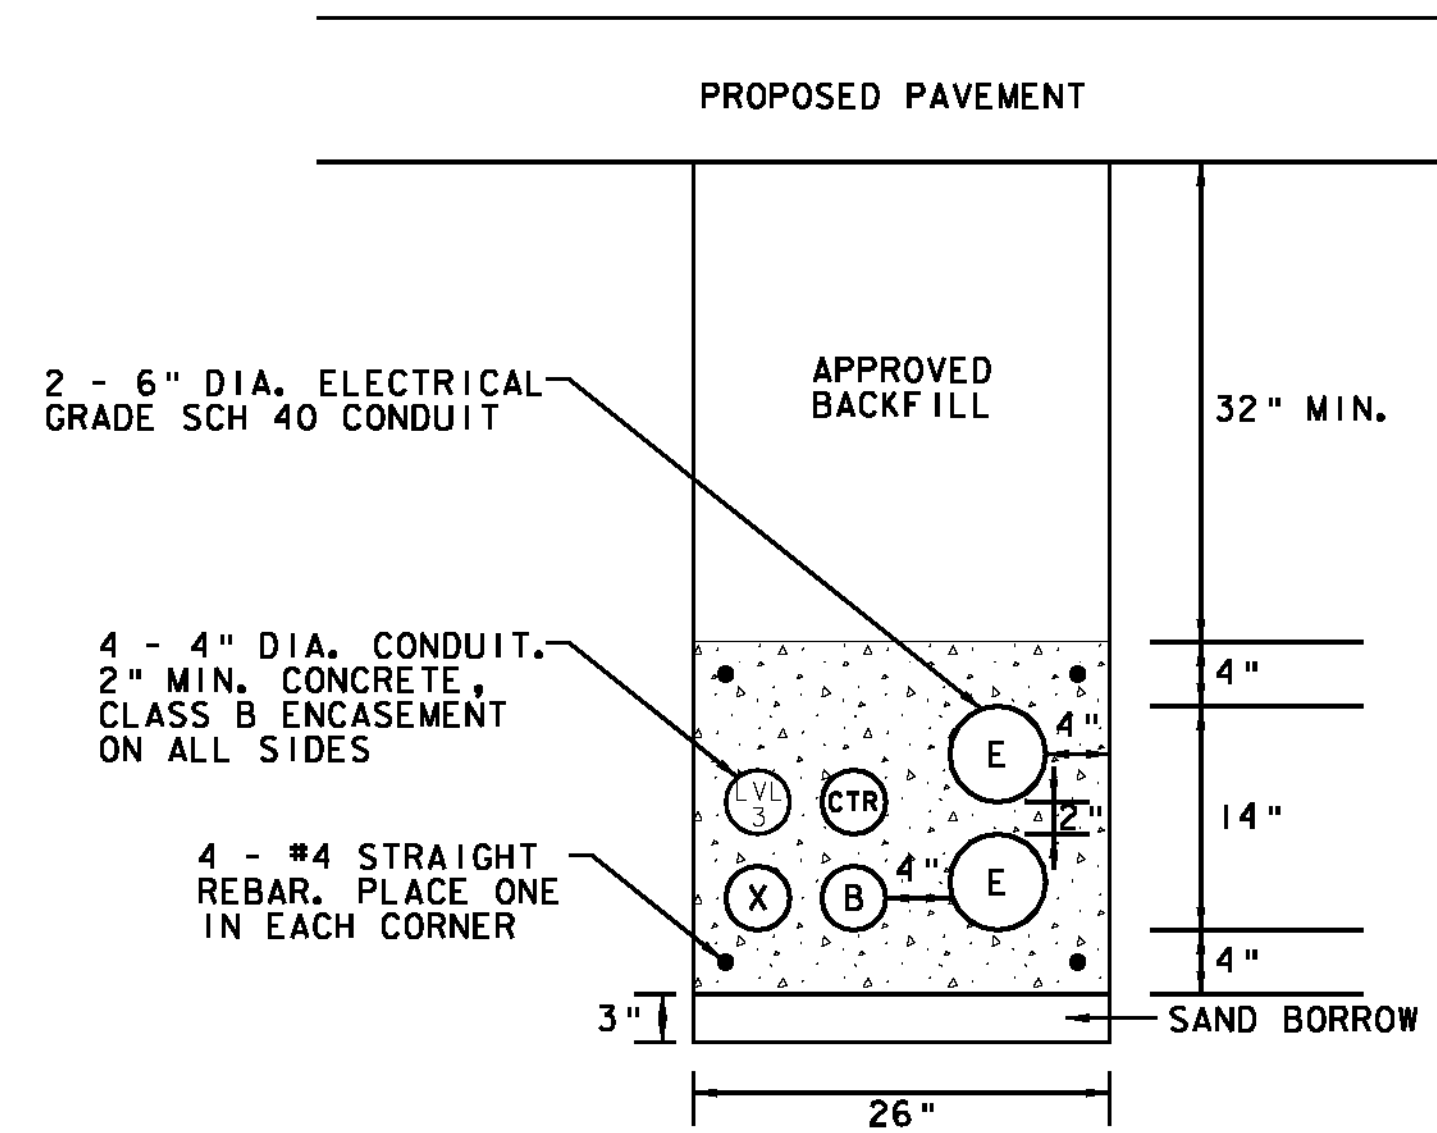

SPECIAL PROVISION (DUCT BANK) (6 CONDUIT)
SEE GENERAL PLANS FOR LOCATIONS
N.T.S.

CONDUIT LEGEND

- (X) (B) (T) FAIRPOINT TELECOMMUNICATIONS CONDUIT
- (CTR) CHARTER TELECOMMUNICATIONS CONDUIT
- (LV3) LEVEL 3 TELECOMMUNICATIONS CONDUIT
- (E) GREEN MOUNTAIN POWER ELECTRICAL CONDUIT

PROJECT NAME: BARRE CITY
PROJECT NUMBER: FECC F 026-1(34) C/2

FILE NAME: 85b010_DET_C2
PROJECT LEADER: G. BAKOS
DESIGNED BY: DMP / MDS
CONSTRUCTION DETAILS #2

PLOT DATE: 3/21/2011
DRAWN BY: DMP / JAR
CHECKED BY:
SHEET 7 OF 339