



VT 62 DRAINAGE PROFILE

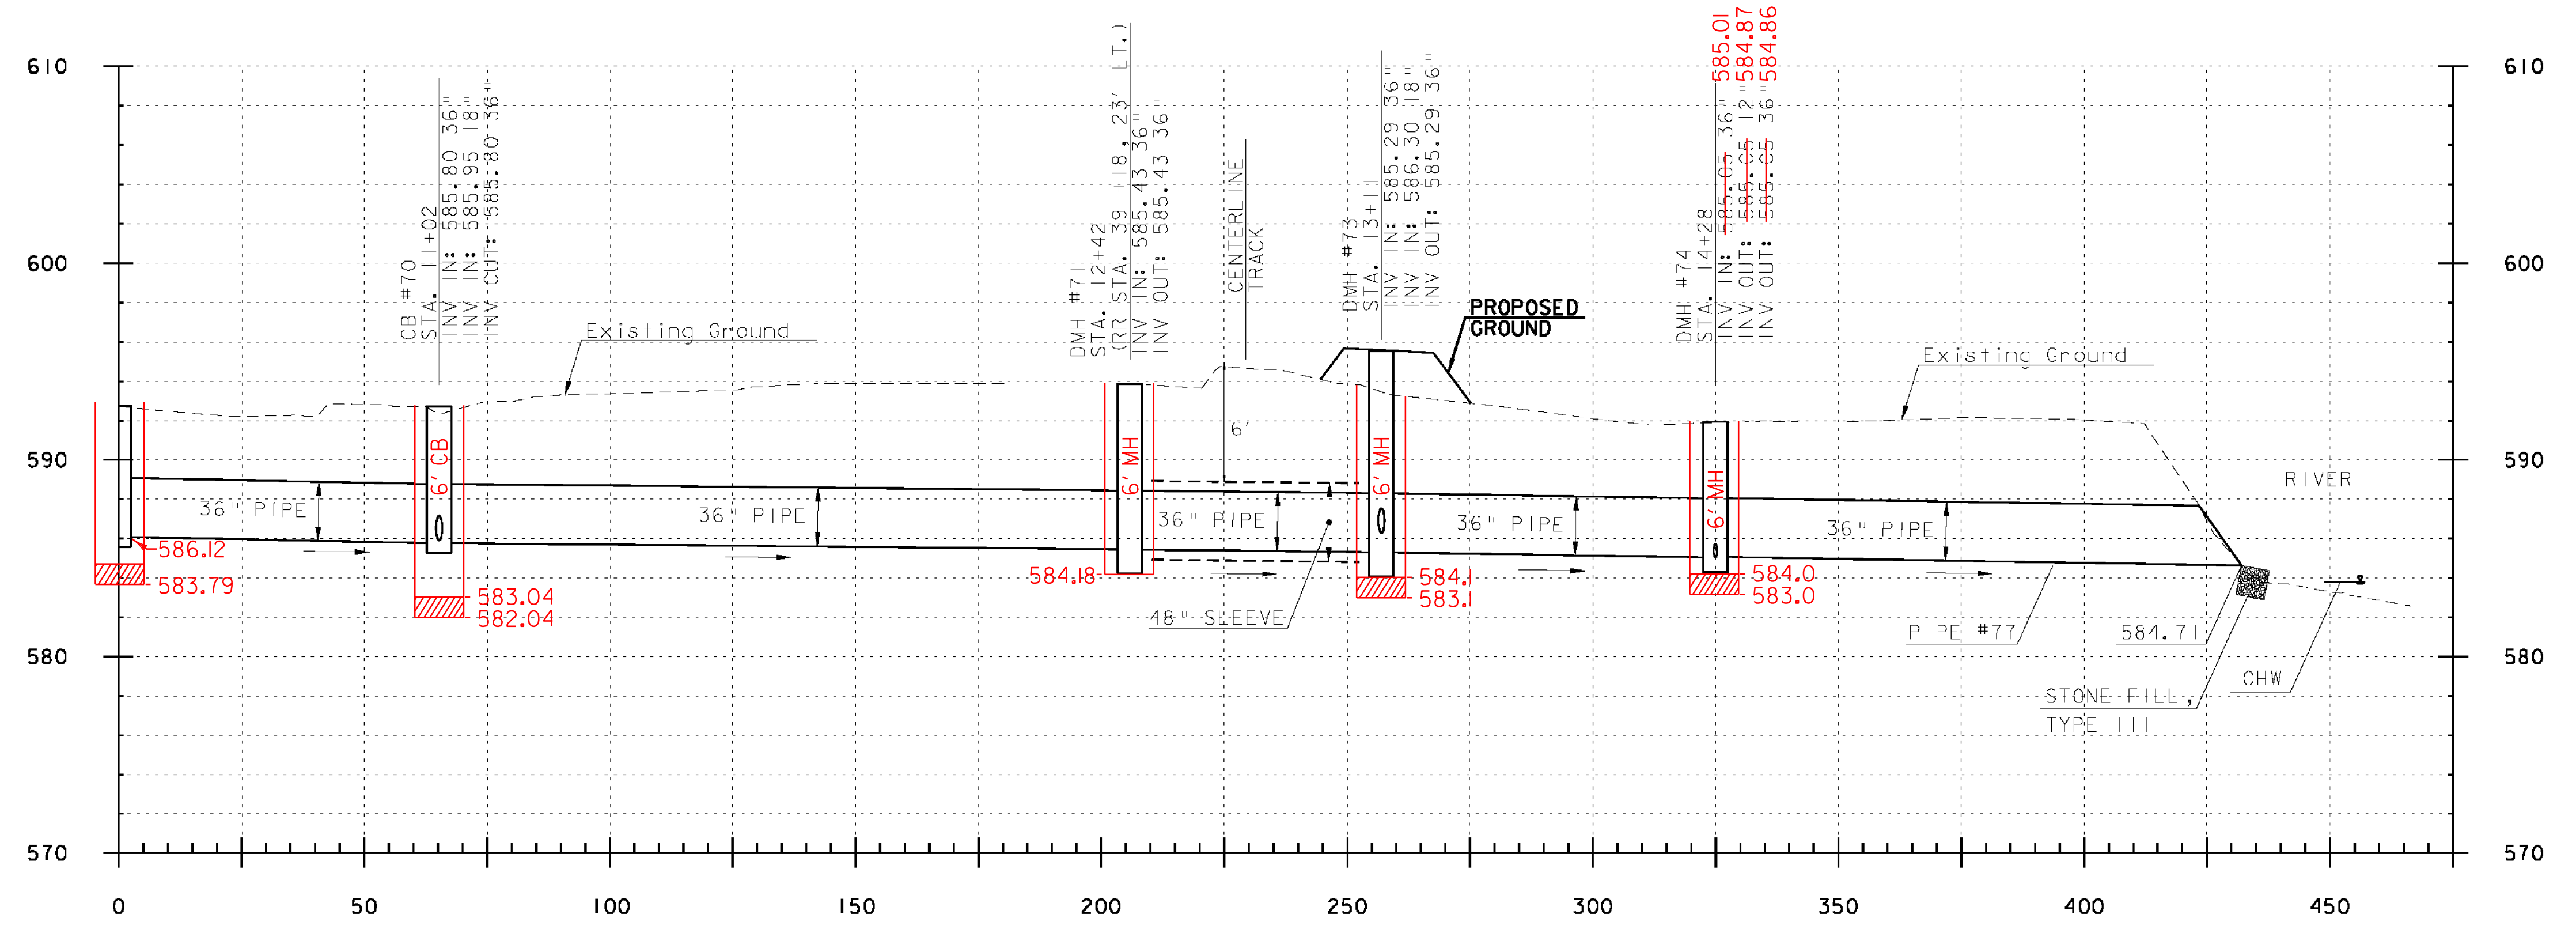

DATUM	
VERTICAL	NAVD 1929
HORIZONTAL	NAD 27

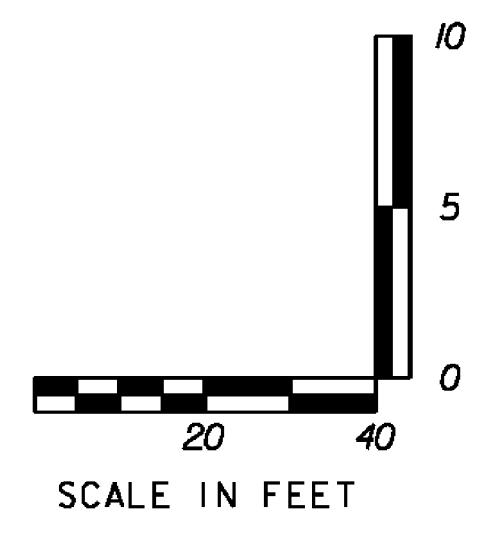

PROJECT NAME: BARRE CITY	
PROJECT NUMBER: FEFC F 026-1(34) C/2	
FILE NAME: 85b010_RRPROF_C2	PLOT DATE: 3/9/2011
PROJECT LEADER: G. BAKOS	DRAWN BY: DMP / JAR
DESIGNED BY: DMP / MDS	CHECKED BY:
VT ROUTE 62 PROPOSED DRAINAGE PROFILE	SHEET 11 OF 339

VHB Vanasse Hangen Brustlin, Inc.