

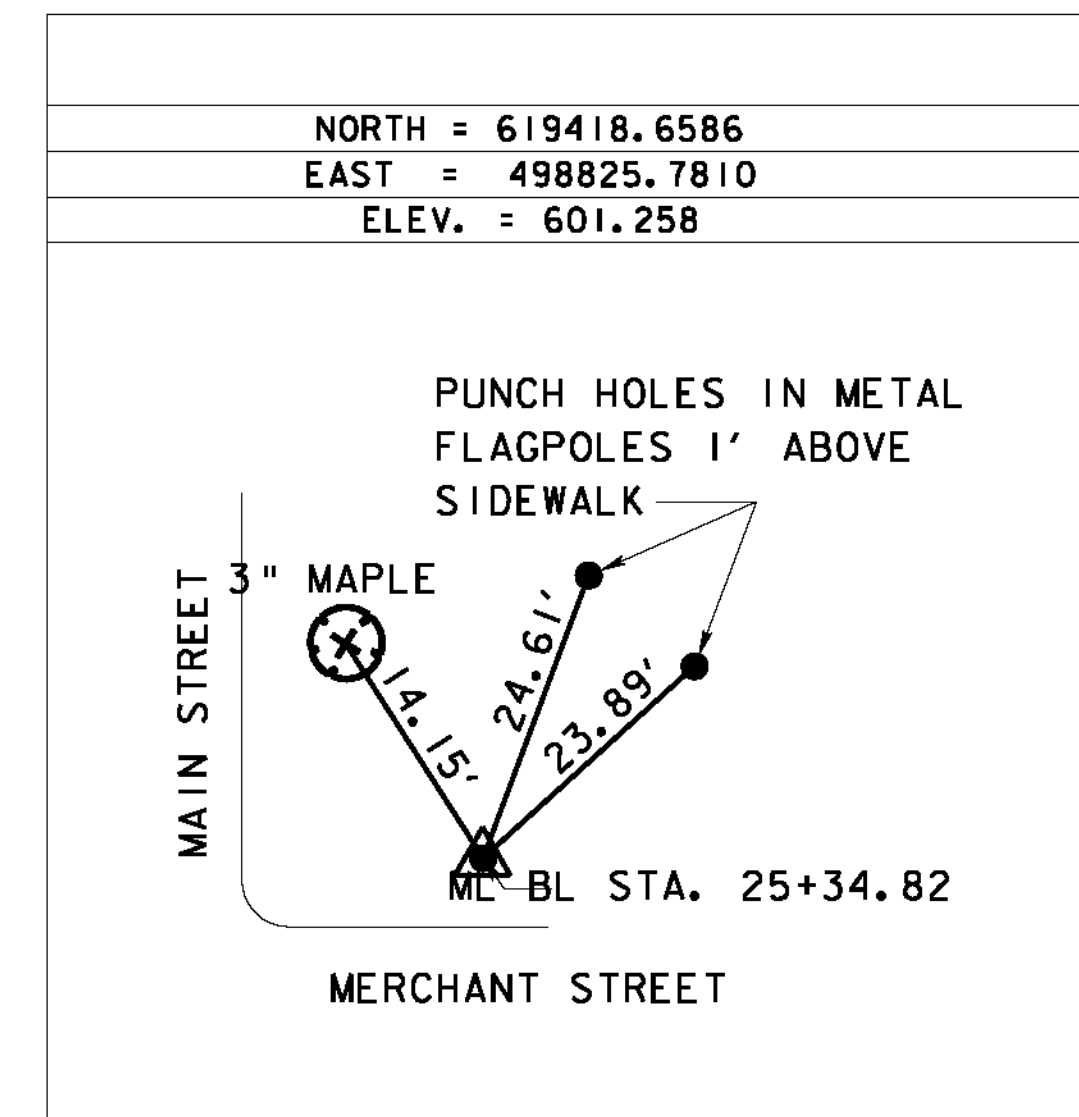
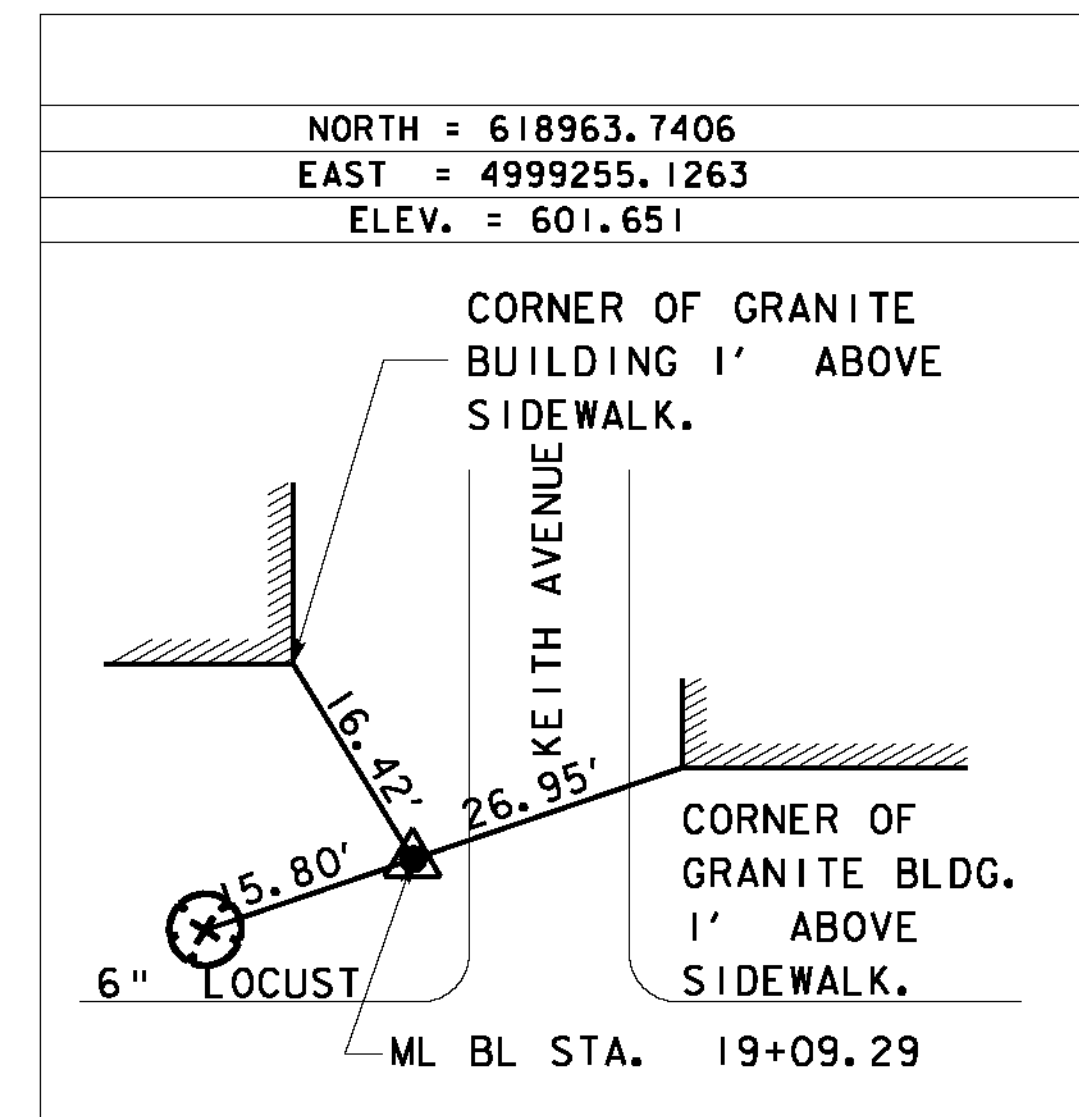
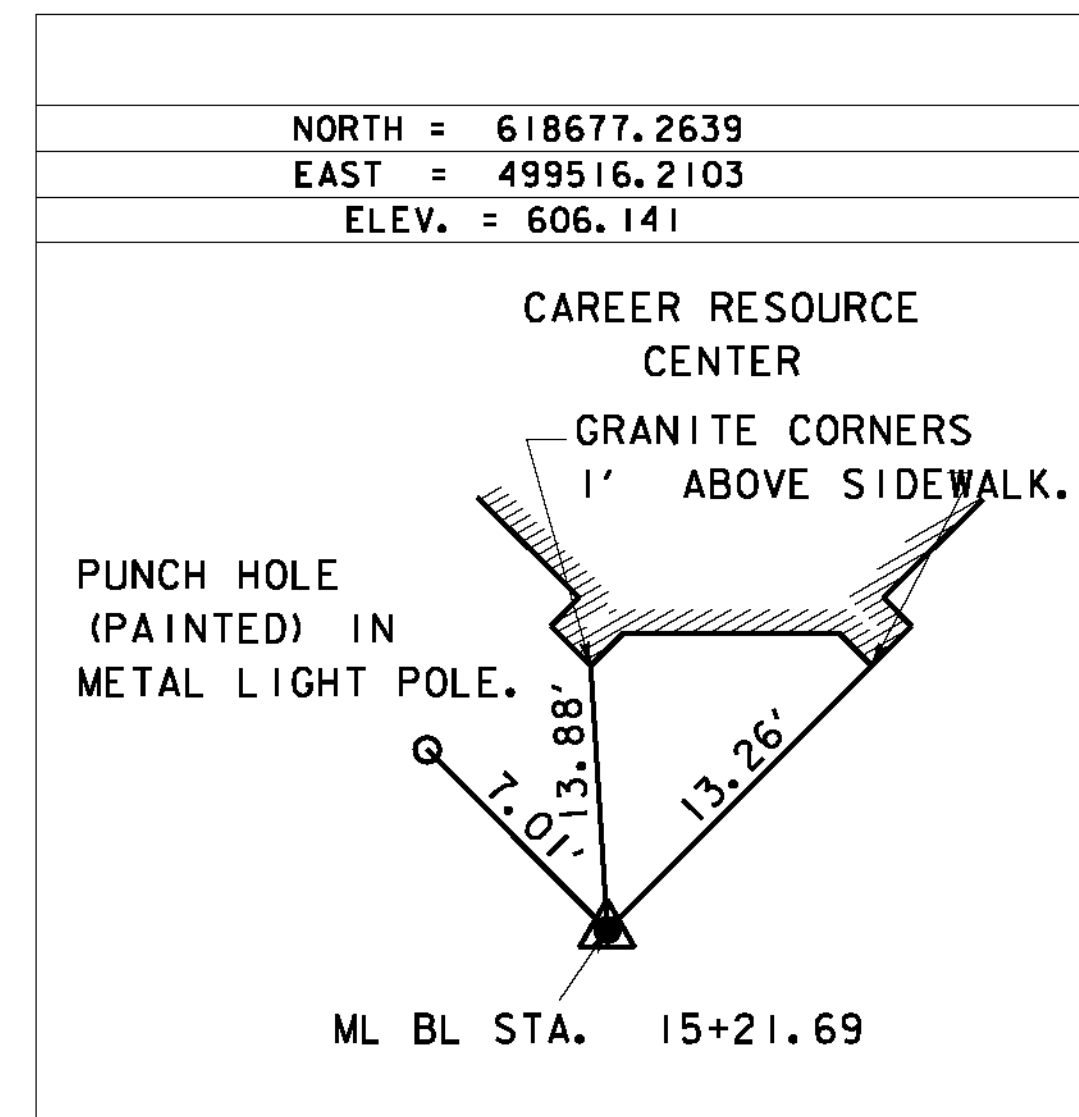
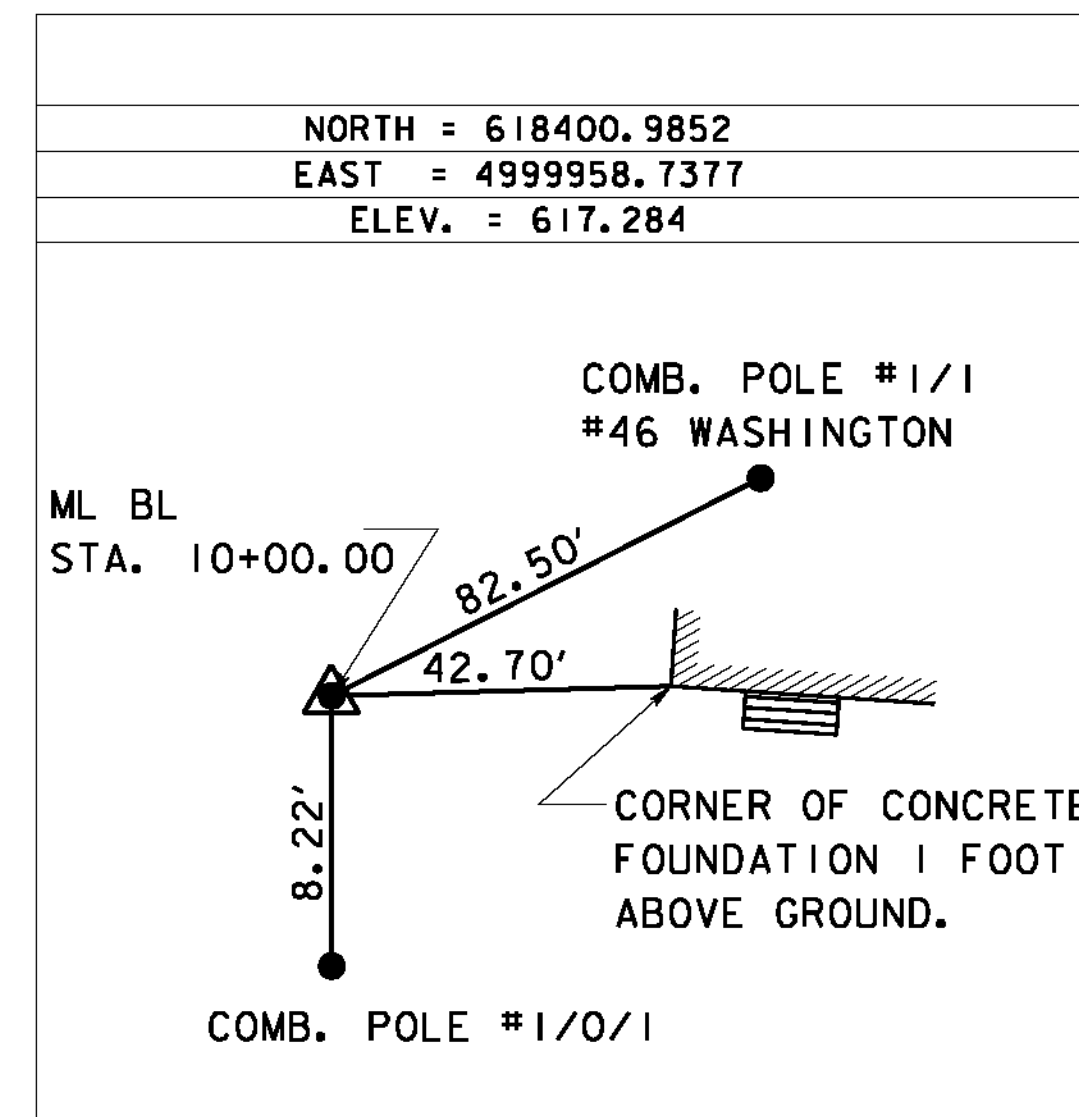
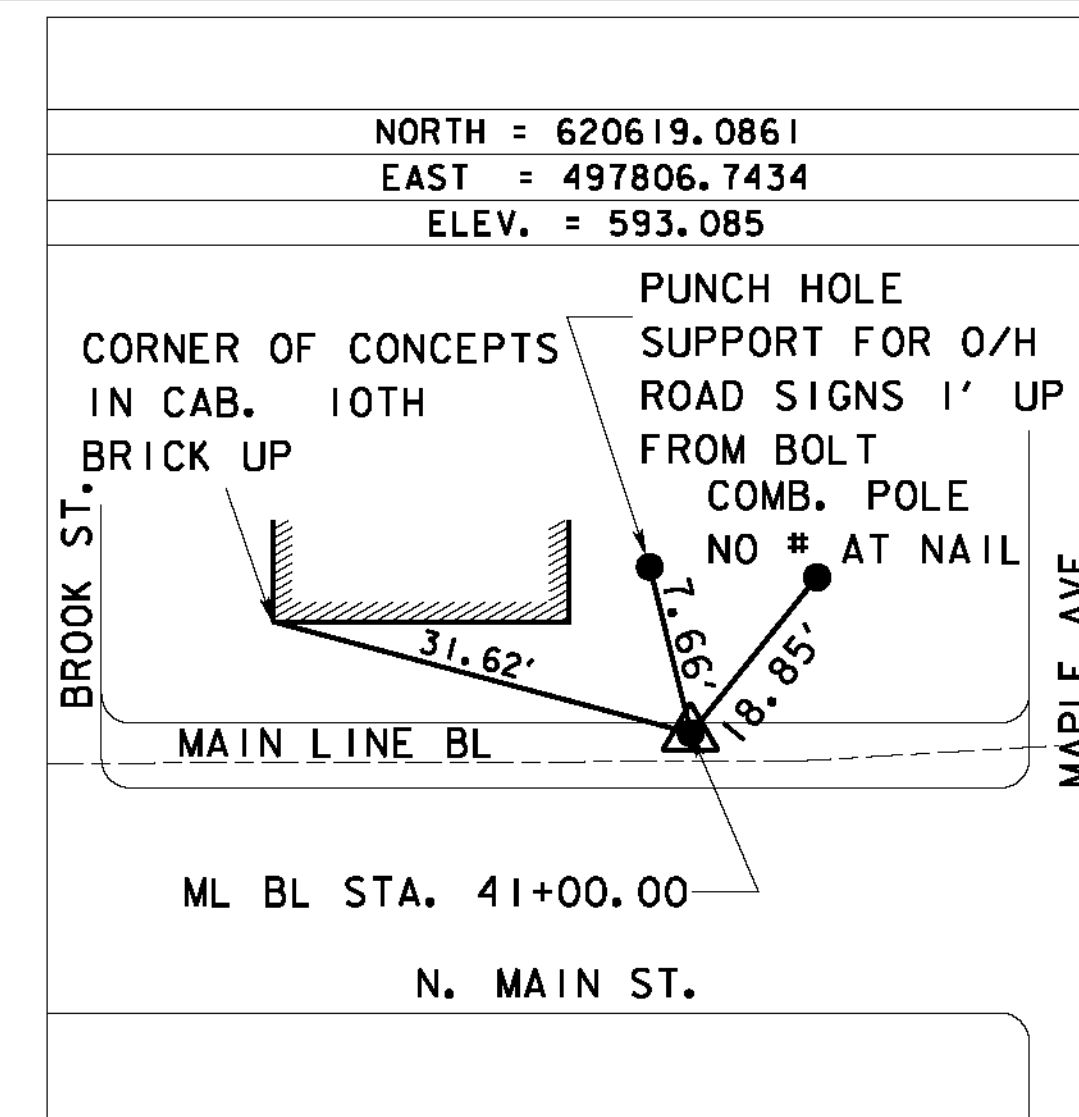
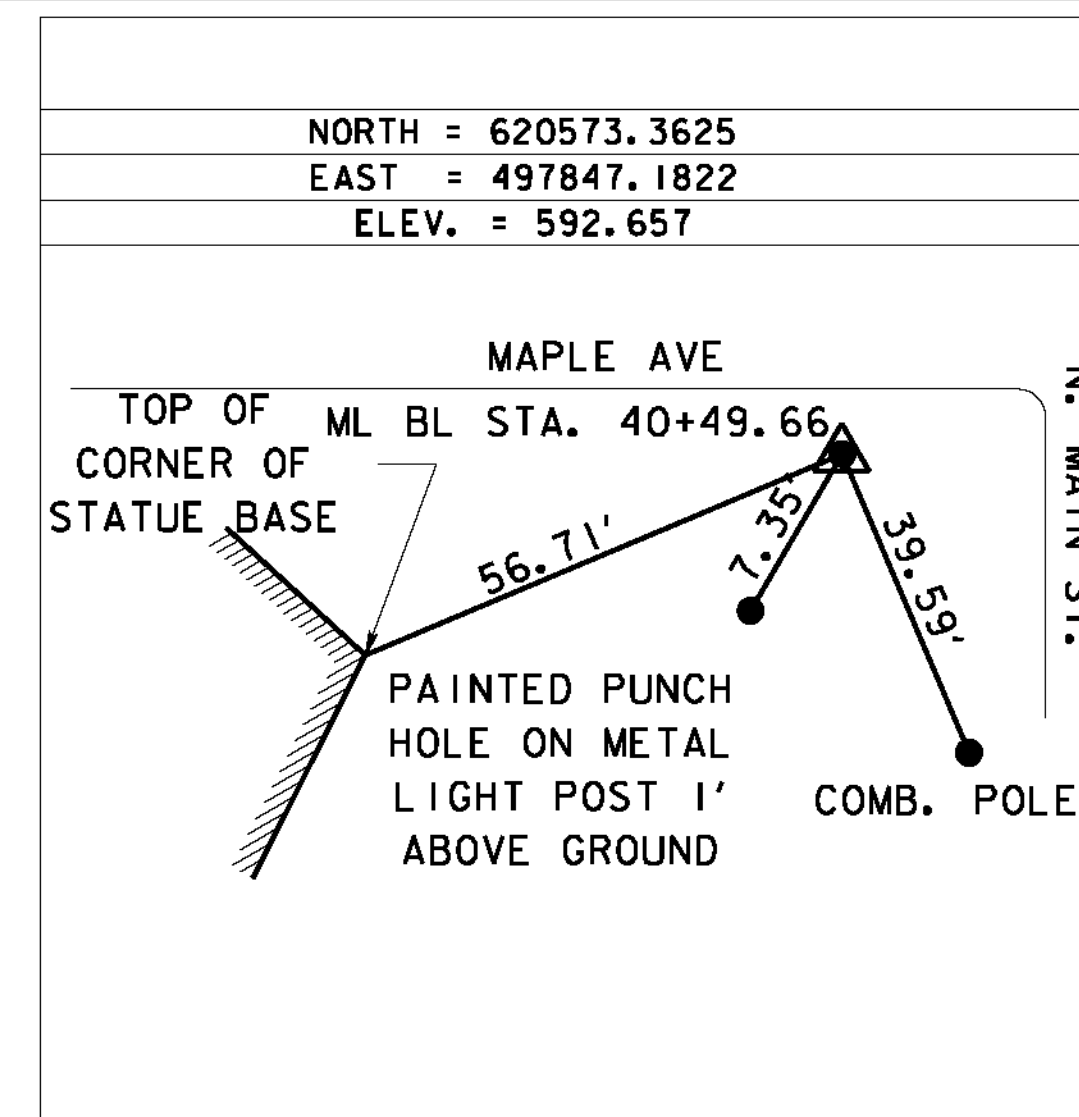


SURVEY TIES

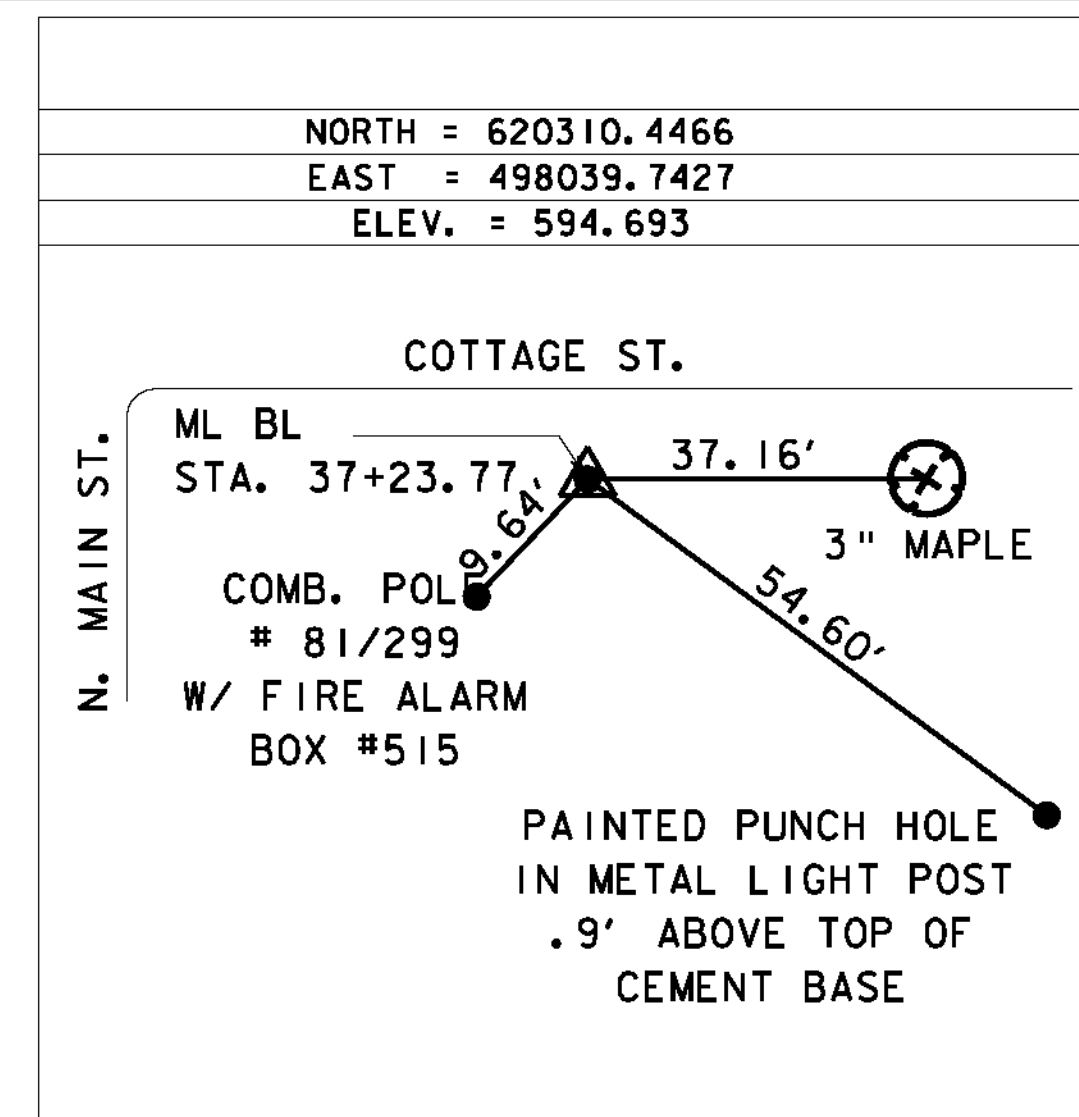

SURVEY TIES

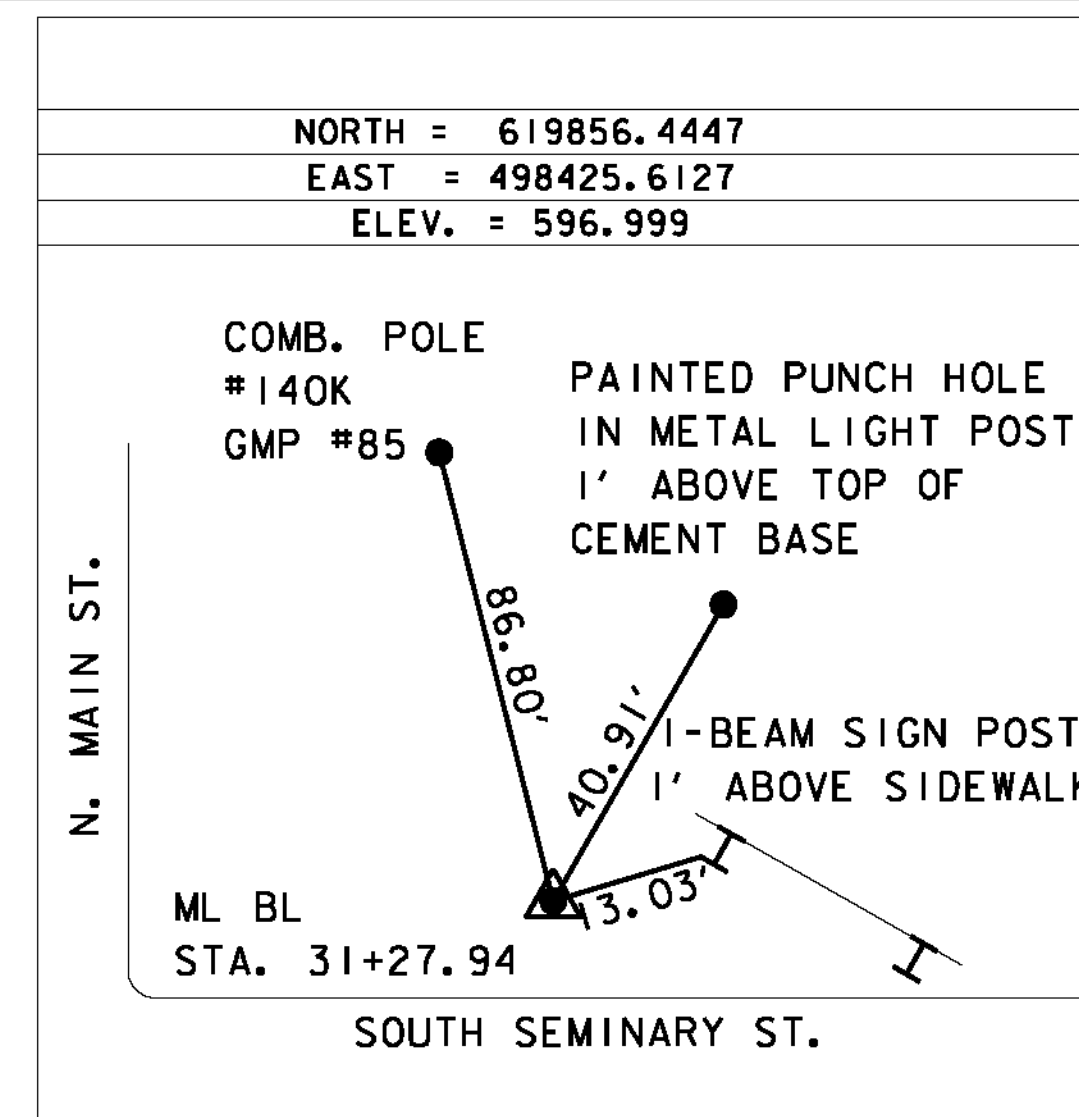

DATUM
VERTICAL NAVD 1929
HORIZONTAL NAD 27

VHB Vanasse Hangen Brustlin, Inc.

PROJECT NAME: BARRE CITY
PROJECT NUMBER: FECC F 026-1(34) C/2
FILE NAME: 85b010_TIES.C2
PROJECT LEADER: G. BAKOS
DESIGNED BY: DMP / MDS
SURVEY TIES
PLOT DATE: 3/9/2011
DRAWN BY: DMP / JAR
CHECKED BY:
SHEET 27 OF 339