


- | | | | |
|---|---------------------------------------|---|-----------------------------|
| ■ | PROPOSED GRANITE POST AND CHAIN FENCE | ● | PROPOSED TRASH RECEPTACLE |
| * | PROPOSED ORNAMENTAL STREET LIGHT | ○ | PROPOSED PARKING METER POST |
| ⬮ | PROPOSED SIGNAL POLE WITH LUMINAIRE | ⊗ | PROPOSED TREE LOCATION |
| ⊕ | BORING/AUGER LOCATIONS | ⊠ | 4' x 5' PROPOSED TREE PIT |
| | | ⊙ | PROPOSED FIRE HYDRANT |



ADJUST ELEVATION OF VALVE BOX
 SL STA 702+63, RT
 SL STA 703+17, RT

COLD PLANING & BITUMINOUS PAVEMENT
 SL STA 701+50 - 705+75

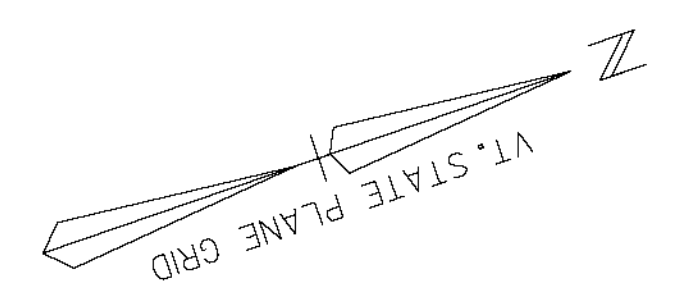

VHB Vanasse Hangen Brustlin, Inc.

PROJECT NAME: BARRE CITY	PLOT DATE: 3/9/2011
PROJECT NUMBER: FECC F 026-(134) C/2	DRAWN BY: D. PECK
FILE NAME: z85b010bdr_cp_C2	CHECKED BY:
PROJECT LEADER: G. BAKOS	SHEET 68 OF 339
DESIGNED BY: D. PECK	
GENERAL PLAN #13	