


**NOTE:**

THE ELEVATIONS SHOWN TO THE NEAREST TENTH ARE THE OLD GROUND ALONG CENTERLINE. THE ELEVATIONS SHOWN TO THE NEAREST HUNDREDTH ARE THE PROPOSED FINISHED GRADE ALONG CENTERLINE.

DATUM	
VERTICAL	NAVD 1929
HORIZONTAL	NAD 27

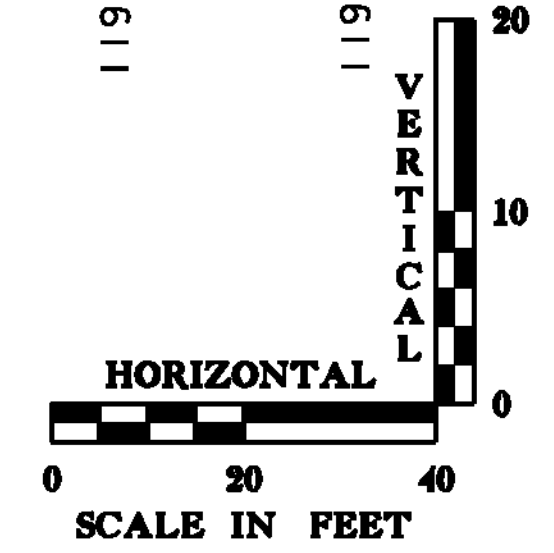

PROJECT NAME:	BARRE CITY	FILE NAME:	85b010_PROJ_C2	PLOT DATE:	3/9/2011
PROJECT NUMBER:	FEGC F 026-(134) C/2	PROJECT LEADER:	G. BAKOS	DRAWN BY:	DMP / JAR
		DESIGNED BY:	DMP / MDS	CHECKED BY:	
		PROFILE - NORTH MAIN STREET		SHEET 69	OF 339