


NOTE:
THE ELEVATIONS SHOWN TO THE NEAREST TENTH ARE THE OLD GROUND ALONG CENTERLINE. THE ELEVATIONS SHOWN TO THE NEAREST HUNDREDTH ARE THE PROPOSED FINISHED GRADE ALONG CENTERLINE.

DATUM
VERTICAL NAVD 1929
HORIZONTAL NAD 27

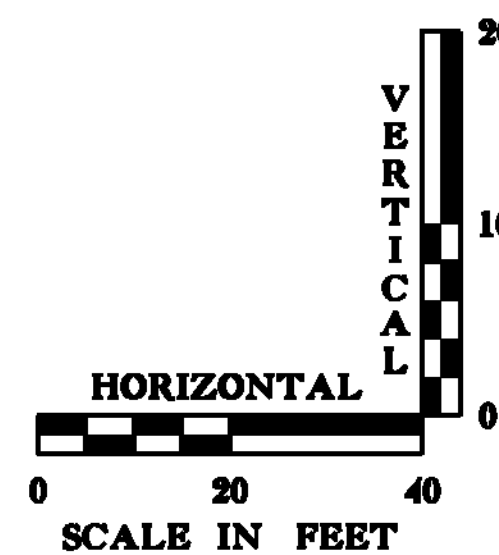

PROJECT NAME: BARRE CITY
PROJECT NUMBER: FEGC F 026-(134) C/2
FILE NAME: 85b010_PRO6_C2
PROJECT LEADER: G. BAKOS
DESIGNED BY: DMP / MDS
PROFILES - SIDE ROADS *2
PLOT DATE: 3/9/2011
DRAWN BY: DMP / JAR
CHECKED BY:
SHEET 74 OF 339