


DRAINAGE RUN 36 TO 74

DATUM
VERTICAL NAVD 1929
HORIZONTAL NAD 27



NOTE:
INFORMATION REGARDING ROOF DRAINS IS NOT DISPLAYED ON THESE SHEETS. SEE ROOF DRAIN PROFILES.

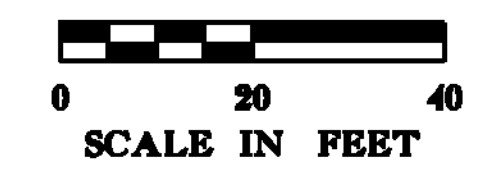

SOUTH SEMINARY ST. TO VT ROUTE 62

PROJECT NAME: BARRE CITY	PROJECT NUMBER: FEGC F 026-1(34) C/2
FILE NAME: 85b010_PROJ_C2	PLOT DATE: 3/9/2011
DESIGNED BY: DMP / MDS	DRAWN BY: DMP / JAR
DRAINAGE PROFILES	CHECKED BY:
	SHEET 75 OF 339