


DATUM
 VERTICAL: NAVD 1929
 HORIZONTAL: NAD 27

DRAINAGE RUN 86 TO 7

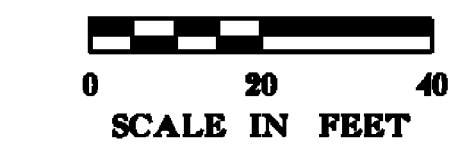

NOTE:
 INFORMATION REGARDING ROOF DRAINS IS NOT DISPLAYED ON THESE SHEETS. SEE ROOF DRAIN PROFILES.

VHB Vanasse Hangen Brustlin, Inc.

PROJECT NAME:	BARRE CITY	PLOT DATE:	3/9/2011
PROJECT NUMBER:	FEGC F 026-(K34) C/2	DRAWN BY:	DMP / JAR
FILE NAME:	85b010_PROJ.C2	CHECKED BY:	
PROJECT LEADER:	G. BAKOS	DRAINAGE PROFILES	SHEET 76 OF 339
DESIGNED BY:	DMP / MDS		