

DECIDUOUS TREES
 STA 123+58 LT
 STA 124+12 RT
 STA 124+05 LT
 STA 124+63 RT
 STA 124+79 LT
 STA 125+35 LT
 STA 125+75 RT
 STA 126+64 RT
 STA 127+75 RT
 STA 127+60 LT
 STA 128+22 RT
 STA 128+40 LT
 STA 128+88 RT
 STA 129+50 RT

SPECIAL PROVISION (STEEL BENCH WITHOUT BACK)
 STA 126+10 RT

SPECIAL PROVISION (STEEL BENCH WITH BACK)
 STA 126+80 LT

SPECIAL PROVISION (TRASH RECEPTACLE)
 STA 123+77 RT
 STA 125+39 LT
 STA 126+69 RT
 STA 126+78 LT
 STA 128+09 RT
 STA 129+23 LT

SPECIAL PROVISION (GRANITE POST AND CHAIN FENCE)
 STA 124+22 - 124+81 RT
 STA 125+61 - 125+79 LT
 STA 126+69 - 126+87 LT
 STA 129+59 - 129+75 LT

SPECIAL PROVISION (BICYCLE RACK)
 STA 123+34 RT
 STA 126+75 RT
 STA 128+66 LT
 STA 129+24 RT

REMOVING MEDIUM TREES
 STA 124+79 RT
 STA 125+18 LT
 STA 128+01 RT

TREE PROTECTION ZONE/TPZ
 STA 125+28 - 125+35 RT
 STA 125+41 - 126+17 RT
 STA 126+04 - 126+37 LT
 STA 126+17 - 126+23 RT
 STA 126+90 LT - SL STA 61+11 LT

LEGEND:

	EXISTING MEDIUM OR LARGE TREE OR STUMP TO BE REMOVED		PROPOSED GRANITE POST AND CHAIN FENCE
	PROPOSED DECIDUOUS TREE (OUTSIDE OF SIDEWALK)		PROPOSED ORNAMENTAL STREET LIGHT
	PROPOSED DECIDUOUS TREE WITH 4' x 5' TREE PIT		TREE PROTECTION ZONE / TPZ
	PROPOSED SHRUB		PROPOSED STEEL BENCH WITH BACK
	COBBLESTONE PAVERS		PROPOSED STEEL BENCH WITHOUT BACK
	IMPRINTED 5" CONCRETE SIDEWALK		PROPOSED PARKING METER POST
	CU STRUCTURAL SOIL		PROPOSED TRASH RECEPTACLE
			PROPOSED BICYCLE RACK


SPECIAL PROVISION (CU STRUCTURAL SOIL)
 STA 123+43 - 124+20 LT
 STA 123+97 - 124+83 RT
 STA 124+64 - 124+94 LT
 STA 125+20 - 125+50 LT
 STA 125+60 - 125+90 RT
 STA 126+49 - 126+79 RT
 STA 127+60 - 128+37 RT
 STA 127+45 - 127+75 LT
 STA 128+25 - 128+55 LT
 STA 128+73 - 129+03 RT
 STA 129+35 - 129+65 RT

REMOVING LARGE TREE
 STA 126+95 RT

- NOTES:**
- ALL MUNICIPAL GRANITE BENCHES SHALL BE REMOVED AND RESET BY THE CITY.
 - ALL TREE PROTECTION ZONES SHALL BE PAID AS A LUMP SUM UNDER ITEM 656.85 - TREE PROTECTION.
 - ALL TREES AND NAMED CULTIVARS HAVE BEEN CHECKED AND ALL PATENTS HAVE EXPIRED EXCEPT AS NOTED BELOW **.

SYMBOL	COMMON NAME	BOTANICAL NAME	QTY.	UNIT	SIZE	SPACING / COMMENTS
UAC	ACCOLADE ELM	ULMUS CARPINIFOLIA ACCOLADE	2	B&B	2"-2 1/2" CAL	5' TO 6' MIN. BRANCH HT.
ARA	ARMSTRONG RED MAPLE	ACER RUBRUM "ARMSTRONG"	5	B&B	2"-2 1/2" CAL	5' TO 6' MIN. BRANCH HT.
AFAB	AUTUMN BLAZE MAPLE	ACER FREMANII X AUTUMN BLAZE	2	B&B	2"-2 1/2" CAL	5' TO 6' MIN. BRANCH HT.
QRP	REGAL PRINCE COLUMNAR OAK	QUERCUS RxB. LONG**	4	B&B	2"-2 1/2" CAL	5' TO 6' MIN. BRANCH HT.
GTS	SHADEMASTER HONEYLOCUST	GLEDITSIA TRIACANTHOS INERMIS	1	B&B	2"-2 1/2" CAL	5' TO 6' MIN. BRANCH HT.

** ALL TREES SHALL BE PLANTED IN THE SPRING
 ** ALTERNATIVES FOR REGAL PRINCE COLUMNAR OAK ARE AS FOLLOWS:
 1. CRIMSON SPIRE OAK (QUERCUS ROBUR X Q. ALBA "CRIMSCHMIDT")
 2. BOWHALL MAPLE (ACER RUBRUM "BOWHALL")
 3. KARPICK MAPLE (ACER RUBRUM "KARPICK")

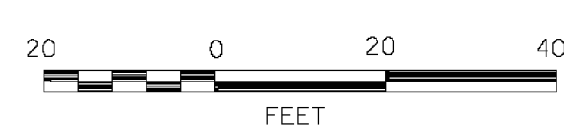

VHB Vanasse Hangen Brustlin, Inc.

PROJECT NAME: BARRE CITY
 PROJECT NUMBER: FECC F 026-(134) C/2
 FILE NAME: z85b010bdr_ld.c2
 PROJECT LEADER: G. BAKOS
 DESIGNED BY: D. PECK
 LANDSCAPING PLAN #3

PLOT DATE: 3/23/2011
 DRAWN BY: D. PECK
 CHECKED BY:
 SHEET 87 OF 339