


SPECIAL PROVISION (CU STRUCTURAL SOIL)
 STA 136+02 - 136+32 LT
 STA 136+07 - 136+37 RT
 STA 137+18 - 137+48 RT
 STA 137+20 - 137+50 LT
 STA 137+76 - 138+03 RT
 STA 137+95 - 138+25 LT
 STA 138+25 - 138+46 RT
 SL STA 600+79 - 601+00 RT
 SL STA 601+29 - 601+57 RT

TREE PROTECTION ZONE/TPZ
 STA 138+40 - 138+85 RT

REMOVING MEDIUM TREES
 STA 136+42 RT

DECIDUOUS TREES
 STA 136+17 LT
 STA 136+22 RT
 STA 137+33 RT
 STA 137+35 LT
 STA 138+10 LT
 STA 138+39 RT
 SL STA 600+87 RT
 SL STA 601+42 RT

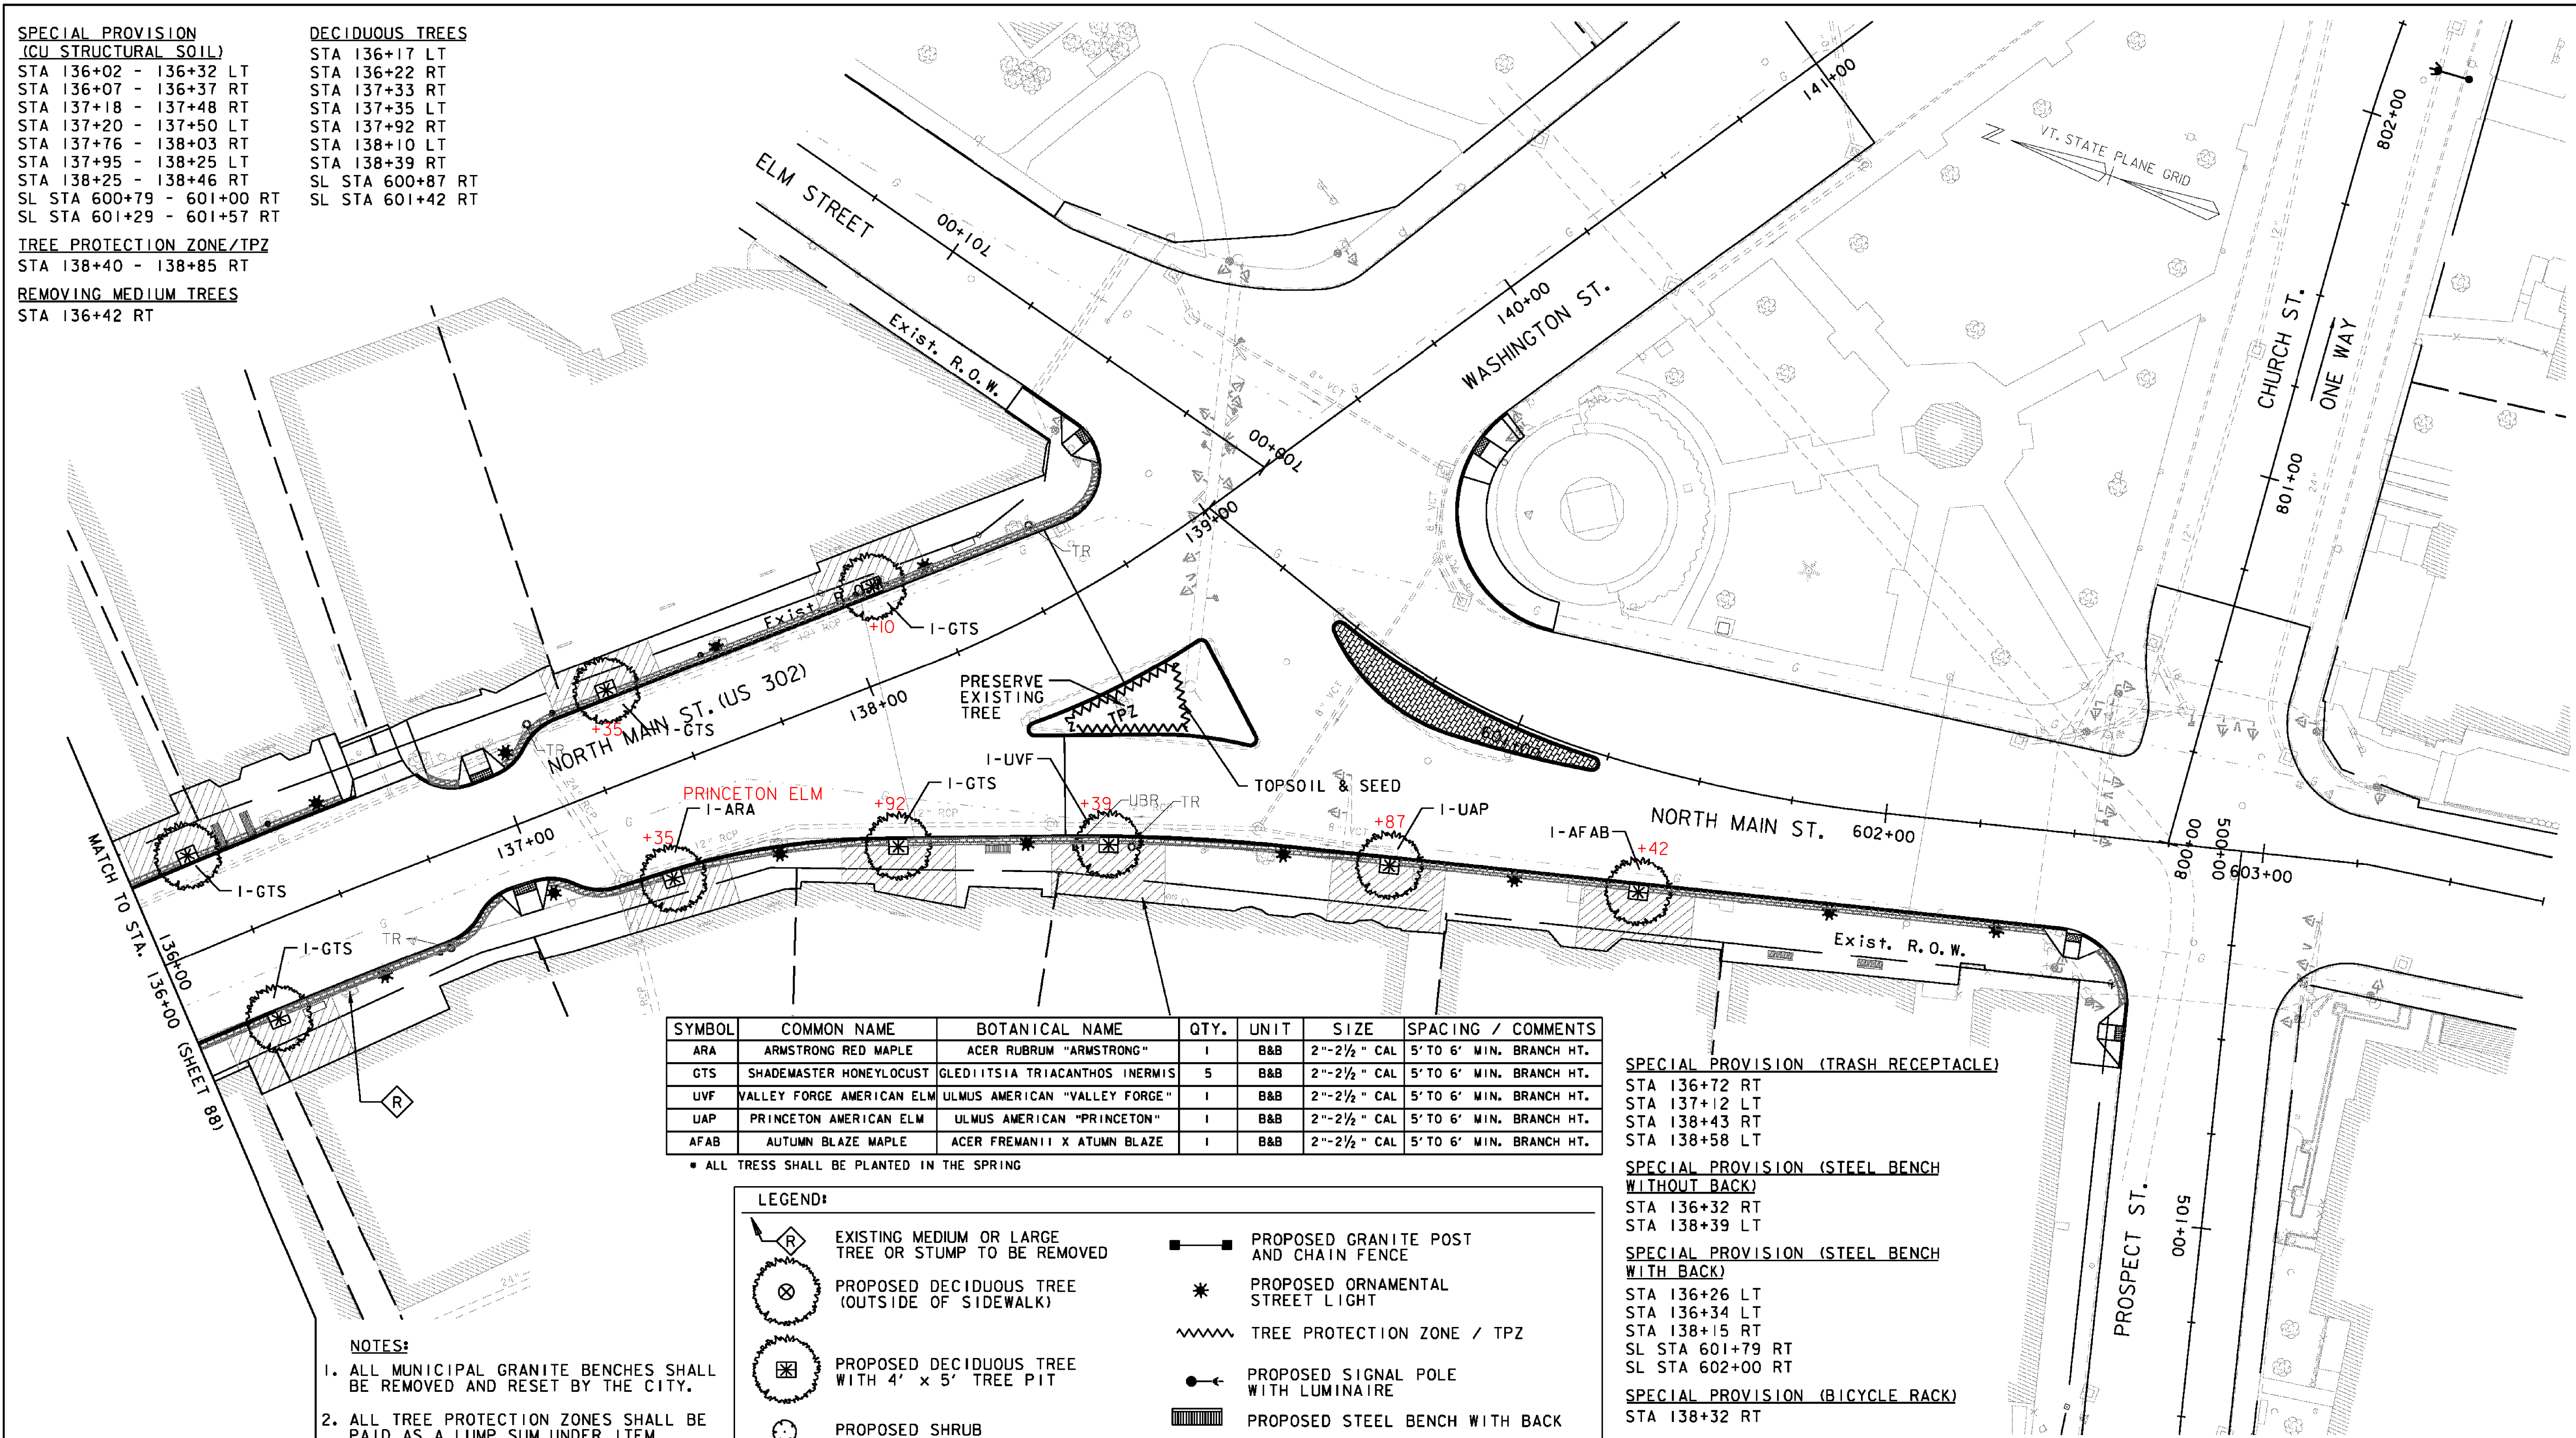

SYMBOL	COMMON NAME	BOTANICAL NAME	QTY.	UNIT	SIZE	SPACING / COMMENTS
ARA	ARMSTRONG RED MAPLE	ACER RUBRUM "ARMSTRONG"	1	B&B	2"-2 1/2" CAL	5' TO 6' MIN. BRANCH HT.
GTS	SHADEMASTER HONEYLOCUST	GLEDIITSIA TRIACANTHOS INERMIS	5	B&B	2"-2 1/2" CAL	5' TO 6' MIN. BRANCH HT.
UVF	VALLEY FORGE AMERICAN ELM	ULMUS AMERICAN "VALLEY FORGE"	1	B&B	2"-2 1/2" CAL	5' TO 6' MIN. BRANCH HT.
UAP	PRINCETON AMERICAN ELM	ULMUS AMERICAN "PRINCETON"	1	B&B	2"-2 1/2" CAL	5' TO 6' MIN. BRANCH HT.
AFAB	AUTUMN BLAZE MAPLE	ACER FREMANII X ATUMN BLAZE	1	B&B	2"-2 1/2" CAL	5' TO 6' MIN. BRANCH HT.

* ALL TREES SHALL BE PLANTED IN THE SPRING

LEGEND:

	EXISTING MEDIUM OR LARGE TREE OR STUMP TO BE REMOVED		PROPOSED GRANITE POST AND CHAIN FENCE
	PROPOSED DECIDUOUS TREE (OUTSIDE OF SIDEWALK)		PROPOSED ORNAMENTAL STREET LIGHT
	PROPOSED DECIDUOUS TREE WITH 4' x 5' TREE PIT		TREE PROTECTION ZONE / TPZ
	PROPOSED SHRUB		PROPOSED SIGNAL POLE WITH LUMINAIRE
	COBBLESTONE PAVERS		PROPOSED STEEL BENCH WITH BACK
	IMPRINTED 5" CONCRETE SIDEWALK		PROPOSED STEEL BENCH WITHOUT BACK
	CU STRUCTURAL SOIL		PROPOSED PARKING METER POST
			PROPOSED TRASH RECEPTACLE
			PROPOSED BICYCLE RACK

NOTES:


- ALL MUNICIPAL GRANITE BENCHES SHALL BE REMOVED AND RESET BY THE CITY.
- ALL TREE PROTECTION ZONES SHALL BE PAID AS A LUMP SUM UNDER ITEM 656.85 - TREE PROTECTION.
- ALL TREES AND NAMED CULTIVARS HAVE BEEN CHECKED AND ALL PATENTS HAVE EXPIRED.

SPECIAL PROVISION (TRASH RECEPTACLE)
 STA 136+72 RT
 STA 137+12 LT
 STA 138+43 RT
 STA 138+58 LT

SPECIAL PROVISION (STEEL BENCH WITHOUT BACK)
 STA 136+32 RT
 STA 138+39 LT

SPECIAL PROVISION (STEEL BENCH WITH BACK)
 STA 136+26 LT
 STA 136+34 LT
 STA 138+15 RT
 SL STA 601+79 RT
 SL STA 602+00 RT

SPECIAL PROVISION (BICYCLE RACK)
 STA 138+32 RT

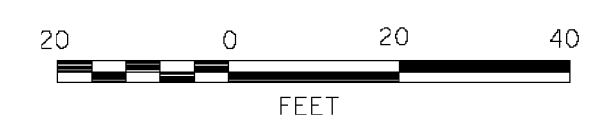

VHB Vanasse Hangen Brustlin, Inc.

PROJECT NAME: BARRE CITY
 PROJECT NUMBER: FECC F 026-(K34) C/2
 FILE NAME: z85b010bdr_ld_c2
 PROJECT LEADER: G. BAKOS
 DESIGNED BY: D. PECK
 LANDSCAPING PLAN #5

PLOT DATE: 3/9/2011
 DRAWN BY: D. PECK
 CHECKED BY:
 SHEET 89 OF 339