

BY JGC IN ORDER TO MEET END OF CURB


QUANTITY COMBINED

4 INCH WHITE LINE WITH PREVIOUS SHEET	
STA 129+75 - 129+88 RT (PARKING LANES)	
STA 129+75 - 130+59 LT (PARKING LANES)	130'
STA 131+06 - 132+56 RT (PARKING LANES)	
STA 131+28 - 132+34 LT (PARKING LANES)	
STA 133+03 - 134+11 LT (PARKING LANES)	
STA 133+06 - 133+72 RT (PARKING LANES)	
STA 133+94 - 135+04 RT (PARKING LANES)	
STA 134+11 - 134+33 LT (NO PARKING ZONE)	
STA 134+33 - 134+75 LT (BUS PARKING)	
STA 135+53 - 135+95 RT (PARKING LANES)	
STA 135+53 - 136+00 LT (PARKING LANES)	
STA 135+95 - 136+00 RT (NO PARKING ZONE)	
SL STA 80+35 - 80+66 RT (NO PARKING ZONE)	
SL STA 80+40 - 80+63 LT (NO PARKING ZONE)	
SL STA 80+63 - 81+03 LT (PARKING LANES)	
SL STA 80+66 - 81+06 RT (PARKING LANES)	
80+64	81+04
4 INCH YELLOW LINE	
STA 129+75 - 130+01 CL (DOUBLE)	
STA 130+87 - 132+76 CL (DOUBLE)	
STA 132+84 - 135+25 CL (DOUBLE)	
STA 135+33 - 136+00 CL (DOUBLE)	
SL STA 80+38 - 81+85 CL (DOUBLE)	

24 INCH STOP BAR	
SL STA 80+38 LT	
CROSSWALK MARKING	
STA 130+83 LT-RT	
STA 132+80 LT-RT	
STA 135+29 LT-RT	
SL STA 80+30 LT-RT	
SL STA 90+30 LT-RT	
SL STA 200+30 LT-RT	
REMOVING SIGNS (TYPE A)	
STA 129+99 RT	
STA 130+11 LT	
STA 130+72 RT (3 SIGNS)	
STA 130+79 LT	
STA 132+28 RT	
STA 132+40 LT (4 SIGNS)	
STA 134+47 LT	
STA 134+82 RT	
STA 134+83 LT (3 SIGNS)	
SL STA 80+36 LT	

SPECIAL PROVISION (PARKING METER POSTS) (LT)	SPECIAL PROVISION (PARKING METER POSTS) (RT)
STA 129+95	STA 129+88
STA 130+39	STA 131+26
STA 131+28	STA 131+72
STA 131+70	STA 132+14
STA 132+14	STA 132+56
STA 133+03	STA 133+29
STA 133+45	STA 133+72
STA 133+89	STA 134+17
STA 135+53	STA 134+60
STA 135+95	STA 135+04
SL STA 80+83	STA 135+73
	SL STA 80+86
	80+84
ERECTING SALVAGED SIGNS	
STA 130+00 RT (2 SIGNS)	

SIGNING LEGEND	STRIPING LEGEND
N = NEW	SWL = SINGLE WHITE LINE
R = REMOVE	SYL = SINGLE YELLOW LINE
R&S = REMOVE AND SALVAGE	DYL = DOUBLE YELLOW LINE
RET = RETAIN	SDL = SINGLE DASHED LINE
S = SALVAGED SIGN	SBL = SINGLE BROKEN LINE
B-B = BACK TO BACK	
OH = OVERHEAD SIGN	

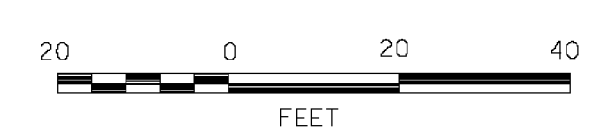

VHB Vanasse Hangen Brustlin, Inc.

PROJECT NAME: BARRE CITY	PLOT DATE: 3/9/2011
PROJECT NUMBER: FECC-F 026-1(34) C/2	DRAWN BY: D. PECK
FILE NAME: z85b010bdr_spm.C2	CHECKED BY:
PROJECT LEADER: G. BAKOS	SIGNS AND PAVEMENT MARKING PLANS #4
DESIGNED BY: D. PECK	SHEET 99 OF 339