

NOTE: YIELD SIGNS, CROSSBUCKS, AND SUPPORT TO BE INSTALLED IN ACCORDANCE WITH MUTCD FIGURE 8B-2 FOR POSITION, REFLECTIVE STRIP ON SUPPORT POST, AND MOUNTING HEIGHT.

REMOVING SIGNS (TYPE A)

- SL STA 12+36 RT
- SL STA 12+95 LT

4 INCH WHITE LINE

- SL STA 11+75 - 12+65 LT
- SL STA 11+75 - 12+48 LT
- SL STA 11+75 - 12+44 RT (DASHED)
- SL STA 11+75 - 12+64 RT

4 INCH YELLOW LINE

- SL STA 11+75 - 12+65 LT
- SL STA 11+75 - 12+65 RT

LETTER OR SYMBOL

- SL STA 12+35 LT (RIGHT ARROW)
- SL STA 12+35 LT (LEFT/THRU)


SIGNING LEGEND

- N = NEW
- R = REMOVE
- R&S = REMOVE AND SALVAGE
- RET = RETAIN
- S = SALVAGED SIGN
- B-B = BACK TO BACK
- OH = OVERHEAD SIGN

STRIPING LEGEND

- SWL = SINGLE WHITE LINE
- SYL = SINGLE YELLOW LINE
- DYL = DOUBLE YELLOW LINE
- SDL = SINGLE DASHED LINE
- SBL = SINGLE BROKEN LINE

MATCH TO STA. 11+75 (SHEET 96)

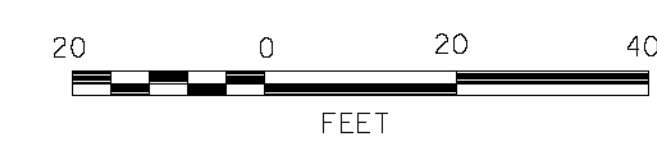

VHB Vanasse Hangen Brustlin, Inc.

PROJECT NAME: BARRE CITY	PROJECT NUMBER: FEGC-F 026-1(34) C/2
FILE NAME: z85b010bdr_spm_C2	PLOT DATE: 3/9/2011
PROJECT LEADER: G. BAKOS	DRAWN BY: D. PECK
DESIGNED BY: D. PECK	CHECKED BY:
SIGNS AND PAVEMENT MARKING PLANS #8	SHEET 103 OF 339