

SMH 4
STA: 116+57.48 OFF: -1.88L
RIM: 584.38

INV OUT: 583.90 30"
INV IN: 584.00 30"
INV IN: 584.00 6"
INV IN: 584.00 6"

SMH 1
STA: 110+73.07 OFF: -4.03L
RIM: 592.04

SMH 2
STA: 101+92.97 OFF: -7.59L
RIM: 591.98

INV OUT: 583.30 24"
INV IN: 583.35 30"
INV OUT: 583.40 30"
INV IN: 583.40 (2) 24"

SMH 3
STA: 114+38.96 OFF: -1.32L
RIM: 593.80

INV OUT: 583.68 (2) 24"
INV IN: 583.78 30"
INV IN: 583.80 8"

SMH 5
STA: 120+80.14 OFF: -4.35L
RIM: 585.76


INV OUT: 584.40 30"
INV IN: 584.50 30"
INV IN: 585.30 8"

SMH 4
STA: 116+57.48 OFF: -1.88L
RIM: 594.38

INV OUT: 583.90 30"
INV IN: 584.00 30"
INV IN: 584.00 6"
INV IN: 584.00 6"

SMH 6
STA: 122+88.10 OFF: -6.50L
RIM: 586.80

INV OUT: 584.70 30"
INV IN: 584.80 30"
INV IN: 585.60 12"

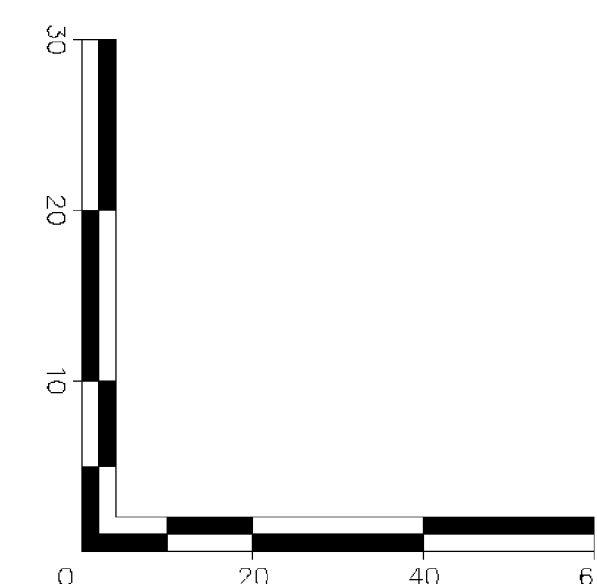

- NOTES:**
- SEE SHEET 133 FOR GENERAL NOTES, LEGEND, AND ABBREVIATIONS.
 - STATIONING SHOWN HEREON IS BASED ON ROAD CENTERLINE AS PER VTRANS REQUIREMENTS AND MAY NOT REFLECT PROPER PIPE LENGTHS
 - SEE SHEETS 134-138 FOR PLAN INFORMATION.
 - SEE SHEETS 144-149 FOR SEWER SERVICE PROFILES.
 - SEE SHEETS 150 AND 154 FOR DETAILS



PROJECT NAME: BARRE CITY	PLOT DATE: Feb. 18, 11
PROJECT NUMBER: FEFG F 026-1(34) C/2	DRAWN BY: B.L. BAKER
FILE NAME: 717014-PROFILES	CHECKED BY: C.L. WHITHEAD
DESIGNED BY: B.L. BAKER	SHEET 139 OF 339
SANITARY SEWER PROFILES	