
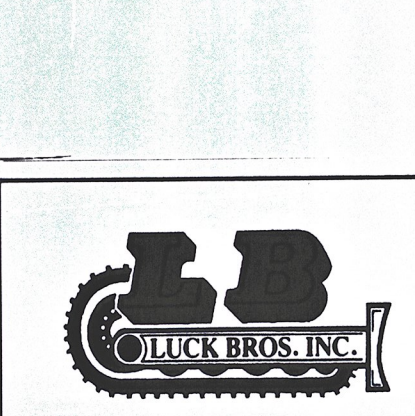


INV. OUT 24" = 585.80
INV. IN 24" = 586.80
INV. IN 12" = 585.80

INV. OUT 24" = 586.10
INV. IN 24" = 586.18
INV. IN 12" = 586.18
INV. IN 6" = 587.00

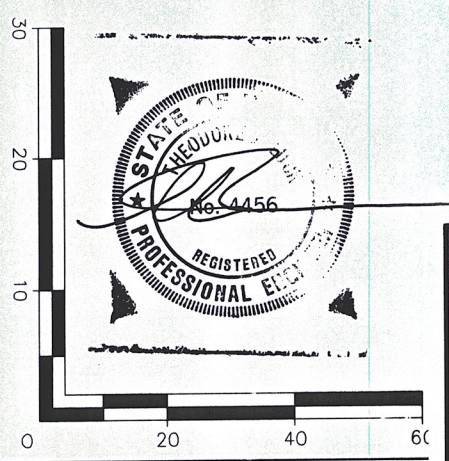

PROJECT NAME: BARRE CITY
PROJECT NUMBER: FECC F 026-134) C/2
FILE NAME: SAN PROFILES
MANAGER: J. LUCK
DRAWN BY: C. KEMPNEY

NOTES / REVISIONS	
ISSUED:	2/7/2012

- NOTES:
- SEE SHEET 133 FOR GENERAL NOTES, LEGEND, AND ABBREVIATIONS.
 - STATIONING SHOWN HEREON IS BASED ON ROAD CENTERLINE AS PER VTRANS REQUIREMENTS AND MAY NOT REFLECT PROPER PIPE LENGTHS.
 - SEE SHEETS 134-138 FOR PLAN INFORMATION.
 - SEE SHEETS 144-149 FOR SEWER SERVICE PROFILES.
 - SEE SHEETS 150 AND 154 FOR DETAILS.

PROPOSED REDESIGN SANITARY SEWER PROFILES
Sheet 142 revised