
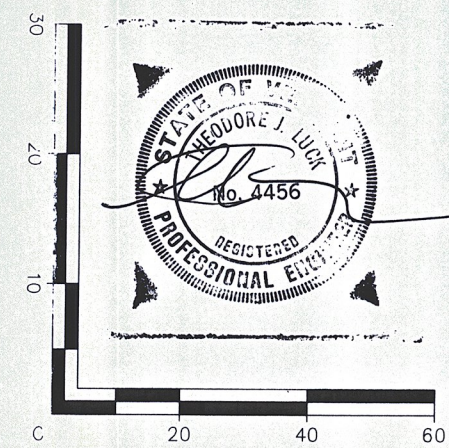
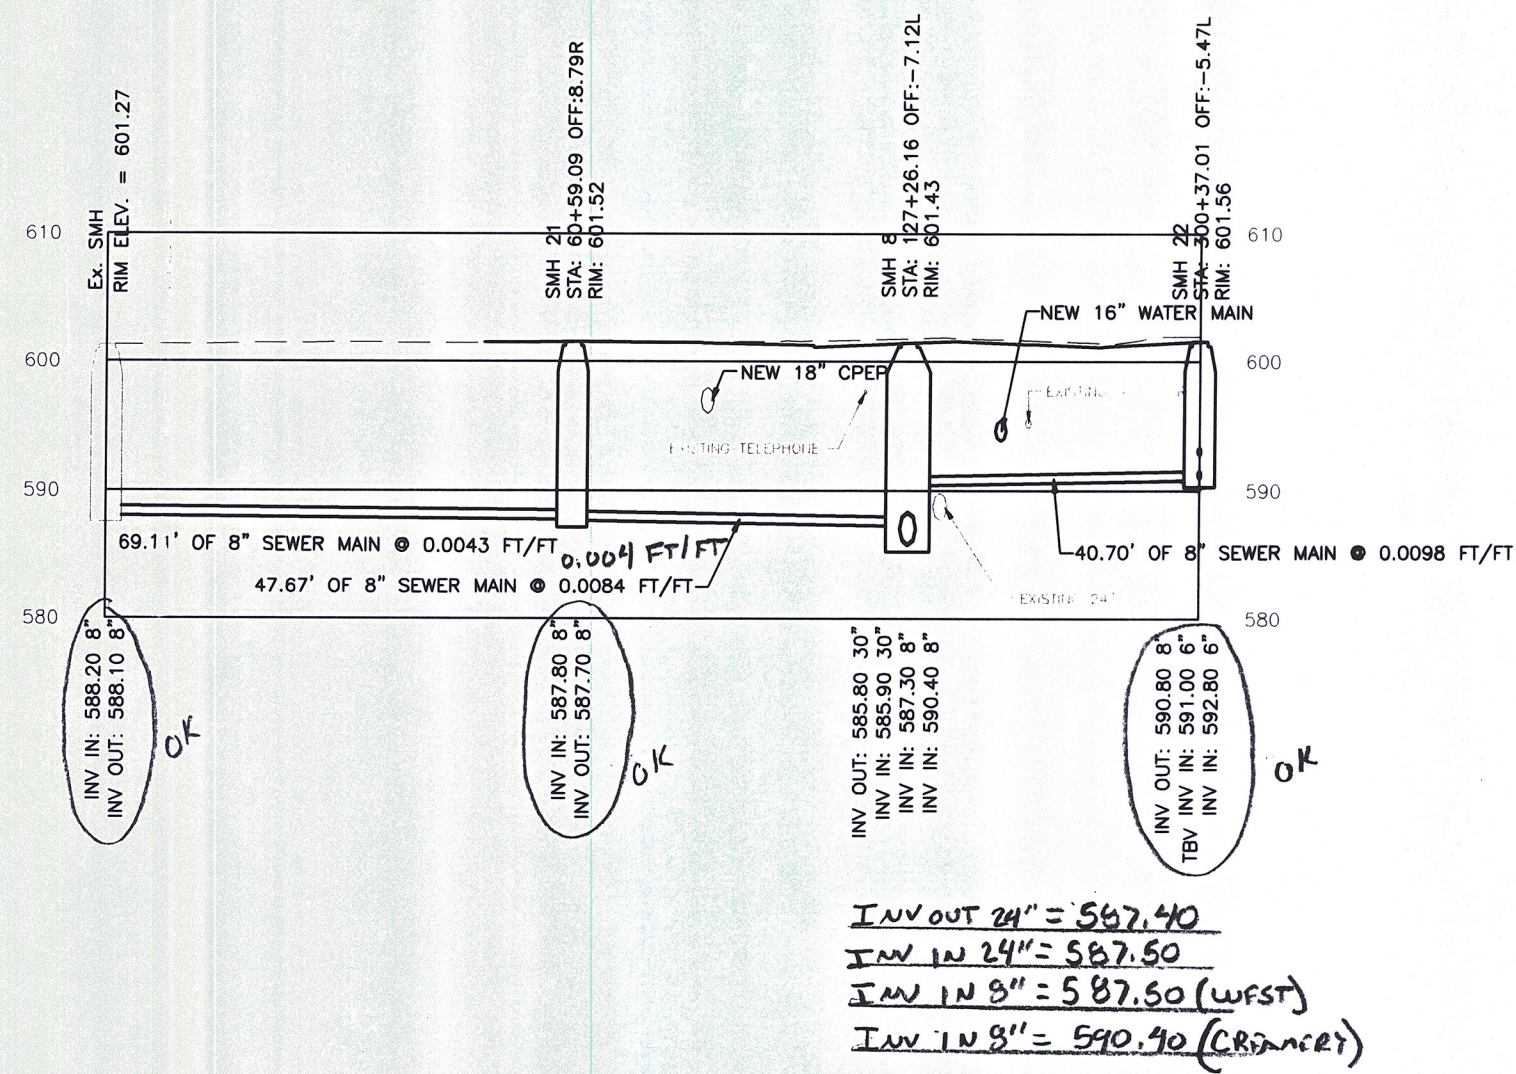


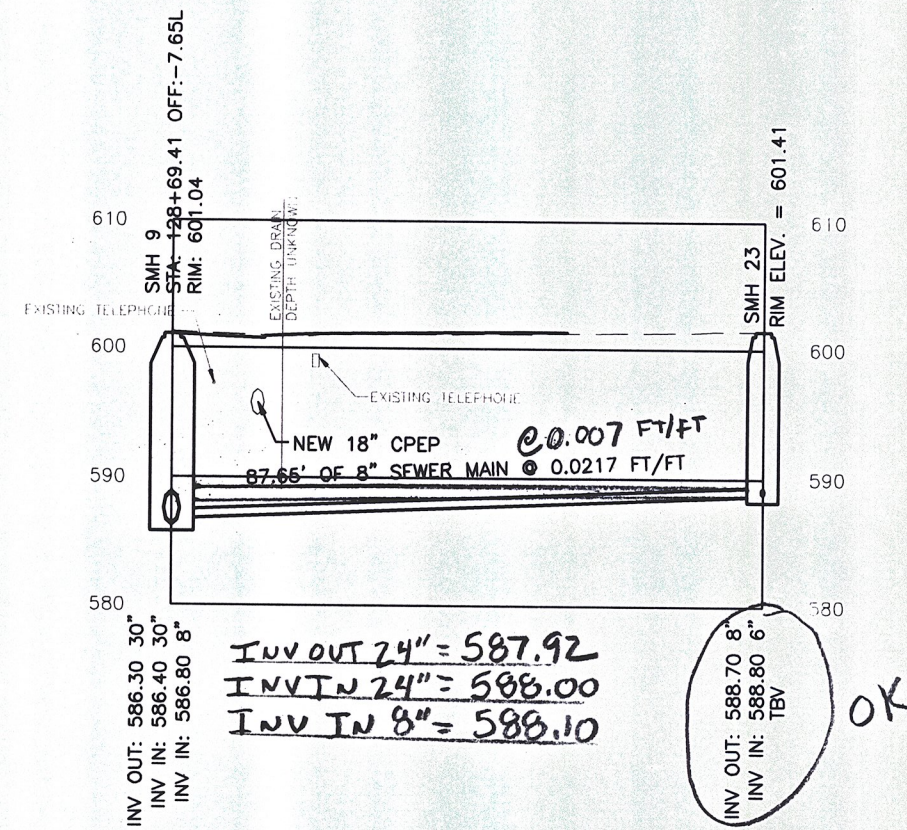

- NOTES:**
- SEE SHEET 133 FOR GENERAL NOTES, LEGEND, AND ABBREVIATIONS.
 - STATIONING SHOWN HEREON IS BASED ON ROAD CENTERLINE AS PER VTRANS REQUIREMENTS AND MAY NOT REFLECT PROPER PIPE LENGTHS.
 - SEE SHEETS 134-138 FOR PLAN INFORMATION.
 - SEE SHEETS 144-149 FOR SEWER SERVICE PROFILES.
 - SEE SHEETS 150 AND 154 FOR DETAILS.

PROJECT NAME:	BARRE CITY	NOTES / REVISIONS
PROJECT NUMBER:	FECC F 026-1(34) C/2	ISSUED: 2/7/2012
FILE NAME:	SAN PROFILES	
MANAGER:	J. LUCK	
DRAWN BY:	C. KEMPNEY	
PROPOSED REDESIGN SANITARY SEWER PROFILES		
Sheet "K3 revised"		