




16 IN. WATER MAIN - NORTH MAIN STREET

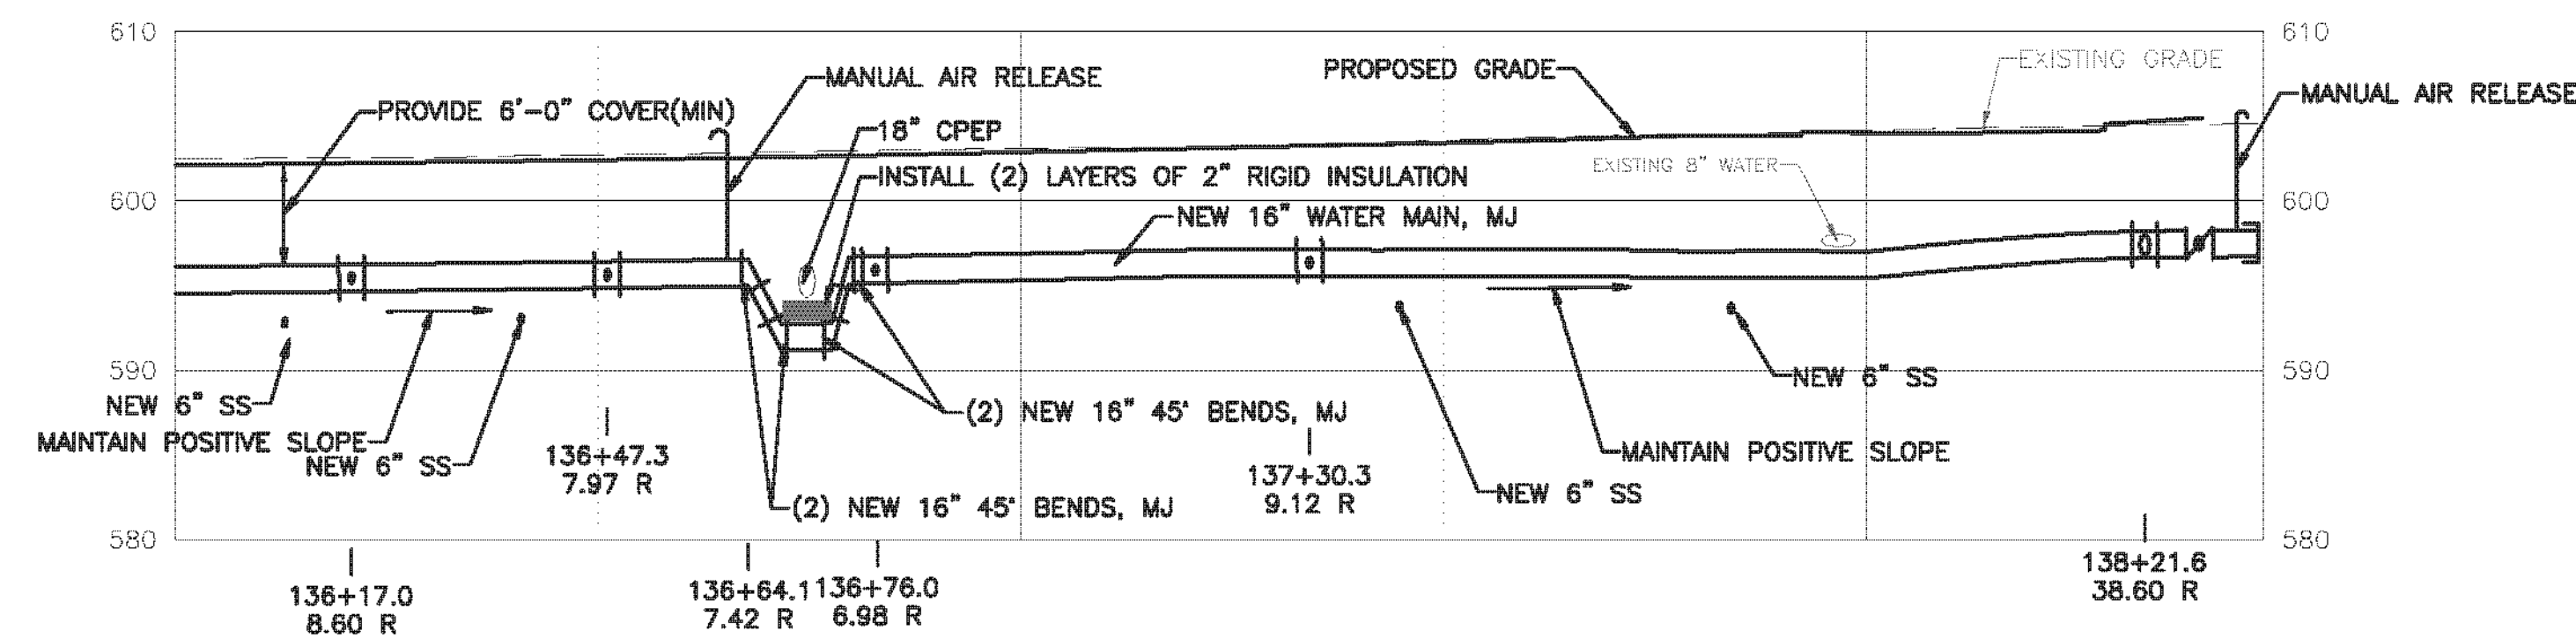


16 IN. WATER MAIN - NORTH MAIN STREET

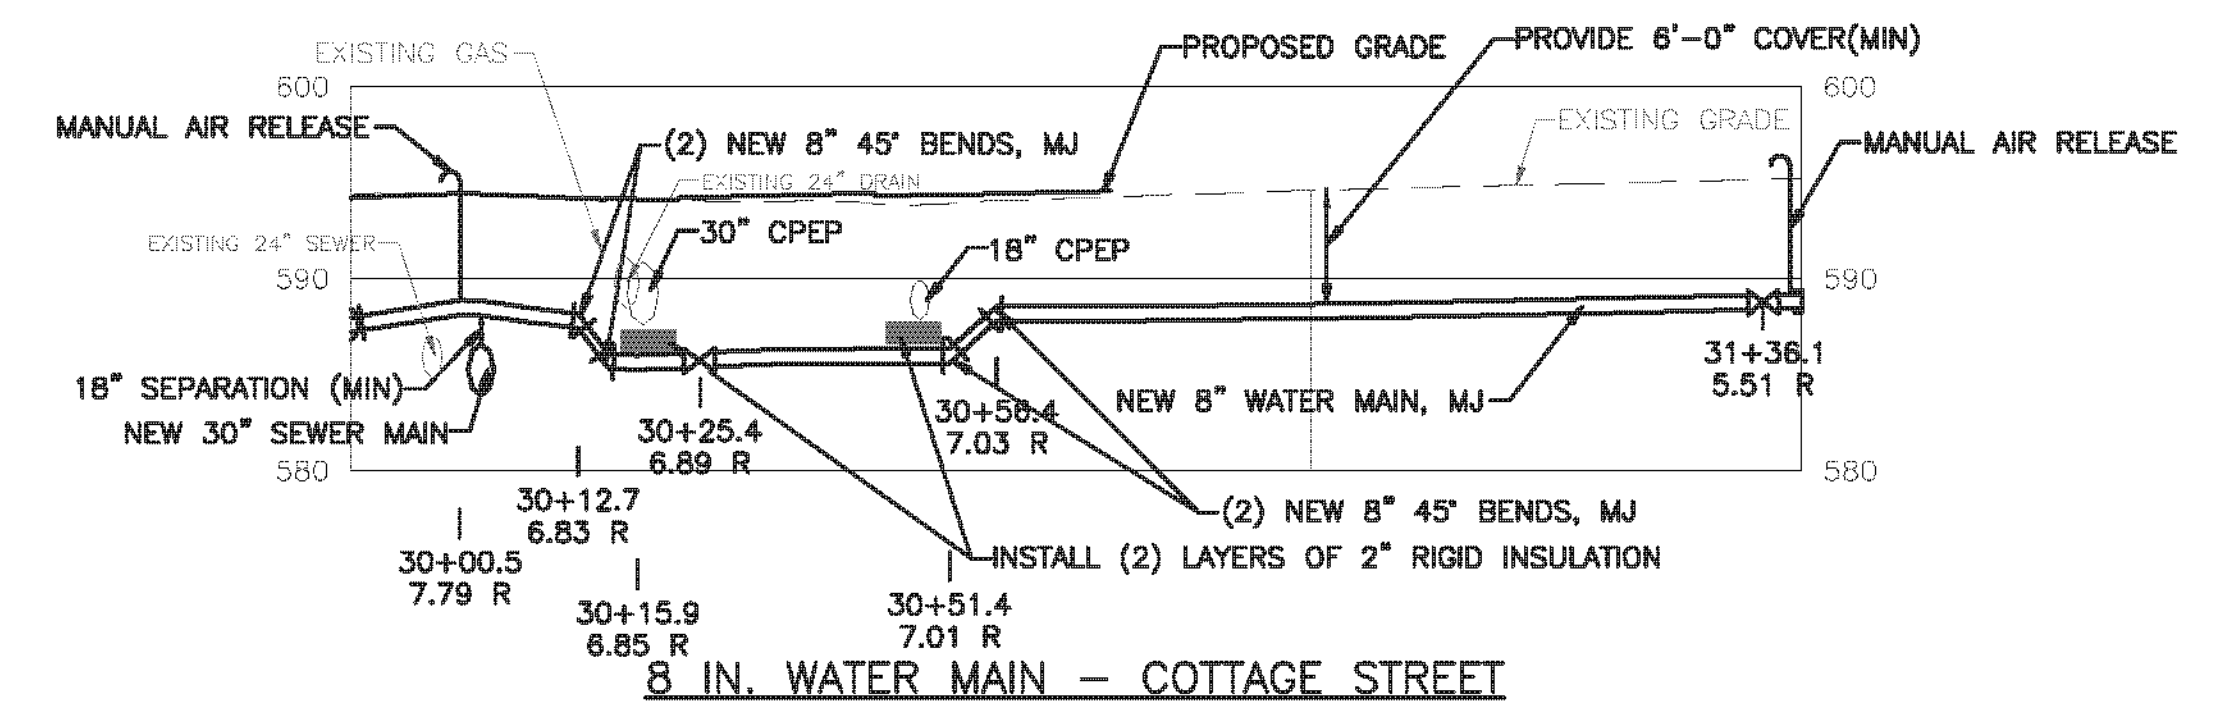


8 IN. WATER MAIN - COTTAGE STREET

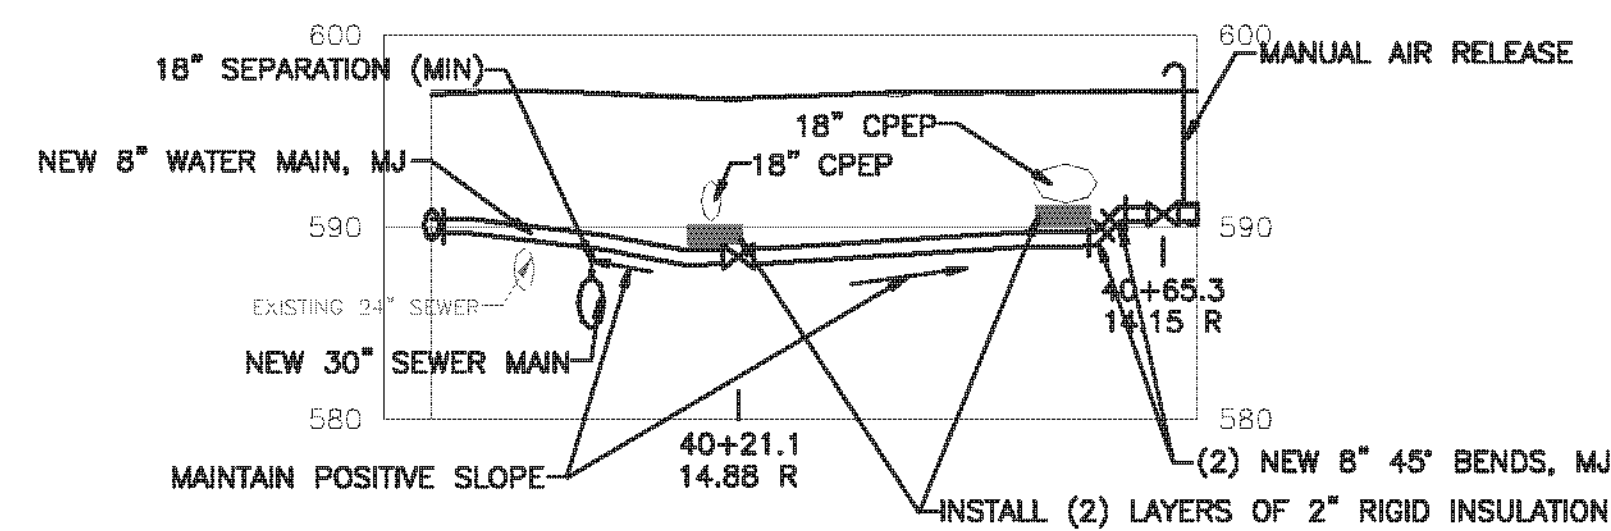

8 IN. WATER MAIN - SOUTH SEMINARY STREET

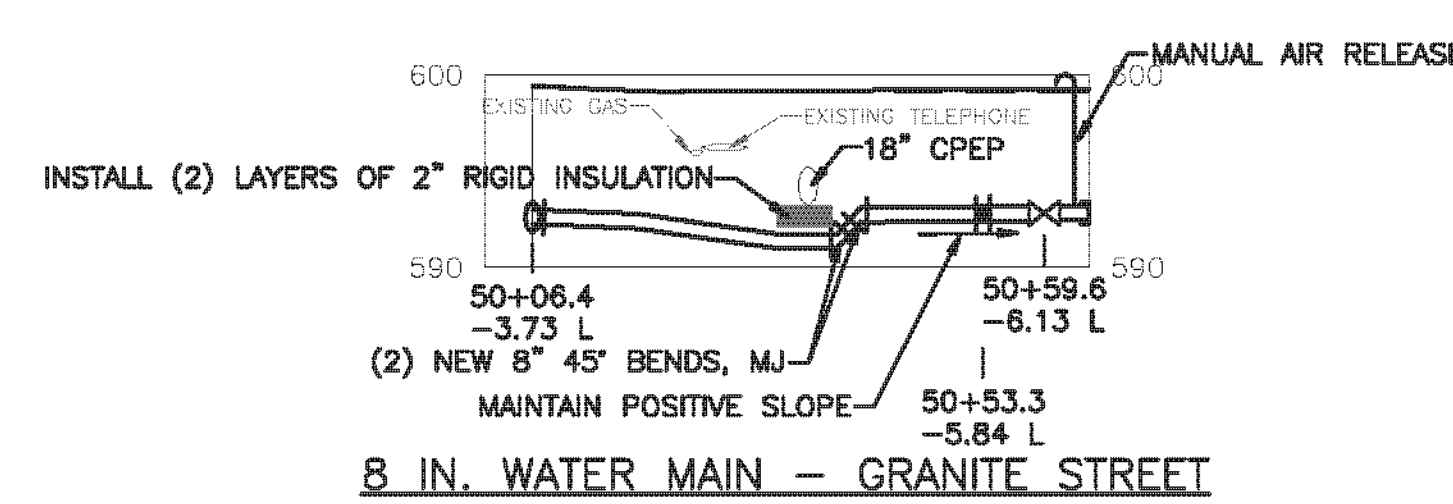

8 IN. WATER MAIN - GRANITE STREET

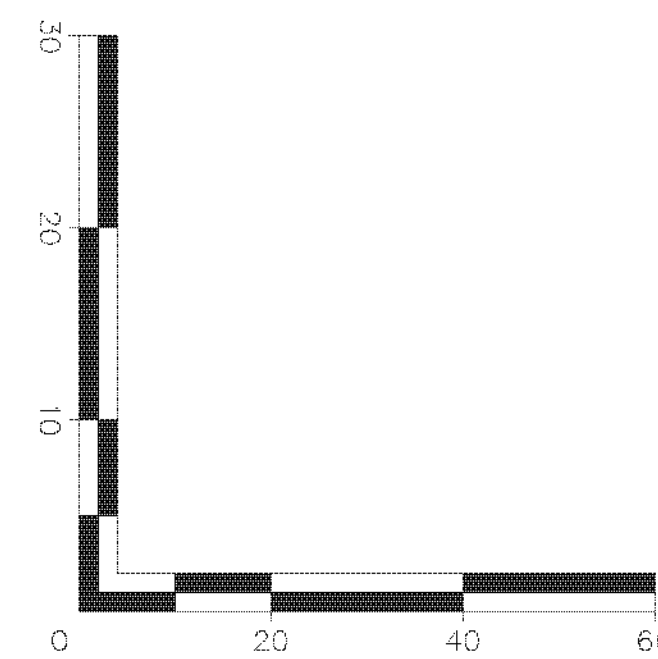

- NOTES:**
- SEE SHEET 133 FOR GENERAL NOTES, LEGEND, AND ABBREVIATIONS.
 - STATIONING SHOWN HEREON IS BASED ON ROAD CENTERLINE AS PER VIRTRANS REQUIREMENTS AND MAY NOT REFLECT PROPER PIPE LENGTHS.
 - SEE SHEETS 134-138 FOR PLAN INFORMATION.
 - SEE SHEETS 150 AND 154 FOR DETAILS.

 DUFRESNE GROUP CONSULTING ENGINEERS *** Dufresne Group is owned by Dufresne & Associates, PC	PROJECT NAME: BARRE CITY PROJECT NUMBER: FEFC F 026-1(34) C/2	FILE NAME: 717014-PROFILES PROJECT LEADER: R.E. DUFRESNE DESIGNED BY: B.L. BAKER WATER PROFILES	PLOT DATE: Feb. 18, 11 DRAWN BY: B.L. BAKER CHECKED BY: C.L. WHITFIELD SHEET 152 OF 339
---	--	--	--