


**SOIL CLASSIFICATION**  
 URBAN LAND-UDIPSAMMENTS  
 COMPLEX, OCCASSIONALLY FLOODED  
 NEARLY LEVEL SLOPES  
 "K FACTOR" 0.10

- NOTES:**
1. THESE PLANS SHOW A CONCEPTUAL EROSION CONTROL PLAN, THE CONTRACTOR MUST SUBMIT A TEMPORARY EROSION CONTROL PLAN FOR APPROVAL.
  2. TEMPORARY EROSION CONTROL MEASURES ARE CONCEPTUALLY SHOWN. THE CONTRACTOR MAY RELOCATE TEMPORARY MEASURES TO IMPROVE EROSION CONTROL WITH APPROVAL OF THE RESIDENT ENGINEER AND ON SITE COORDINATOR.
  3. THE CONTRACTOR SHALL USE OTHER TEMPORARY EROSION CONTROL MEASURES AS NECESSITATED BY THE SEQUENCE OF CONSTRUCTION OR AS DIRECTED BY THE RESIDENT ENGINEER AND ON SITE COORDINATOR.
  4. CONTRACTOR SHALL PROVIDE DEWATERING OPERATIONS (INCIDENTAL TO POND CONSTRUCTION ITEMS).
  5. REFER TO TEMPORARY EROSION CONTROL DETAIL SHEETS FOR ADDITIONAL DETAILS.
  6. PROVIDE AN AGENCY APPROVED LINER IF THE POND CANNOT SUSTAIN A PERMANENT POOL. LINER SHALL BE PAID FOR AS SPECIAL PROVISION (POND LINER, GEOMEMBRANE)

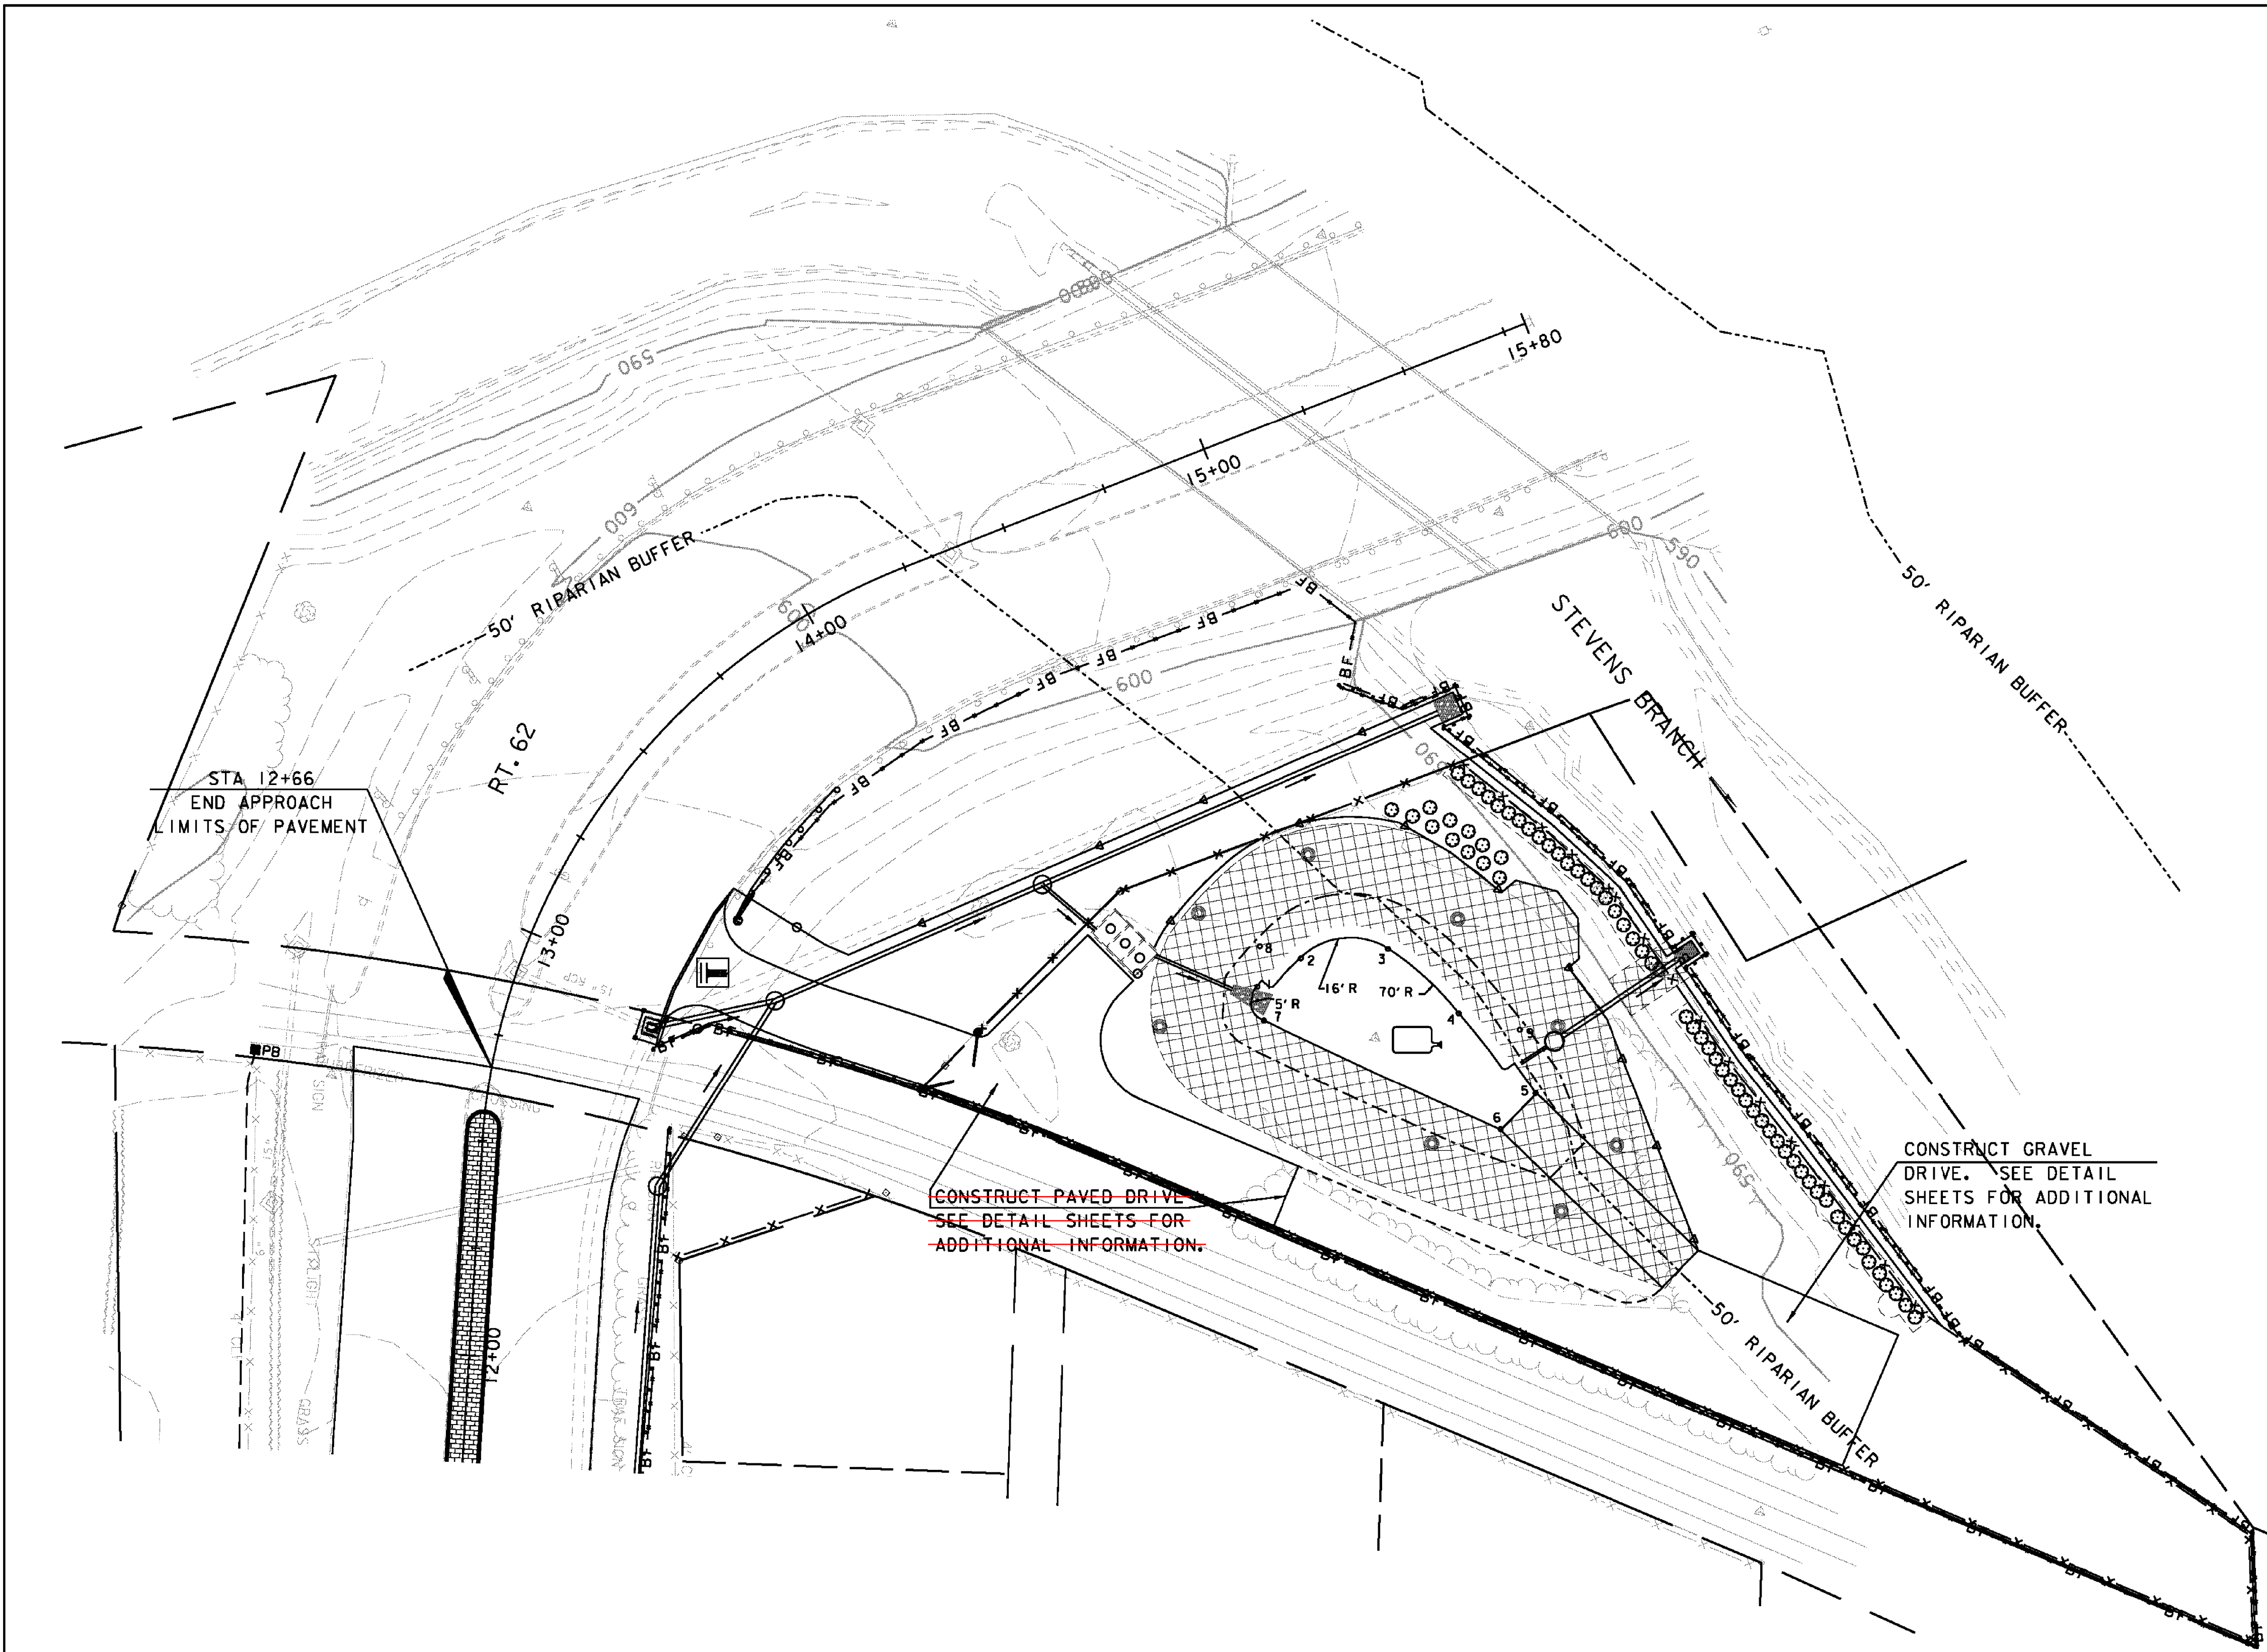

**LEGEND**

- SILT FENCE
- - - SILT FENCE, WOVEN-WIRE REINFORCED
- — △ — ○ LIMITS OF SOIL DISTURBANCE
- ▨ EROSION MATTING
- BF — BF BARRIER FENCE
- - - RIPARIAN BUFFER ZONE
- x — x — x NEW FENCE
- - - PROPOSED GRAVEL DRIVE
- ▭ STABILIZED CONSTRUCTION ENTRANCE
- ▧ DROP INLET PROTECTION
- FILTER BAG FOR DEWATERING

**EPSC CONSTRUCTION SITE PLAN**

PROJECT NAME: BARRE CITY  
 PROJECT NUMBER: FECC F 026-(134) C/2  
 FILE NAME: z85b010.ERO\_CP\_C2.dgn PLOT DATE: 3/9/2011  
 PROJECT LEADER: G. BAKOS DRAWN BY: DMP / DEJ  
 DESIGNED BY: DMP / DEJ CHECKED BY:  
 EPSC CONSTRUCTION SITE PLAN SHEET 161 OF 339

