


SUMMARY OF QUANTITIES

**WIRED CONDUIT (PVC) AND
ELECTRICAL CONDUIT SLEEVE SCHEDULE**

ITEM NUMBER	678.21	678.24	678.23			678.30	DESCRIPTION
	ELECTRICAL CONDUIT	ELECTRICAL WIRING	WIRED CONDUIT			CONDUIT SLEEVE	
	3'		2'	3'	4'	10'	
SHEET I65	205			346	198	205	
SHEET I68		152		297	266	113	
SUB-TOTALS	205	152	0	643	464	318	
ROUNDING	0	3	0	7	6	2	
TOTALS	205	155	0	650	470	320	

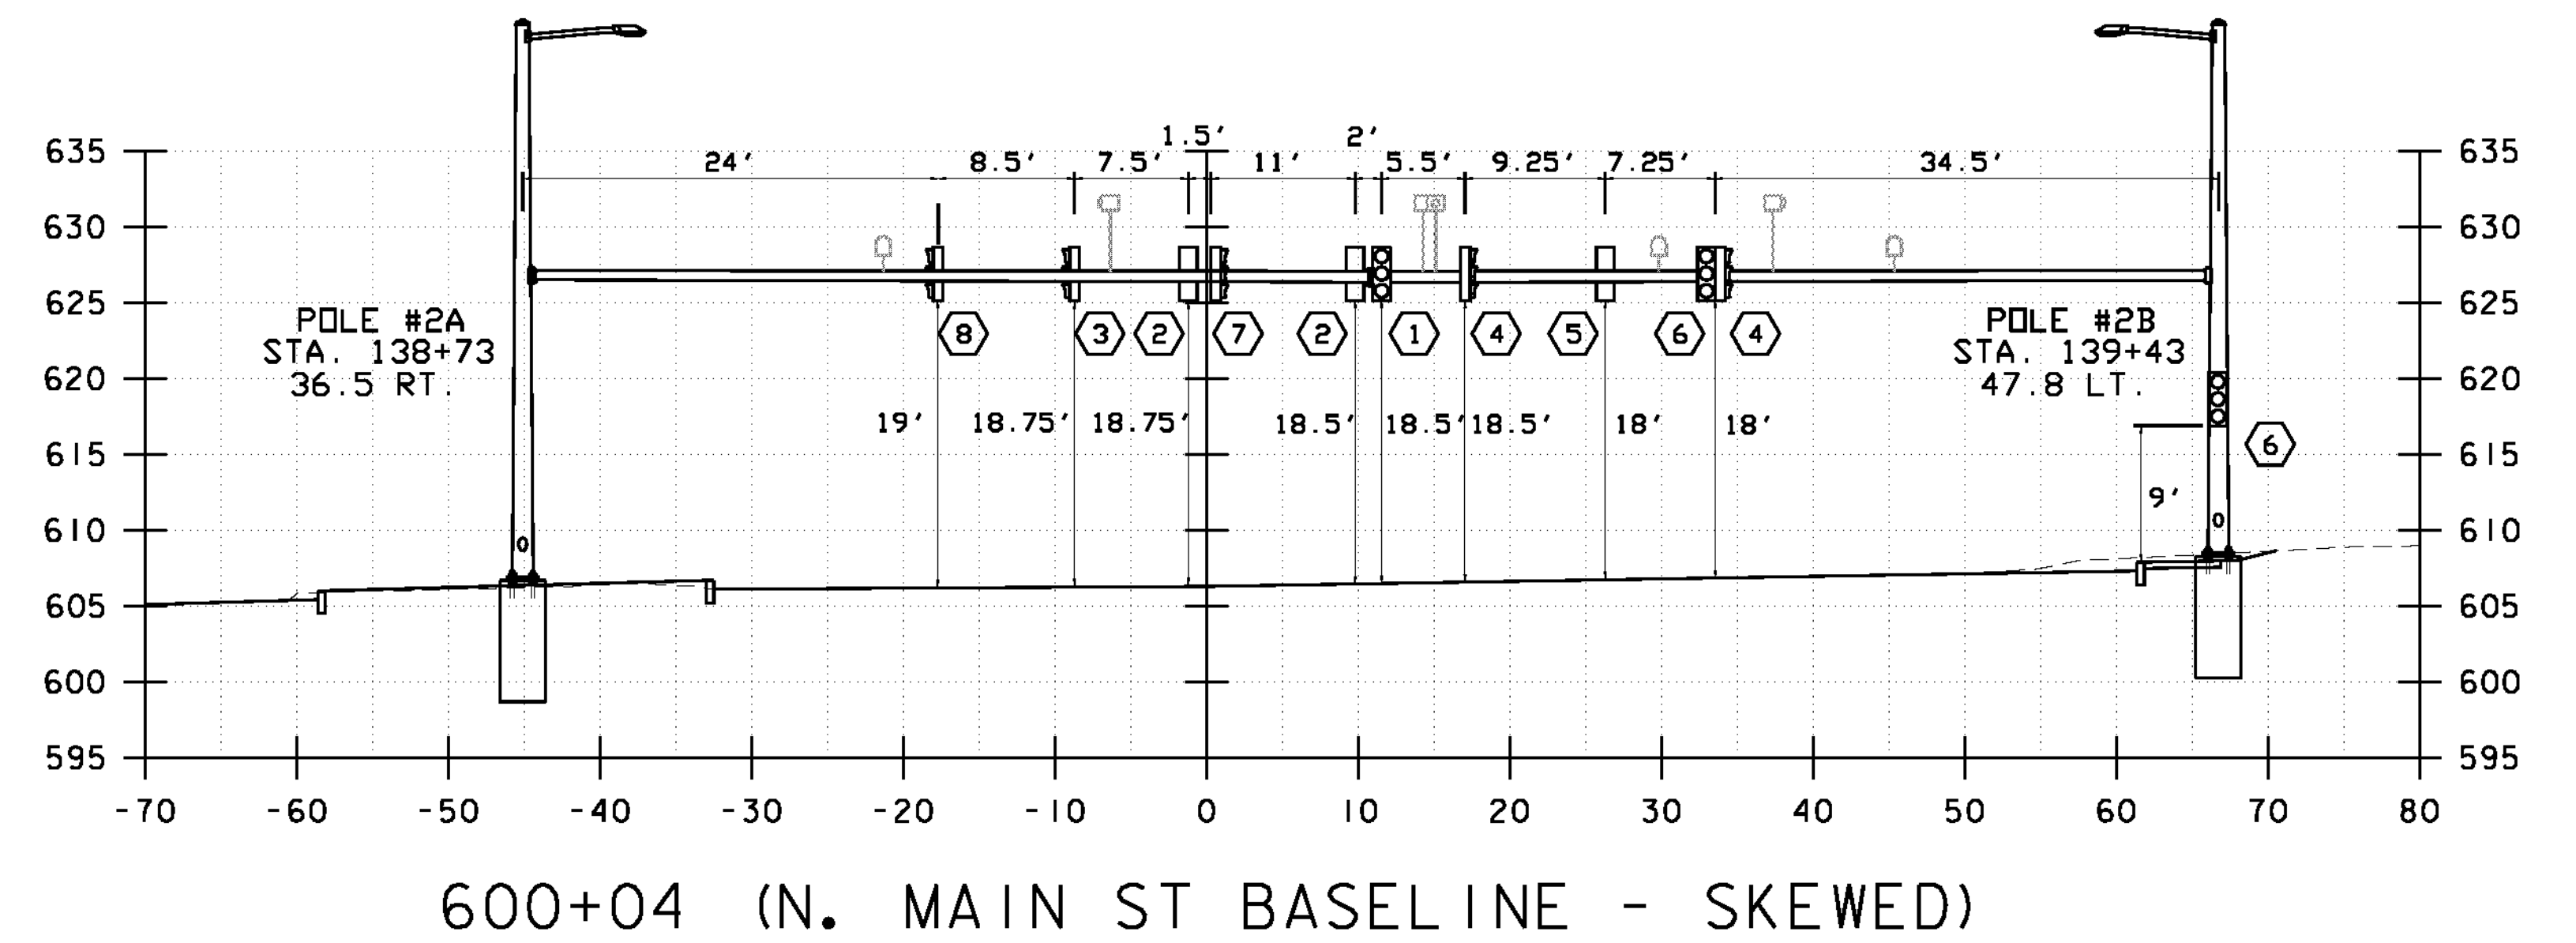

NOTES:

1. LOCATIONS OF OPTICAL DETECTION EQUIPMENT AND WIRELESS EQUIPMENT ARE APPROXIMATE. FINAL LOCATIONS FOR OPTICAL DETECTION EQUIPMENT AND WIRELESS EQUIPMENT SHALL BE DETERMINED BY THE CONTRACTOR AND THE ENGINEER IN ACCORDANCE WITH THE MANUFACTURER'S RECOMMENDATIONS.
2. CROSS-SECTION SHOWS LOCATION OF SIGNALS AT THE COMPLETION OF THE DETOUR OPERATIONS.

DATUM
VERTICAL NAVD 1929
HORIZONTAL NAD 27

NORTH MAIN ST AND ELM ST/WASHINGTON ST

PROJECT NAME: BARRE CITY	PLOT DATE: 3/9/2011
PROJECT NUMBER: FECC F 026-I(34) C/2	DRAWN BY: DMP / JAR
FILE NAME: z85b010_TSPS2D.dgn	CHECKED BY:
PROJECT LEADER: G. BAKOS	SHEET 170 OF 339
DESIGNED BY: DMP / MDS	
TRAFFIC SIGNAL PLAN	