

LEGEND

- PLASTIC DRUM AND YELLOW TEMPORARY PAVEMENT MARKINGS.
- PLASTIC DRUM AND WHITE TEMPORARY PAVEMENT MARKINGS.
- CONSTRUCTION AREA
- DESIGNATED DETOUR ROUTE
- CONSTRUCTION SIGN
- TYPE 3 BARRICADE
- BARRICADE WITH SIGNS
- LOCAL TRAFFIC ACCESS


REMOVE TRAFFIC ISLAND AND CONSTRUCT TEMPORARY PAVEMENT: 5" BIT. CONC. PAVEMENT ON TOP OF COMPACTED SUBGRADE TO MEET EXISTING GRADES.

TYPICAL: INSTALL R4-7 SIGN AT LEADING END OF BARRELS

NOTES:

1. REMOVE EXISTING PAVEMENT MARKINGS AS REQUIRED.
2. CONSTRUCTION ZONE SIGNING TO BE PLACED IN ACCORDANCE WITH VAOT STANDARD DRAWINGS AND MUTCD.
3. MAINTAIN PROPERTY ACCESS THROUGHOUT.
4. SEE TEMPORARY SIGNAL PLANS SHEETS 189-191.

DATUM	
VERTICAL	NAVD 1929
HORIZONTAL	NAD 27

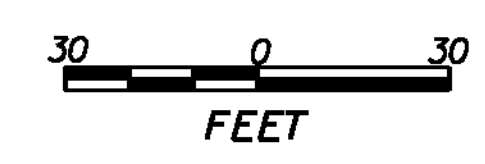

PHASE I, STAGE A	
PROJECT NAME:	BARRE CITY
PROJECT NUMBER:	FEGC F 026-1(34) C/2
FILE NAME:	85b010_CSPI.C2
PROJECT LEADER:	G. BAKOS
DESIGNED BY:	DMP / MDS
CONSTRUCTION INTERSECTION DETAIL	
PLOT DATE:	4/4/2011
DRAWN BY:	JAR
CHECKED BY:	
SHEET	174 OF 339