
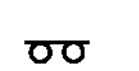
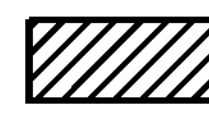
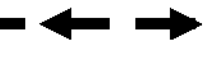







**LEGEND**

-  PLASTIC DRUM AND YELLOW TEMPORARY PAVEMENT MARKINGS.
-  PLASTIC DRUM AND WHITE TEMPORARY PAVEMENT MARKINGS.
-  CONSTRUCTION AREA
-  DESIGNATED DETOUR ROUTE
-  CONSTRUCTION SIGN
-  TYPE 3 BARRICADE
-  BARRICADE WITH SIGNS
-  LOCAL TRAFFIC ACCESS


TYPICAL:  
INSTALL R4-7 SIGN AT  
LEADING END OF BARRELS



**NOTES:**

1. REMOVE EXISTING PAVEMENT MARKINGS AS REQUIRED.
2. CONSTRUCTION ZONE SIGNING TO BE PLACED IN ACCORDANCE WITH VAOT STANDARD DRAWINGS AND MUTCD.
3. MAINTAIN PROPERTY ACCESS THROUGHOUT.
4. SEE TEMPORARY SIGNAL PLANS SHEETS 189 - 191.

|            |           |
|------------|-----------|
| DATUM      |           |
| VERTICAL   | NAVD 1929 |
| HORIZONTAL | NAD 27    |

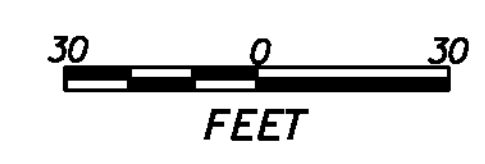

|                                  |                      |
|----------------------------------|----------------------|
| PHASE I, STAGE C                 |                      |
| PROJECT NAME:                    | BARRE CITY           |
| PROJECT NUMBER:                  | FEGC F 026-(134) C/2 |
| FILE NAME:                       | 85b010_CSP3_C2       |
| PROJECT LEADER:                  | G. BAKOS             |
| DESIGNED BY:                     | DMP / MDS            |
| CONSTRUCTION INTERSECTION DETAIL |                      |
| PLOT DATE:                       | 3/31/2011            |
| DRAWN BY:                        | DMP / JAR            |
| CHECKED BY:                      |                      |
| SHEET 178                        | OF 339               |