




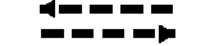


- LEGEND**
-  CONSTRUCTION AREA
 -  DESIGNATED DETOUR ROUTE
 -  CONSTRUCTION SIGN
 -  TYPE 1/2/3 BARRICADE
 -  BARRICADE WITH SIGNS
 -  LOCAL TRAFFIC ACCESS



**WELLINGTON STREET
CONSTRUCTION SIGNS DETAIL**

PROJECT NAME: BARRE CITY	PLOT DATE: 3/31/2011
PROJECT NUMBER: FECC F 026-(134) C/2	DRAWN BY: DMP / JAR
FILE NAME: 85b010_CSP5_C2	CHECKED BY:
DESIGNED BY: DMP / MDS	CONST. & DETOUR SIGNING PLAN PHASES 2-6 SHEET 183 OF 339