


MATCH TO STA. 407+75 (SHEET 196)

MATCH TO STA. 413+75 (SHEET 198)

- TEMPORARY 4 INCH YELLOW LINE**
- SL STA 408+20 - 408+45 CL (DOUBLE)
 - SL STA 408+75 - 411+70 CL (DOUBLE)
 - SL STA 412+10 - 413+75 CL (DOUBLE)
- TEMPORARY 4 INCH WHITE LINE**
- SL STA 408+03 - 411+64 LT
 - SL STA 408+21 - 408+47 RT
 - SL STA 408+76 - 411+23 RT (PARKING)
 - SL STA 411+23 - 411+66 RT
 - SL STA 412+08 - 413+75 LT
 - SL STA 412+11 - 413+75 RT (PARKING)

- | | |
|--------------------------|--------------------------|
| SIGNING LEGEND | STRIPING LEGEND |
| N = NEW | SWL = SINGLE WHITE LINE |
| R = REMOVE | SYL = SINGLE YELLOW LINE |
| R&S = REMOVE AND SALVAGE | DYL = DOUBLE YELLOW LINE |
| RET = RETAIN | SDL = SINGLE DASHED LINE |
| S = SALVAGED SIGN | SBL = SINGLE BROKEN LINE |
| B-B = BACK TO BACK | |

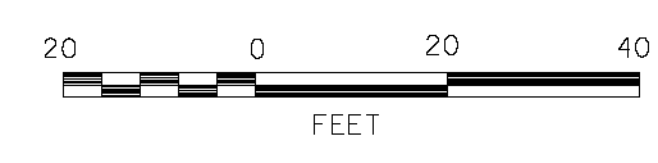

VHB Vanasse Hangen Brustlin, Inc.

PROJECT NAME: BARRE CITY	PLOT DATE: 3/9/2011
PROJECT NUMBER: FECC F 026-1(34) C/2	DRAWN BY: D. PECK
FILE NAME: z85b010bdr tcp	CHECKED BY:
PROJECT LEADER: G. BAKOS	TEMP. SIGNS & PAVEMENT MARKING PLAN #3 SHEET 197 OF 339