


111+50  
 EXCAVATION ~ (4.25' X 50.5') + (2 X 5' X 1.42') = 229 SF  
 DENSE GRADED ~ 2.00' X 50.5' = 101 SF  
 SAND BORROW ~ 1.50' X 50.5' = 76 SF



111+00.07  
 EXCAVATION ~ 2.75' X 54' = 148 SF  
 DENSE GRADED ~ 2.00' X 54' = 108 SF  
 SAND BORROW = 0

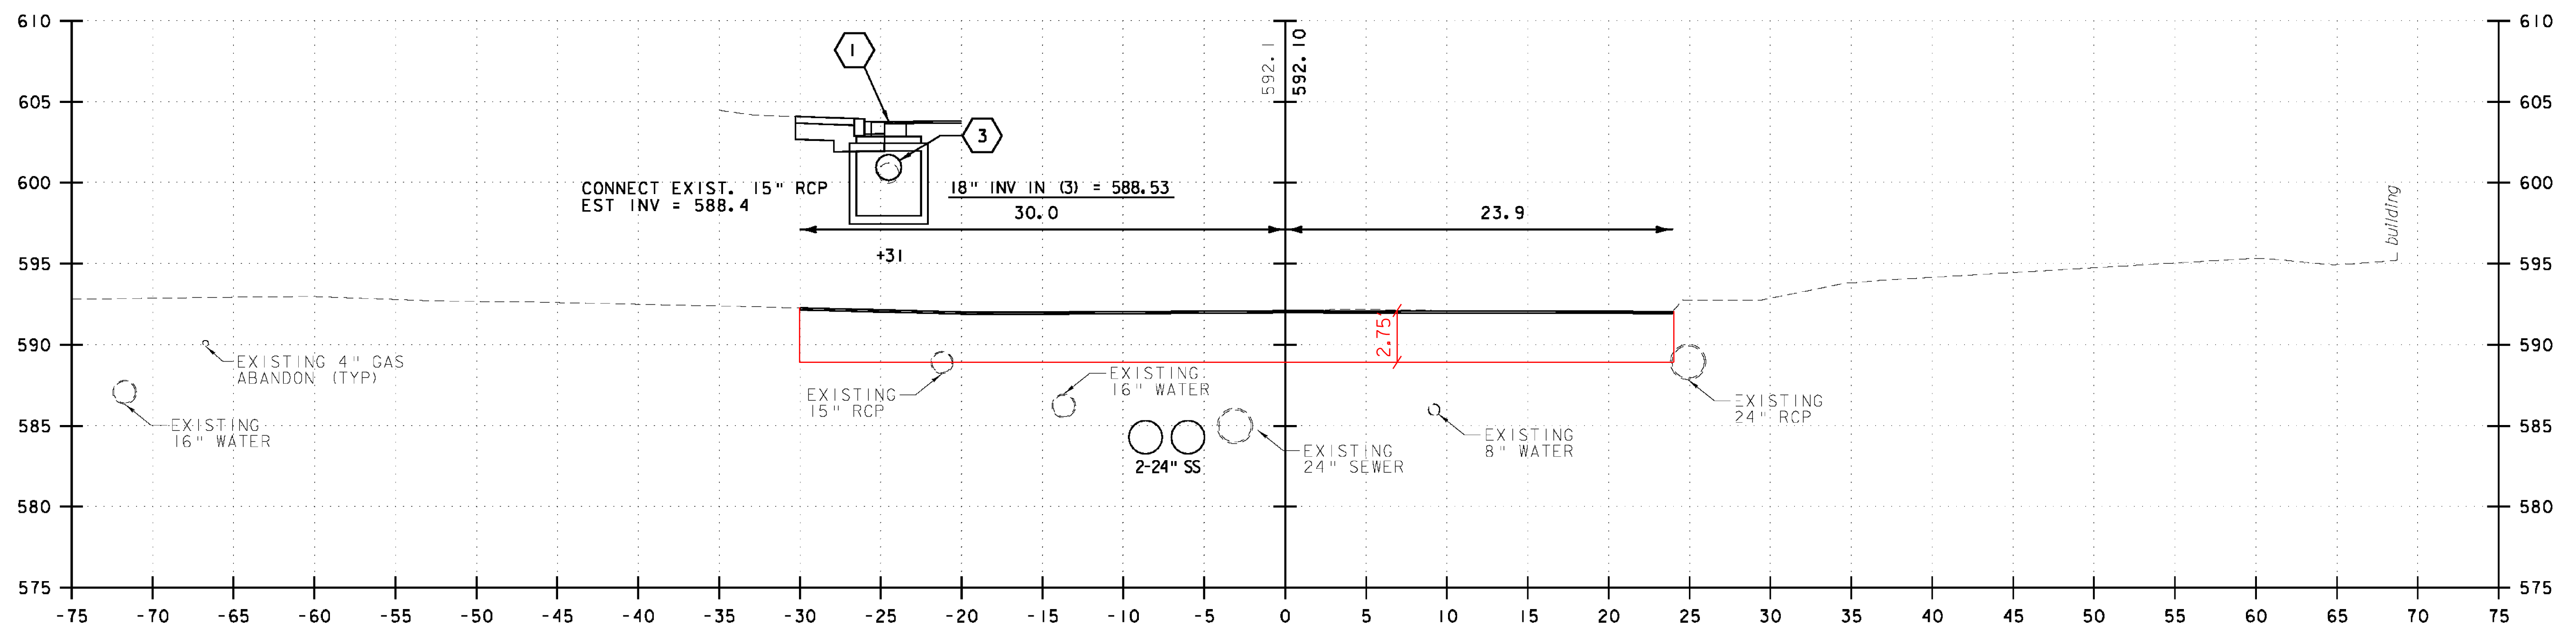

**VHB** Vanasse Hangen Brustlin, Inc.

NORTH MAIN STREET (US 302)	
PROJECT NAME:	BARRE CITY
PROJECT NUMBER:	FEGC F 026-(134) C/2
FILE NAME:	85b010_xsl.Cu+1.C2
PROJECT LEADER:	G. BAKOS
DESIGNED BY:	DMP / MDS
CROSS SECTIONS	
PLOT DATE:	3/9/2011
DRAWN BY:	DMP / JAR
CHECKED BY:	
SHEET	230 OF 339