



115+50 DENSE GRADED ~ 2.00' X 62' = 124 SF
 SAND BORROW ~ 1.50' X 62' = 93 SF

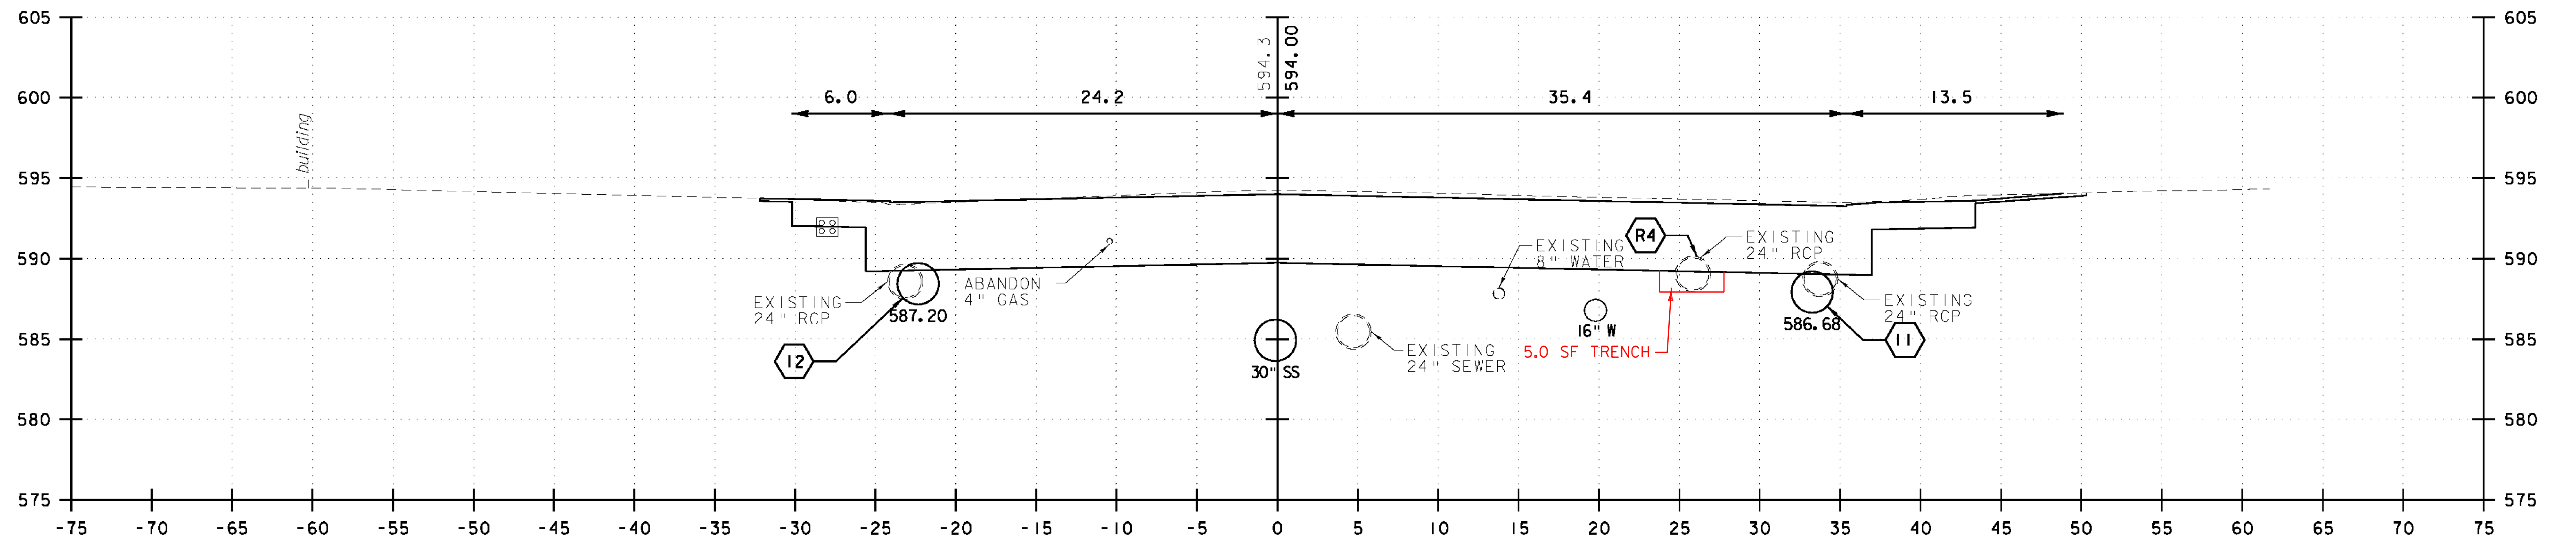

+19
DRIVE LT

115+00 DENSE GRADED ~ 2.00' X 63' = 126 SF
 SAND BORROW ~ 1.50' X 63' = 94.5 SF

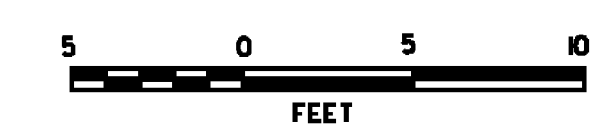

VHB Vanasse Hangen Brustlin, Inc.

NORTH MAIN STREET (US 302)

| | | | |
|-----------------|----------------------|----------------|------------------|
| PROJECT NAME: | BARRE CITY | PLOT DATE: | 3/9/2011 |
| PROJECT NUMBER: | FEGC F 026-(134) C/2 | DRAWN BY: | DMP / JAR |
| FILE NAME: | 85b010_xsl.Cu+1.C2 | CHECKED BY: | |
| PROJECT LEADER: | G. BAKOS | CROSS SECTIONS | SHEET 237 OF 339 |
| DESIGNED BY: | DMP / MDS | | |