


116+00

DENSE GRADED ~ 2.00' X 59' = 118 SF
 SAND BORROW ~ 1.50' X 59' = 88.5 SF

30" INV IN (13) = 587.62
 30" INV OUT (12) = 587.52

30" INV IN (14) = 587.05
 6" INV IN = 587.1 (RD)
 30" INV OUT (11) = 586.95

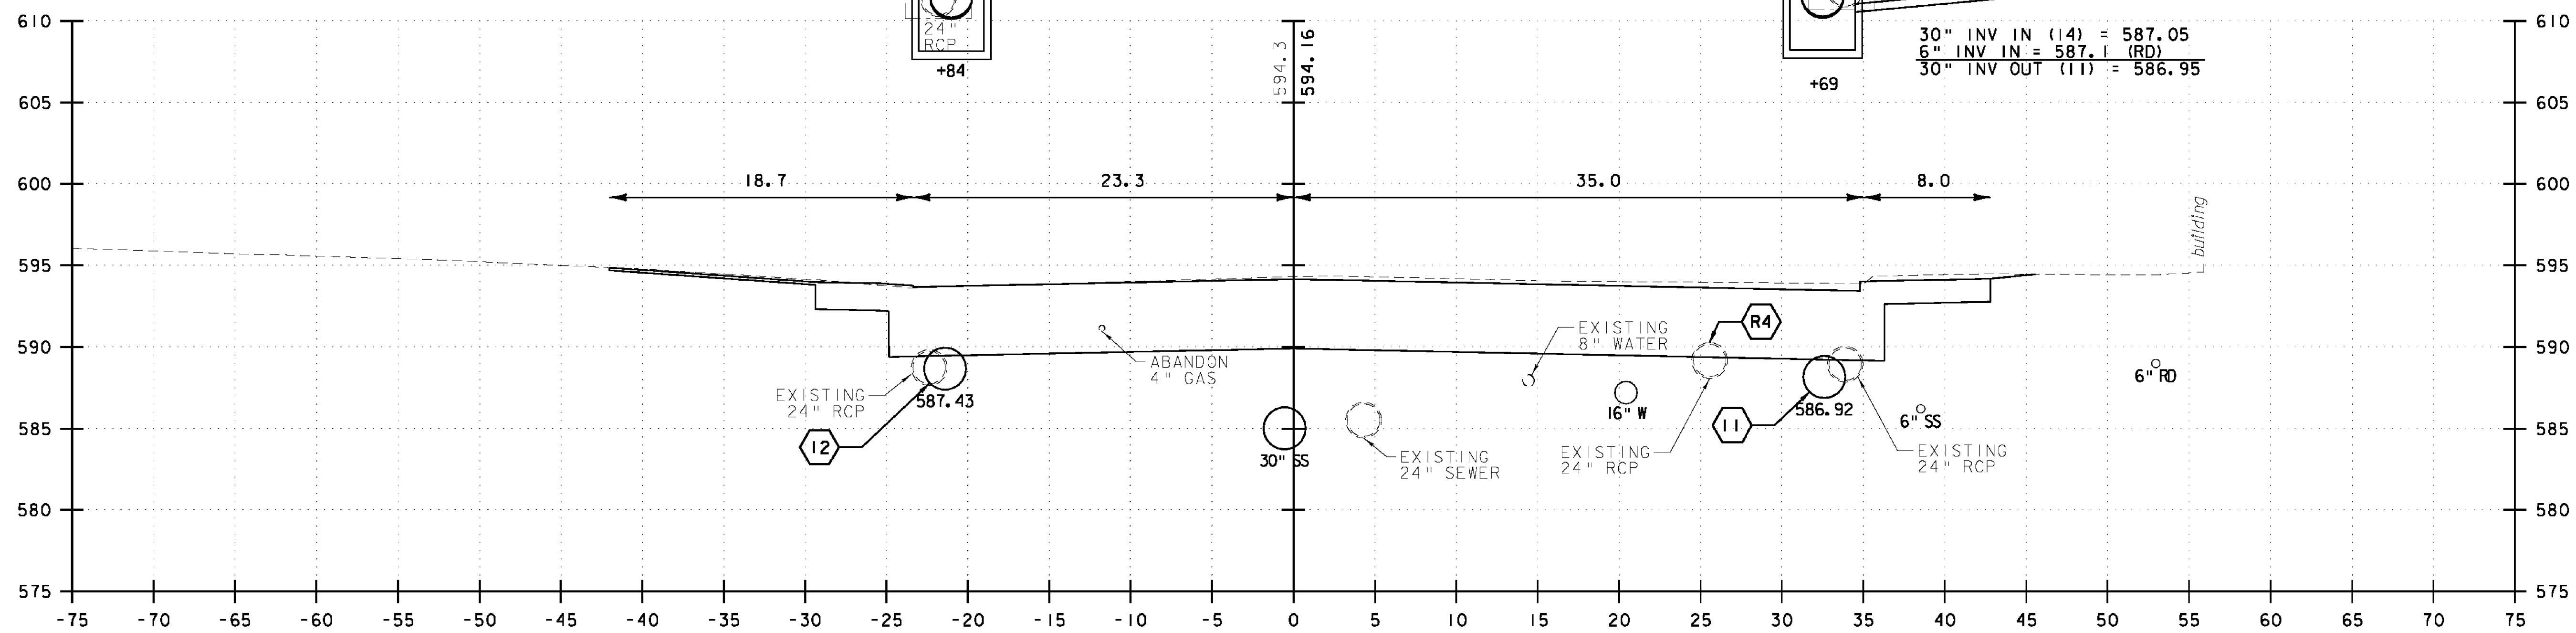

115+60

+84
 DRIVE LT

NORTH MAIN STREET (US 302)

PROJECT NAME:	BARRE CITY	PLOT DATE:	3/9/2011
PROJECT NUMBER:	FEGC F 026-(134) C/2	DRAWN BY:	DMP / JAR
FILE NAME:	85b010_xsl_Cu+_C2	CHECKED BY:	
PROJECT LEADER:	G. BAKOS	CROSS SECTIONS	SHEET 238 OF 339
DESIGNED BY:	DMP / MDS		

5 0 5 10
 FEET

VHB Vanasse Hangen Brustlin, Inc.