



130+39

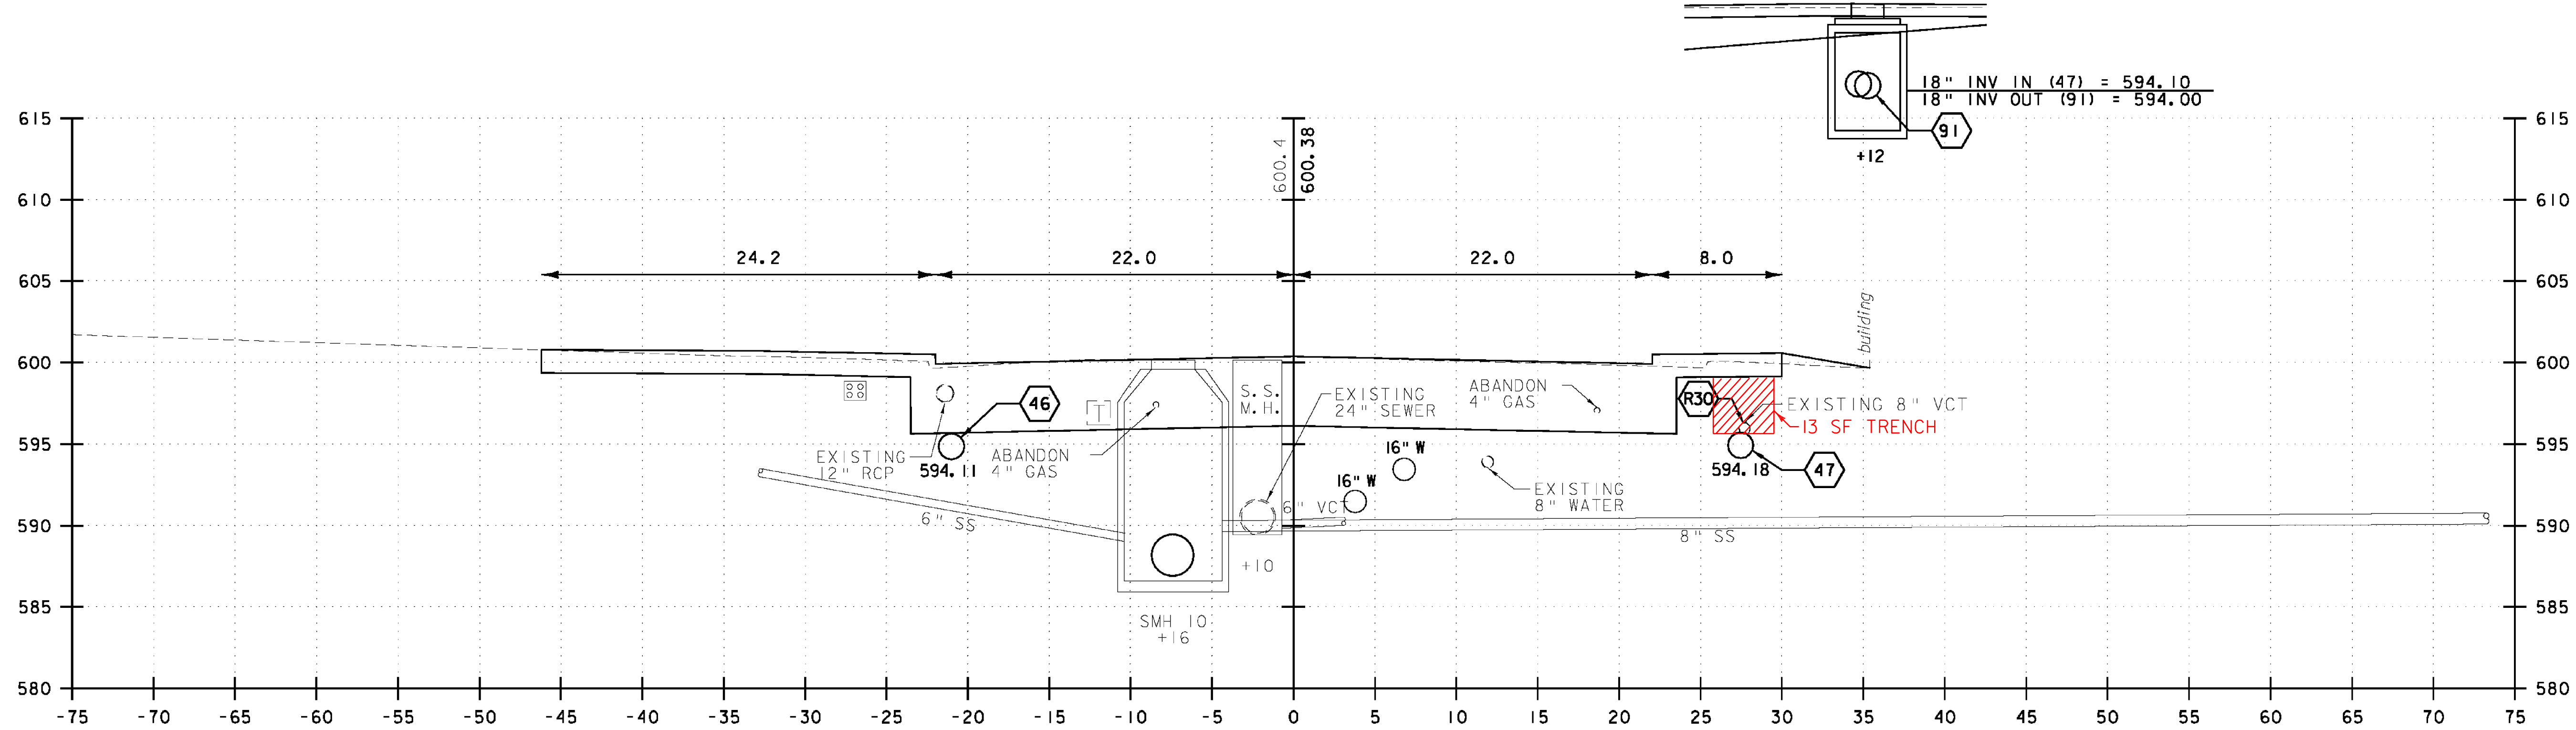

130+00

SAND BORROW ~ 1.50' X 47.0' = 70.5 SF  
 SUBBASE ~ 2.00' X 47.0' = 94.0 SF

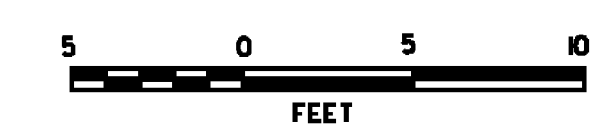

**VHB** Vanasse Hangen Brustlin, Inc.

NORTH MAIN STREET (US 302)

PROJECT NAME:	BARRE CITY	PLOT DATE:	3/9/2011
PROJECT NUMBER:	FEGC F 026-(134) C/2	DRAWN BY:	DMP / JAR
FILE NAME:	85b010_xsl.Cut_C2	CHECKED BY:	
PROJECT LEADER:	G. BAKOS	CROSS SECTIONS	
DESIGNED BY:	DMP / MDS		
			SHEET 262 OF 339