


132+50 SAND BORROW ~ 1.50' X 47.0' = 70.5 SF
 SUBBASE ~ 2.00' X 47.0' = 94.0 SF

8" INV IN = 595.1 (EXIST)
 18" INV OUT (92) = 594.50

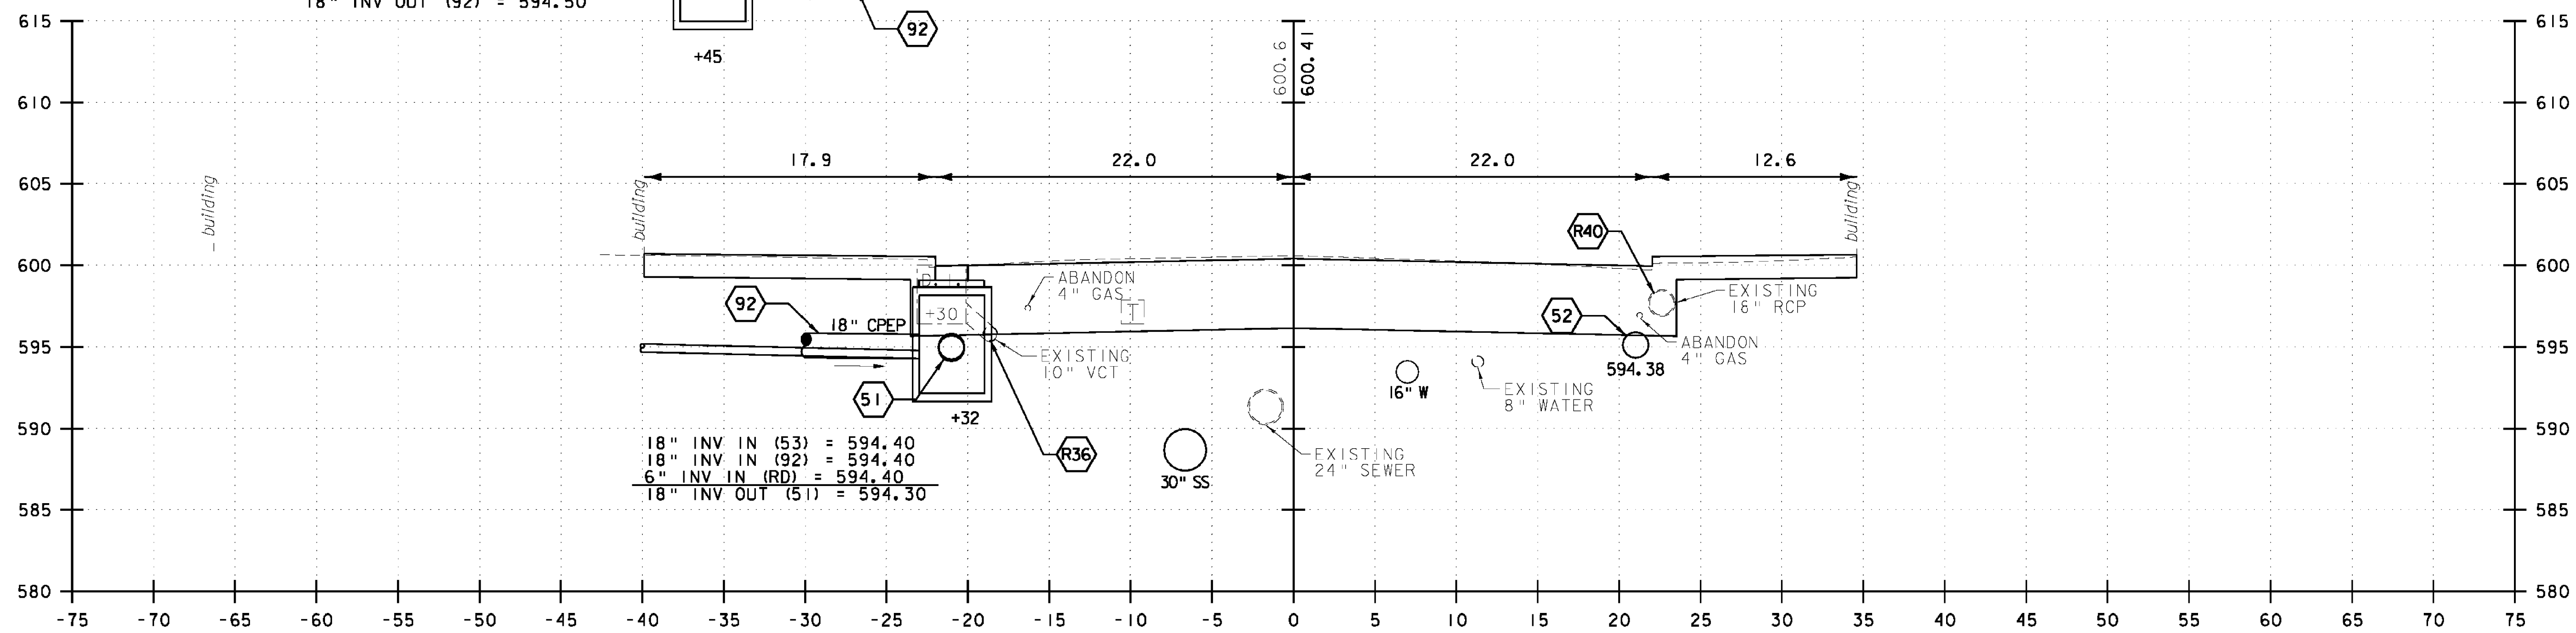

18" INV IN (53) = 594.40
 18" INV IN (92) = 594.40
 6" INV IN (RD) = 594.40
 18" INV OUT (51) = 594.30

132+00 SAND BORROW ~ 1.50' X 47.0' = 70.5 SF
 SUBBASE ~ 2.00' X 47.0' = 94.0 SF



VHB Vanasse Hangen Brustlin, Inc.

NORTH MAIN STREET (US 302)

PROJECT NAME:	BARRE CITY	PLOT DATE:	3/9/2011
PROJECT NUMBER:	FEGC F 026-(134) C/2	DRAWN BY:	DMP / JAR
FILE NAME:	85b010_xsl.Cu+_C2	DESIGNED BY:	DMP / MDS
CROSS SECTIONS		CHECKED BY:	
		SHEET	265 OF 339