




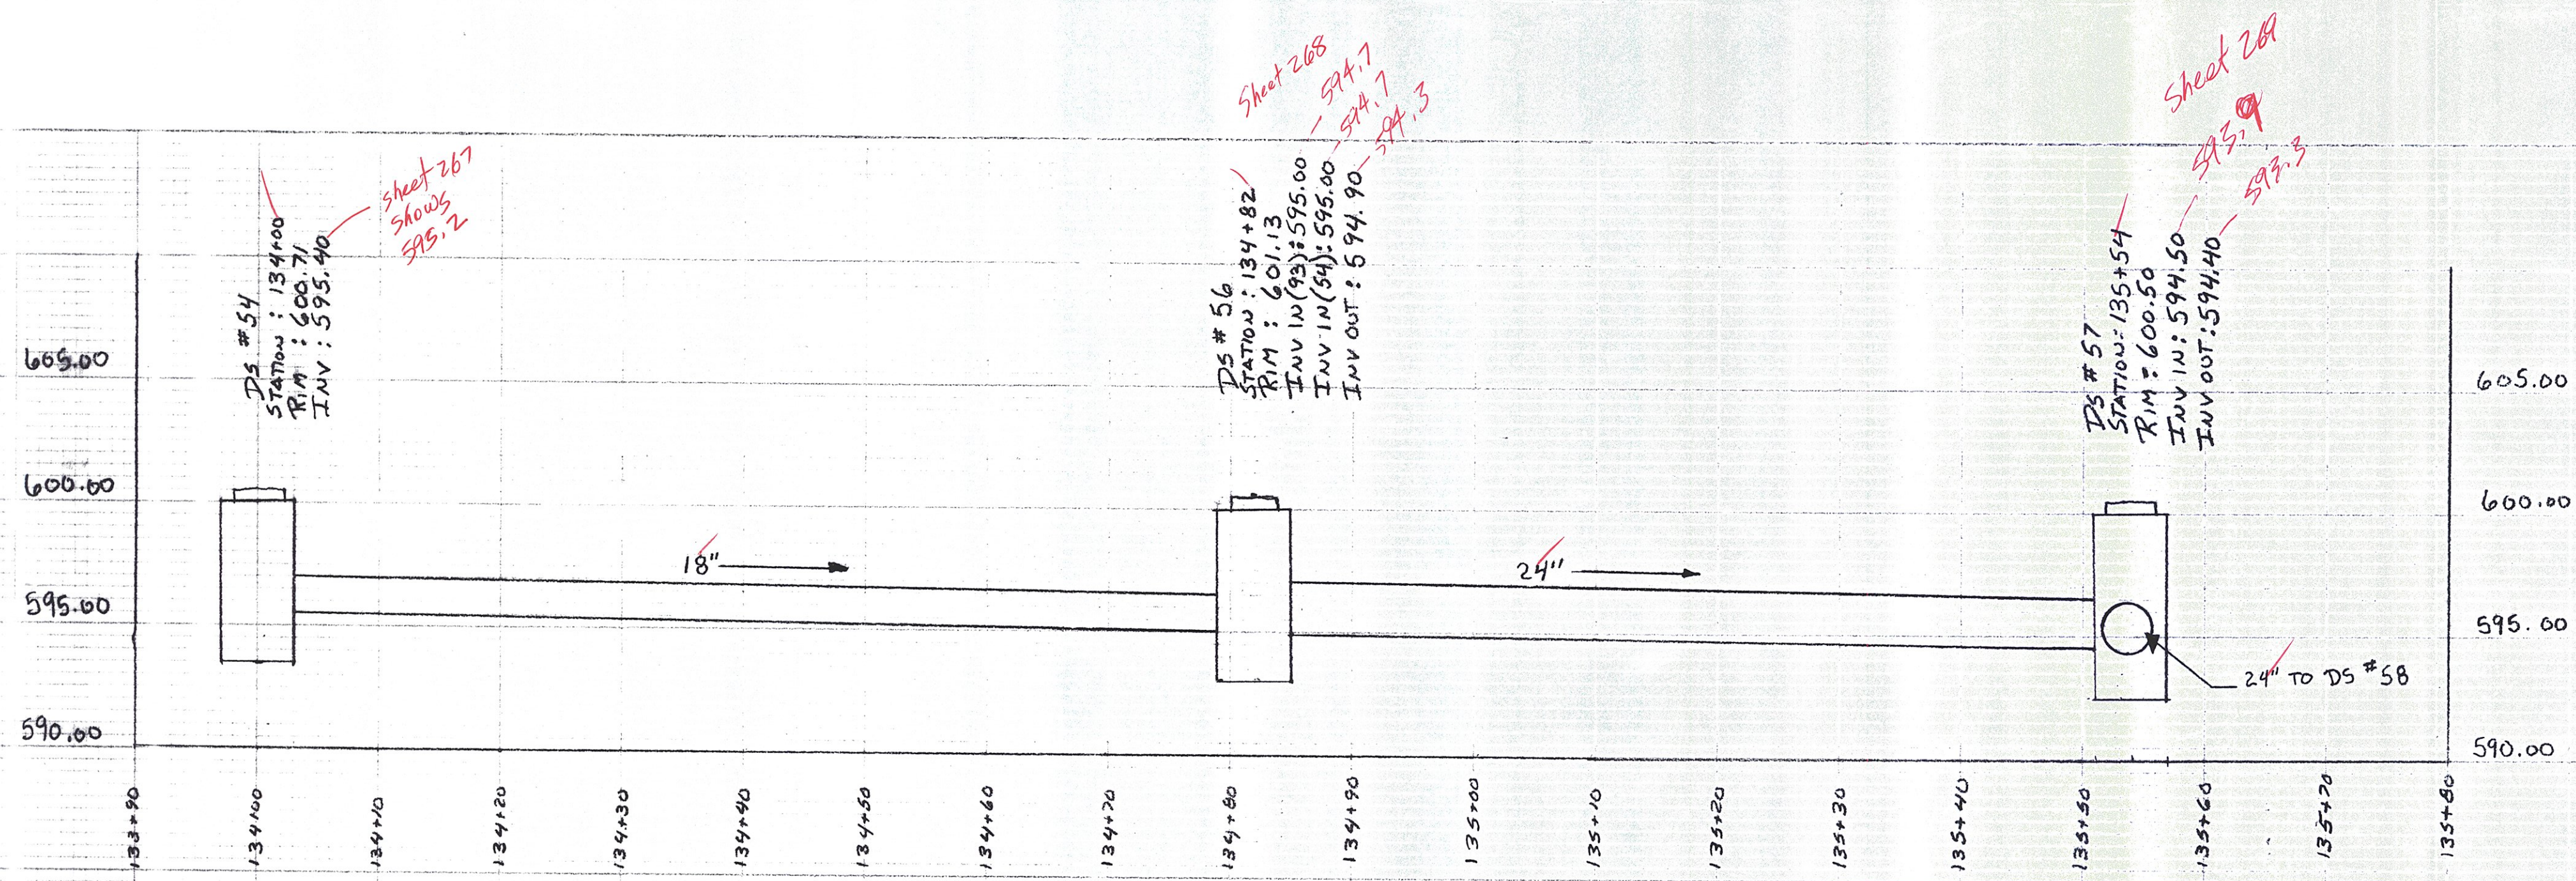

DRAINAGE RUN (54) TO (57)

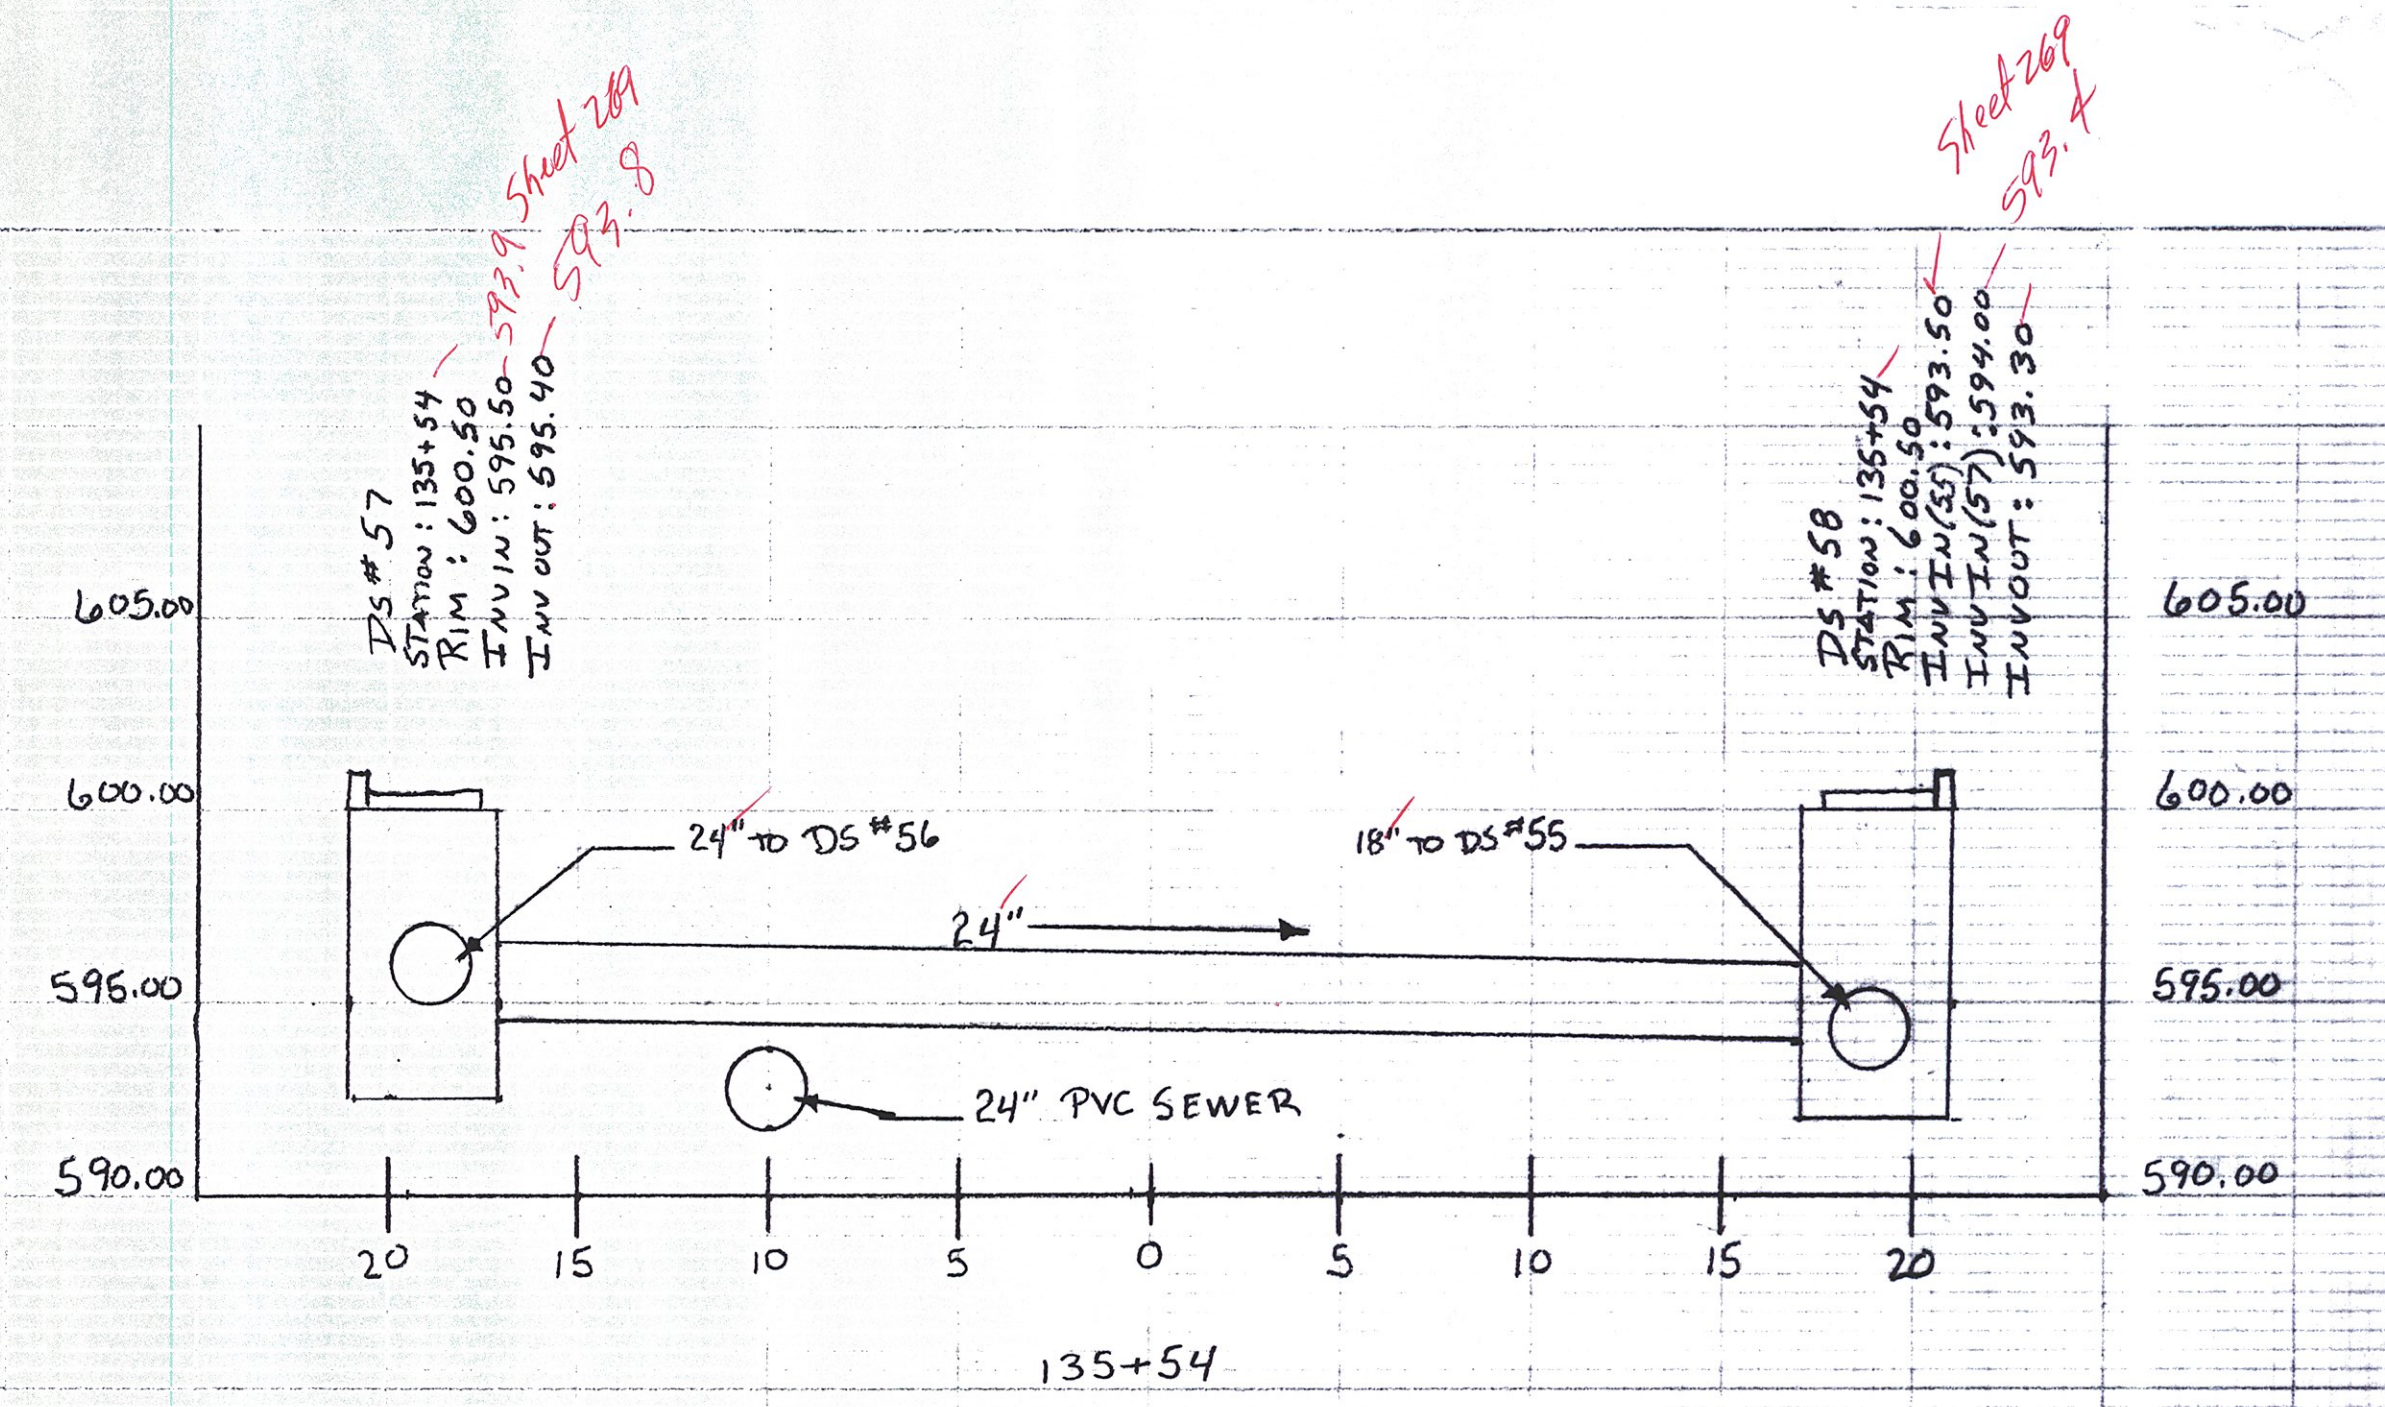

DRAINAGE X-ING (57) TO (58)

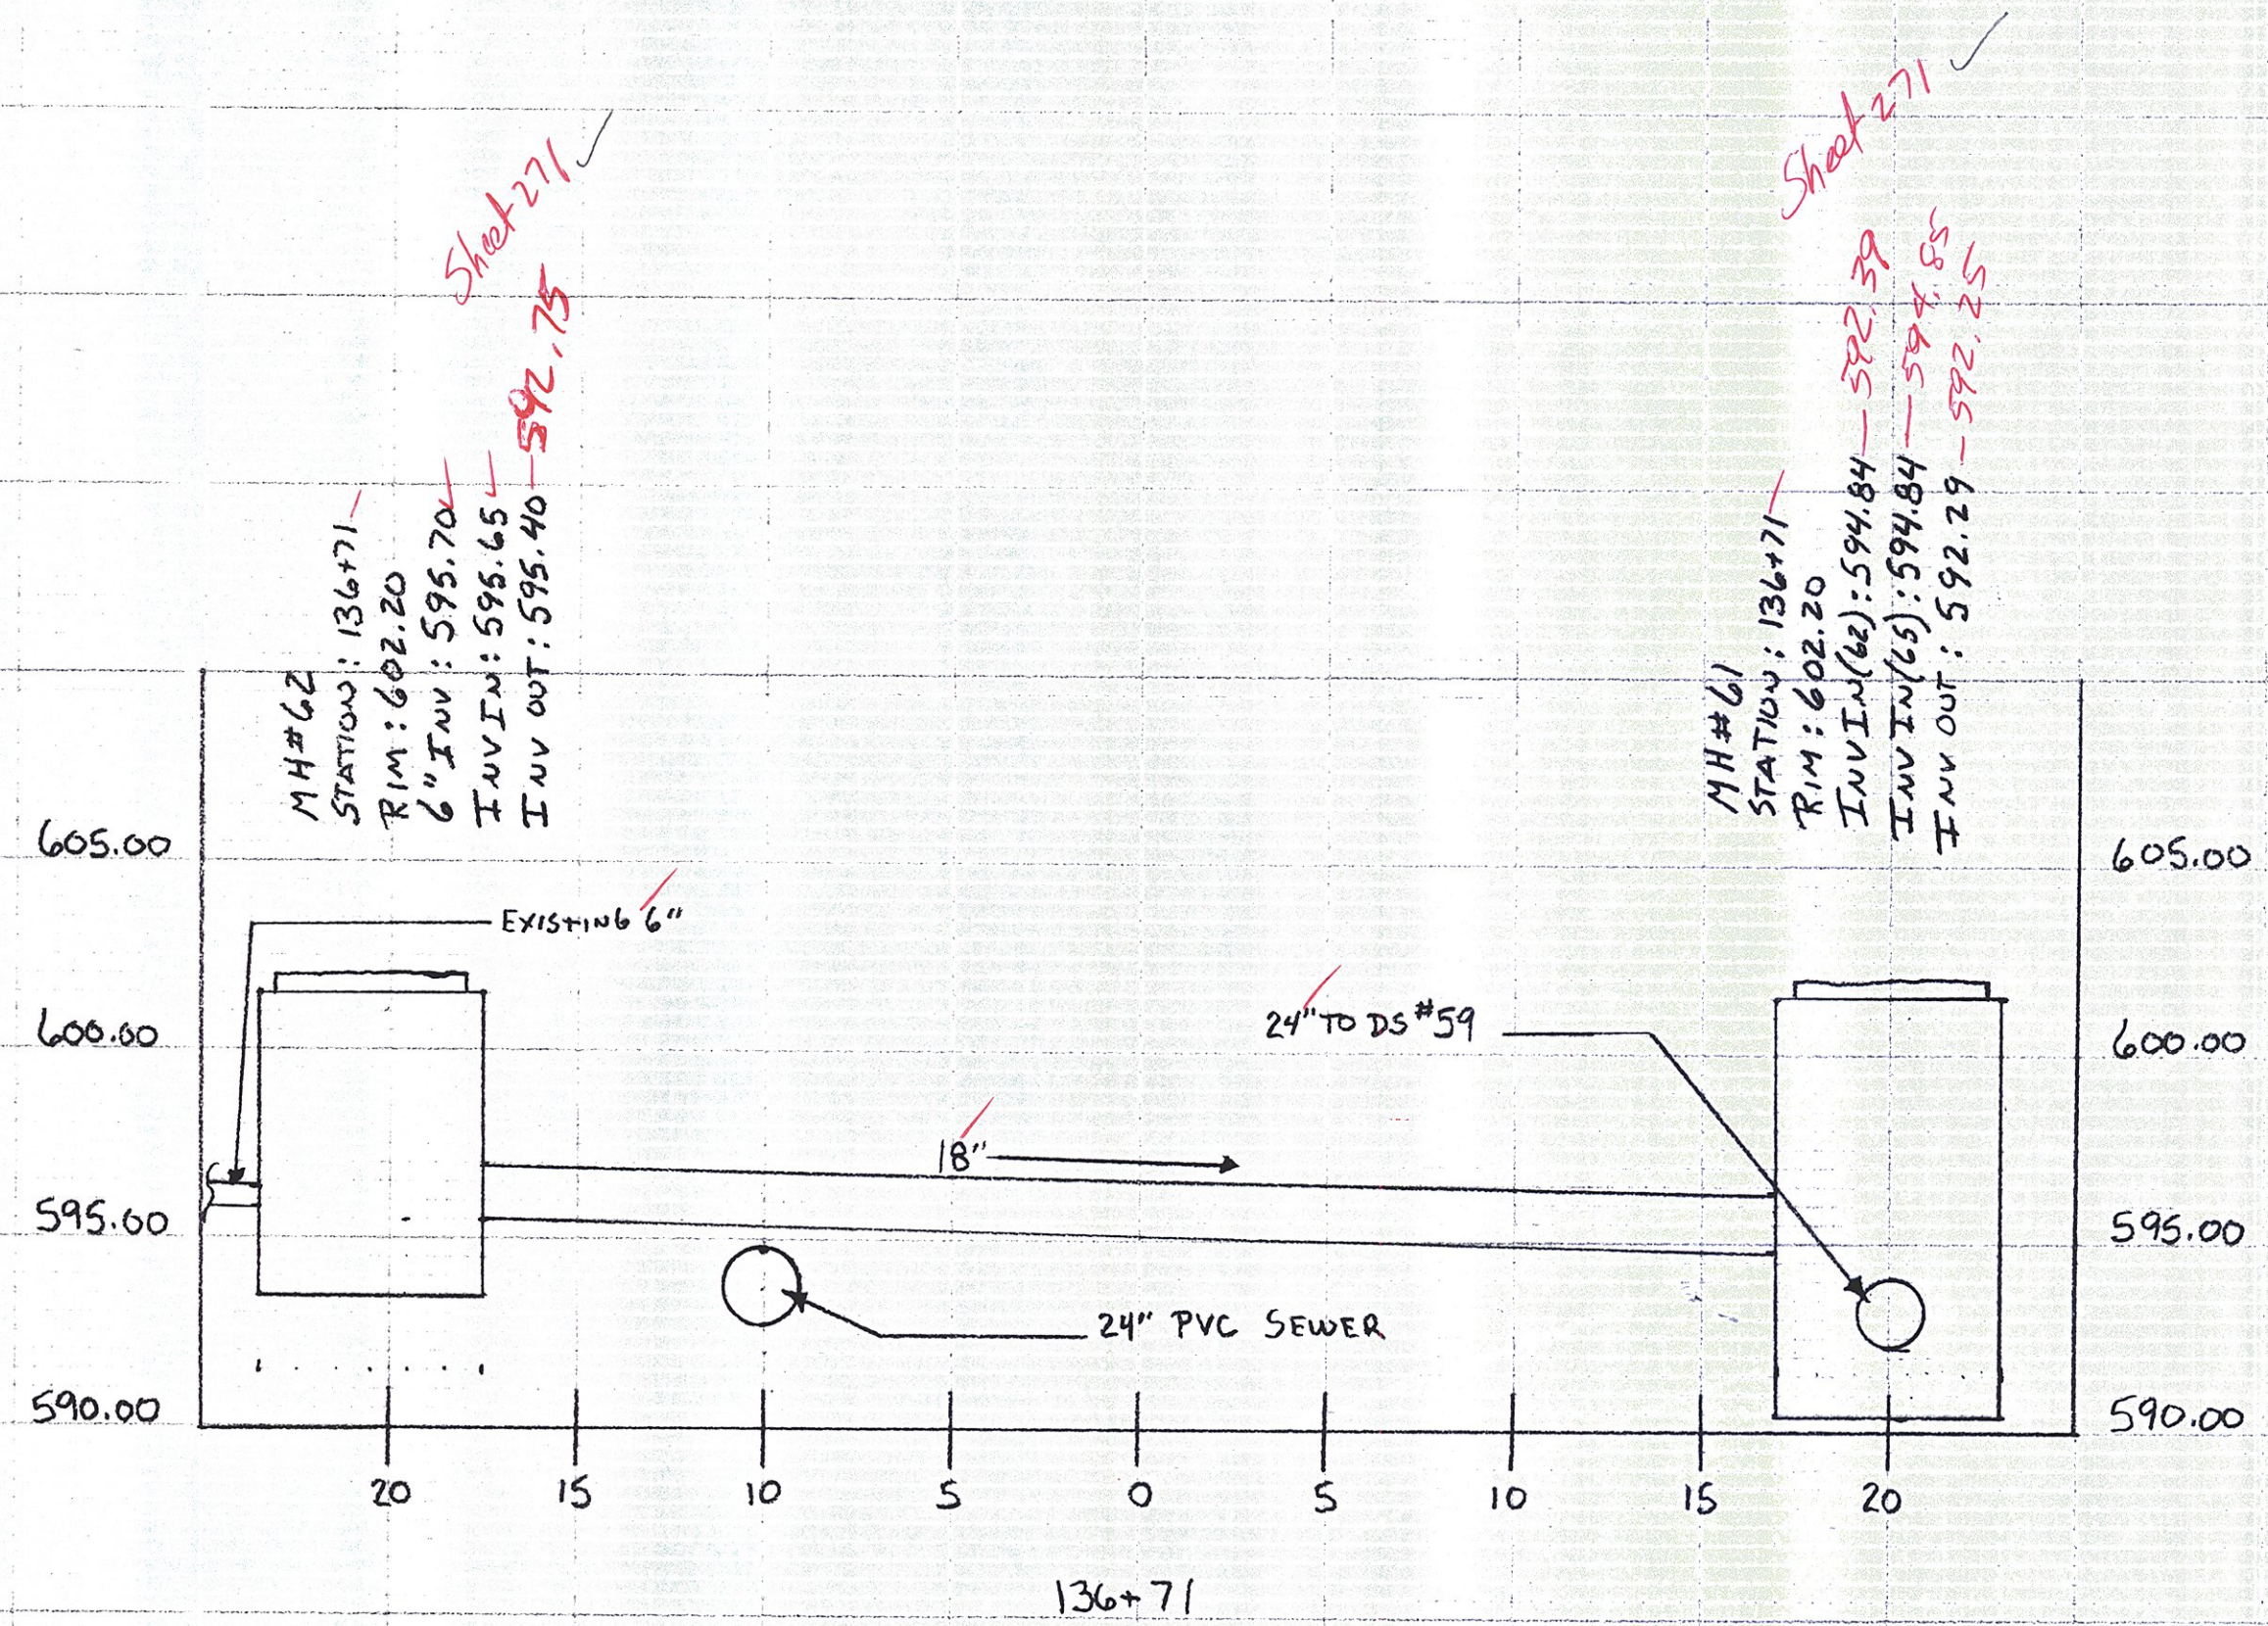

PROJECT NAME: BARRE CITY		NOTES / REVISIONS	
		ISSUED: 2/7/2012	
PROJECT NUMBER: FEGC F 026-1(34) C/2			
FILE NAME: SAN PROFILES			
MANAGER: J. LUCK			
DRAWN BY: C. KEMPNEY			
		PROPOSED REDESIGN STORM SEWER PROFILES	