


137+00 SAND BORROW ~ 1.50' X 47.0' = 70.5 SF
 SUBBASE ~ 2.00' X 47.0' = 94.0 SF

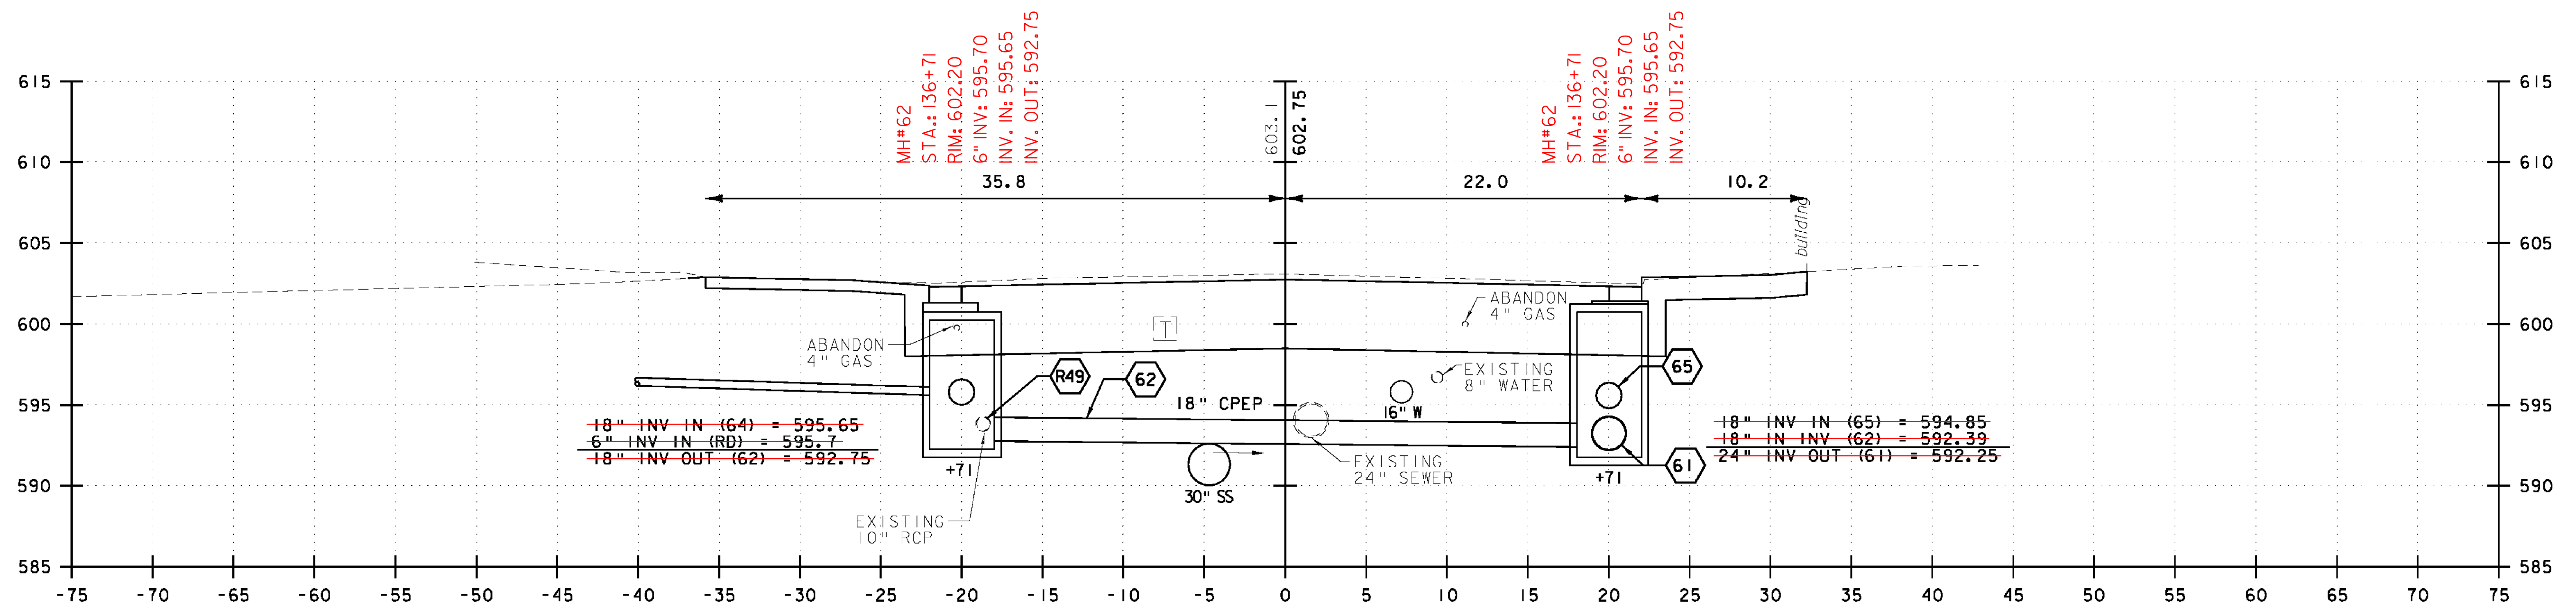

+71 DRIVE LT

136+71

NORTH MAIN STREET (US 302)

PROJECT NAME:	BARRE CITY	PLOT DATE:	3/9/2011
PROJECT NUMBER:	FEGC F 026-1(34) C/2	DRAWN BY:	DMP / JAR
FILE NAME:	85b010_xsl.Cu+1.C2	DESIGNED BY:	DMP / MDS
PROJECT LEADER:	G. BAKOS	CHECKED BY:	
CROSS SECTIONS		SHEET	271 OF 339

