


81+25



81+00

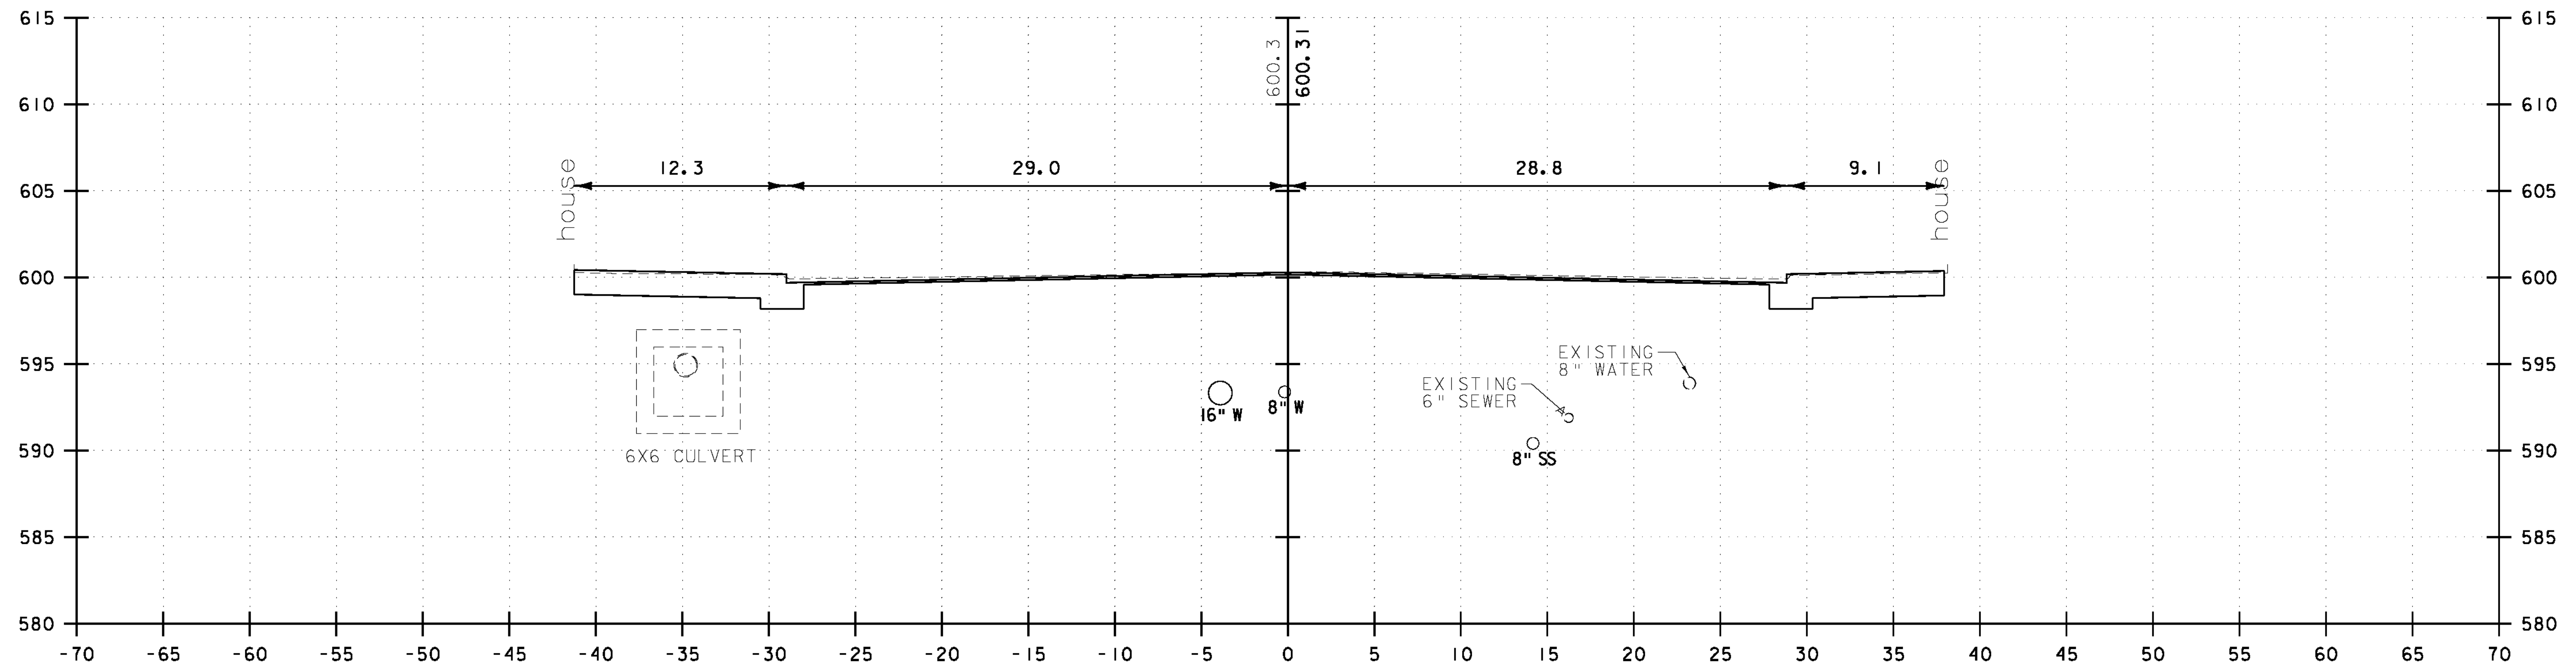

VHB Vanasse Hangen Brustlin, Inc.

DEPOT SQUARE	
PROJECT NAME: BARRE CITY	
PROJECT NUMBER: FECC F 026-I(34) C/2	
FILE NAME: 85b010_xs2_Cut_C2	PLOT DATE: 3/9/2011
PROJECT LEADER: G. BAKOS	DRAWN BY: DMP / JAR
DESIGNED BY: DMP / MDS	CHECKED BY:
CROSS SECTIONS	SHEET 312 OF 339