


# PROJECT DESCRIPTION AND LOCATION

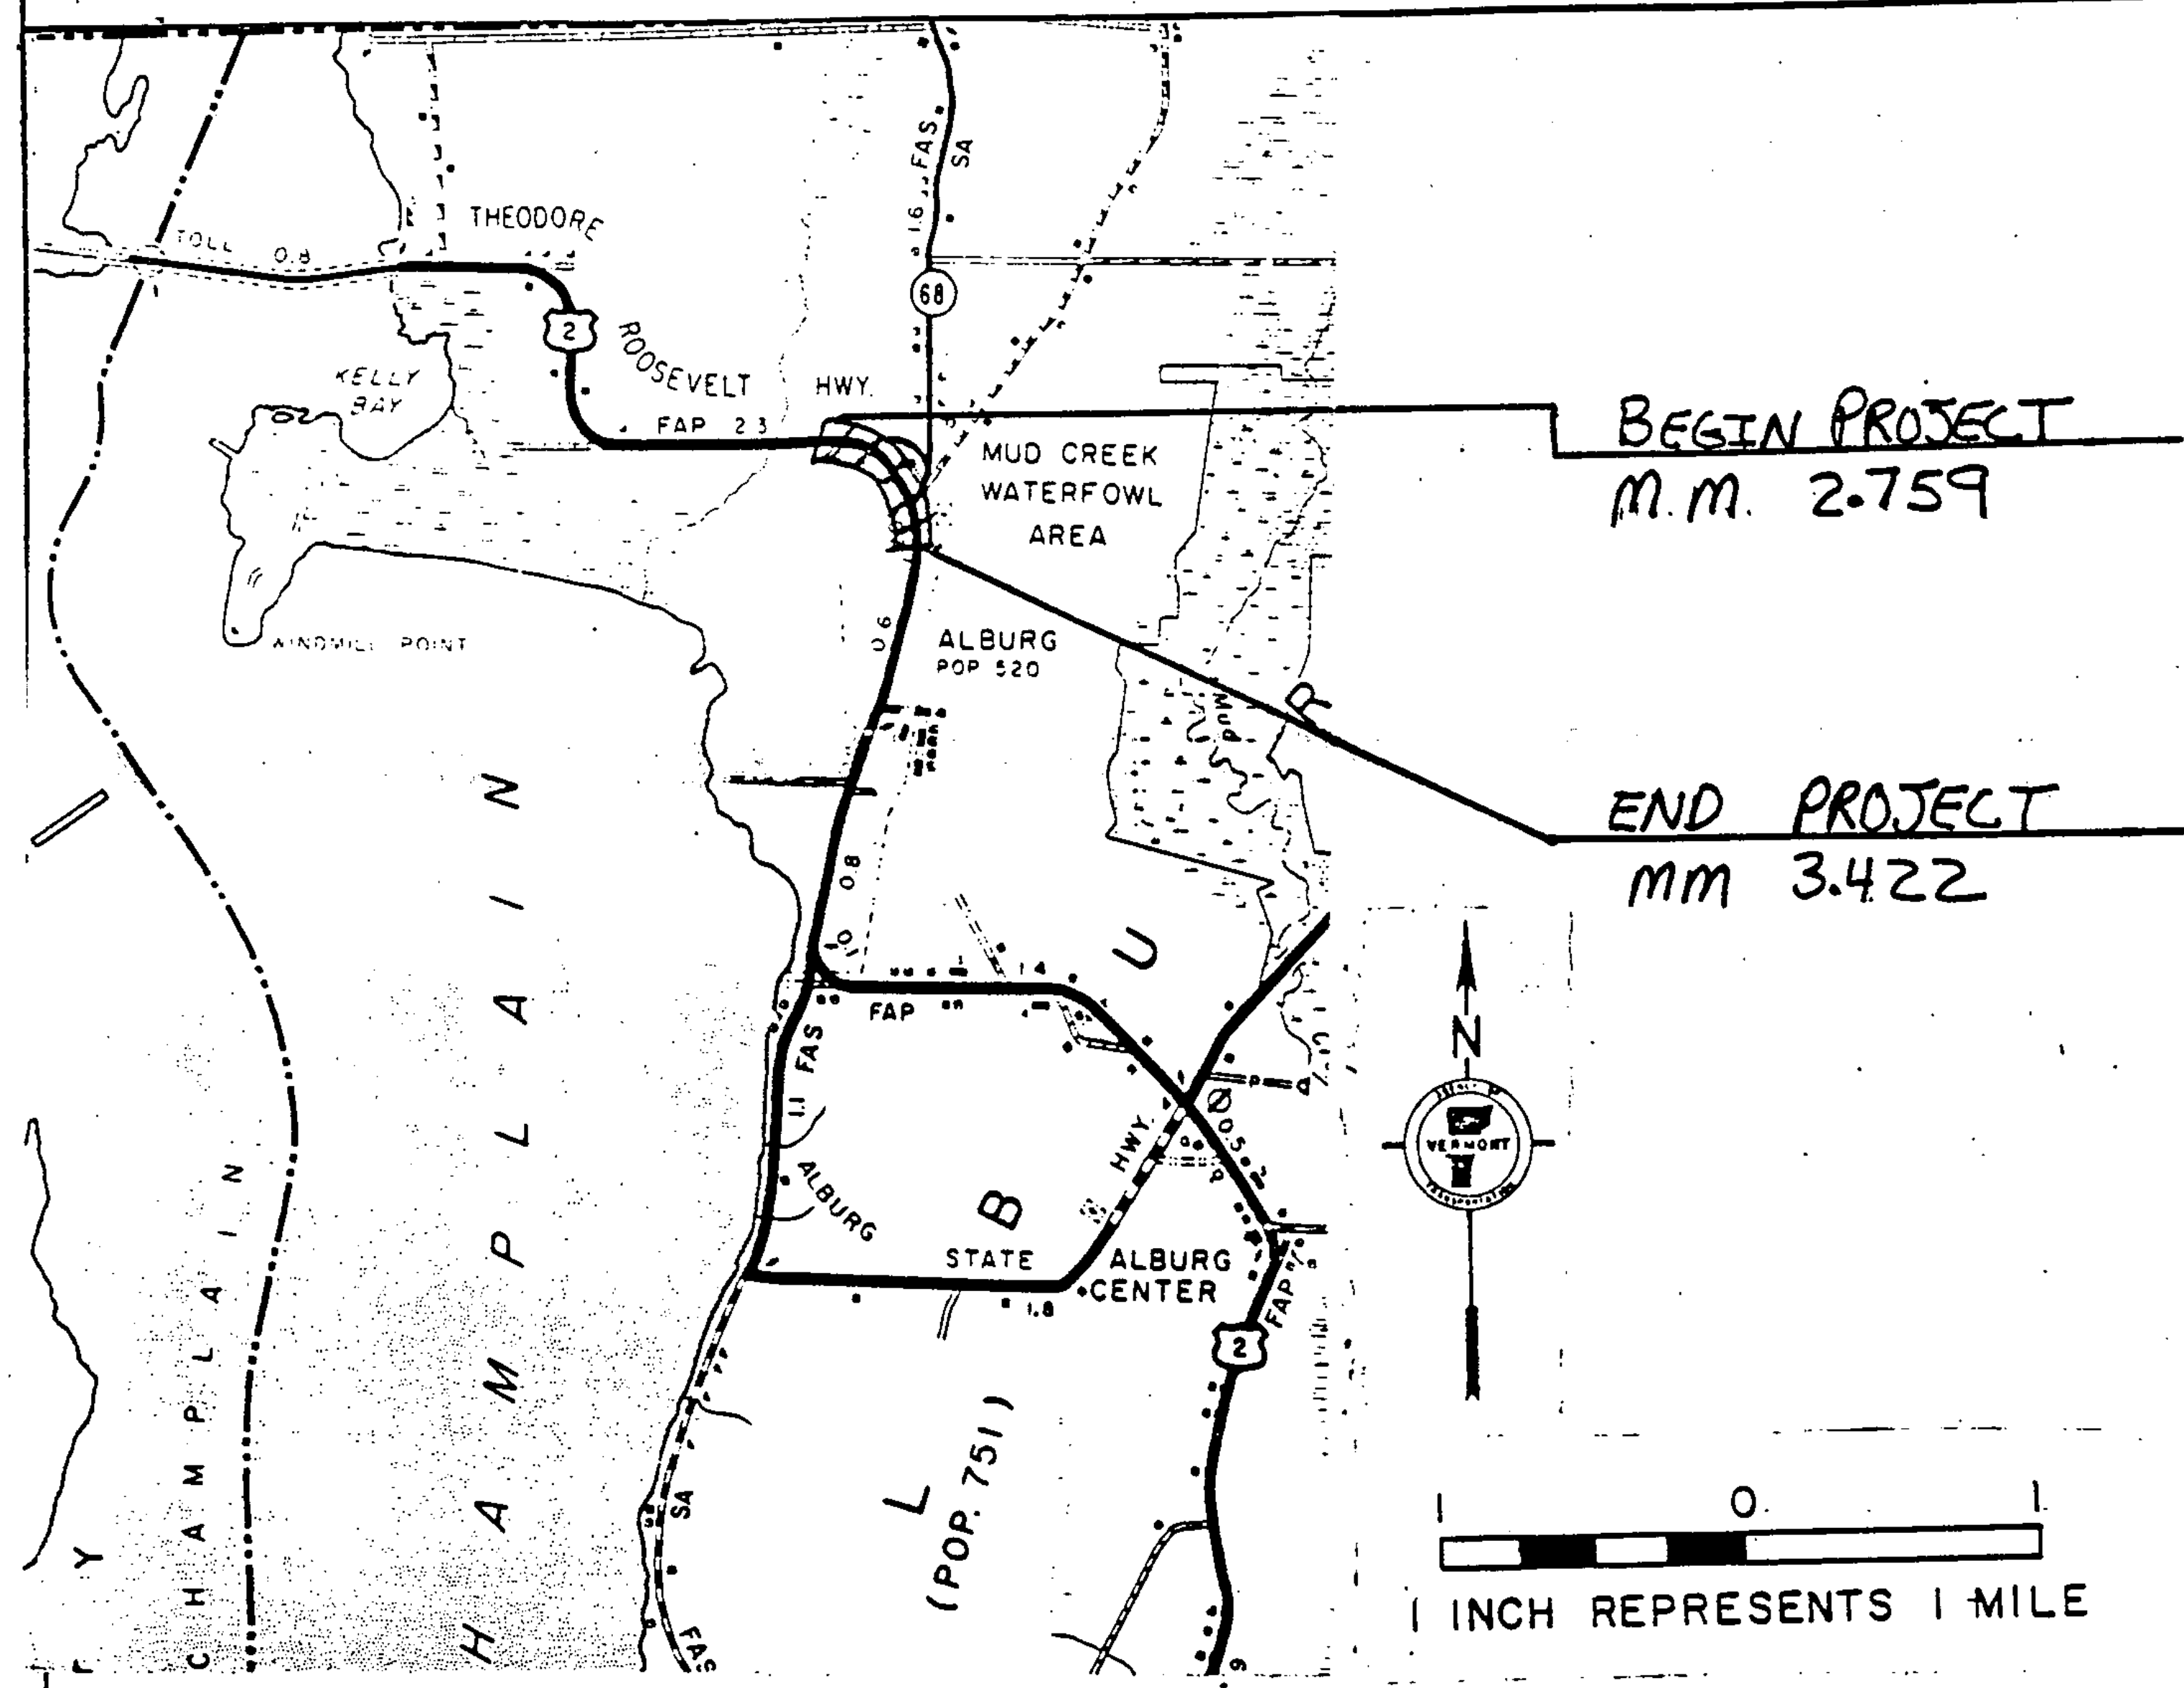

IN ALBURG, beginning at a point on US2 (mm 2.759)  
 2.759 miles east of NEW YORK - VERMONT state line and  
 extending 0.663 miles east to mm 3.422.

LENGTH OF PROJECT: 0.663 miles  
 3501 Feet

TRAFFIC DATA  
 1982 ADT = 2900  
 V = 50 MPH