


TYPICAL SECTIONS & DESIGN DATA

ITEM 406.25 BITUMINOUS CONCRETE PAVEMENT
LEVELING COURSE, TYPE III OR IV (24' WIDE @ 327^{TONS}/mi.)
AS DIRECTED BY THE ENGINEER
1" WEARING COURSE, TYPE III

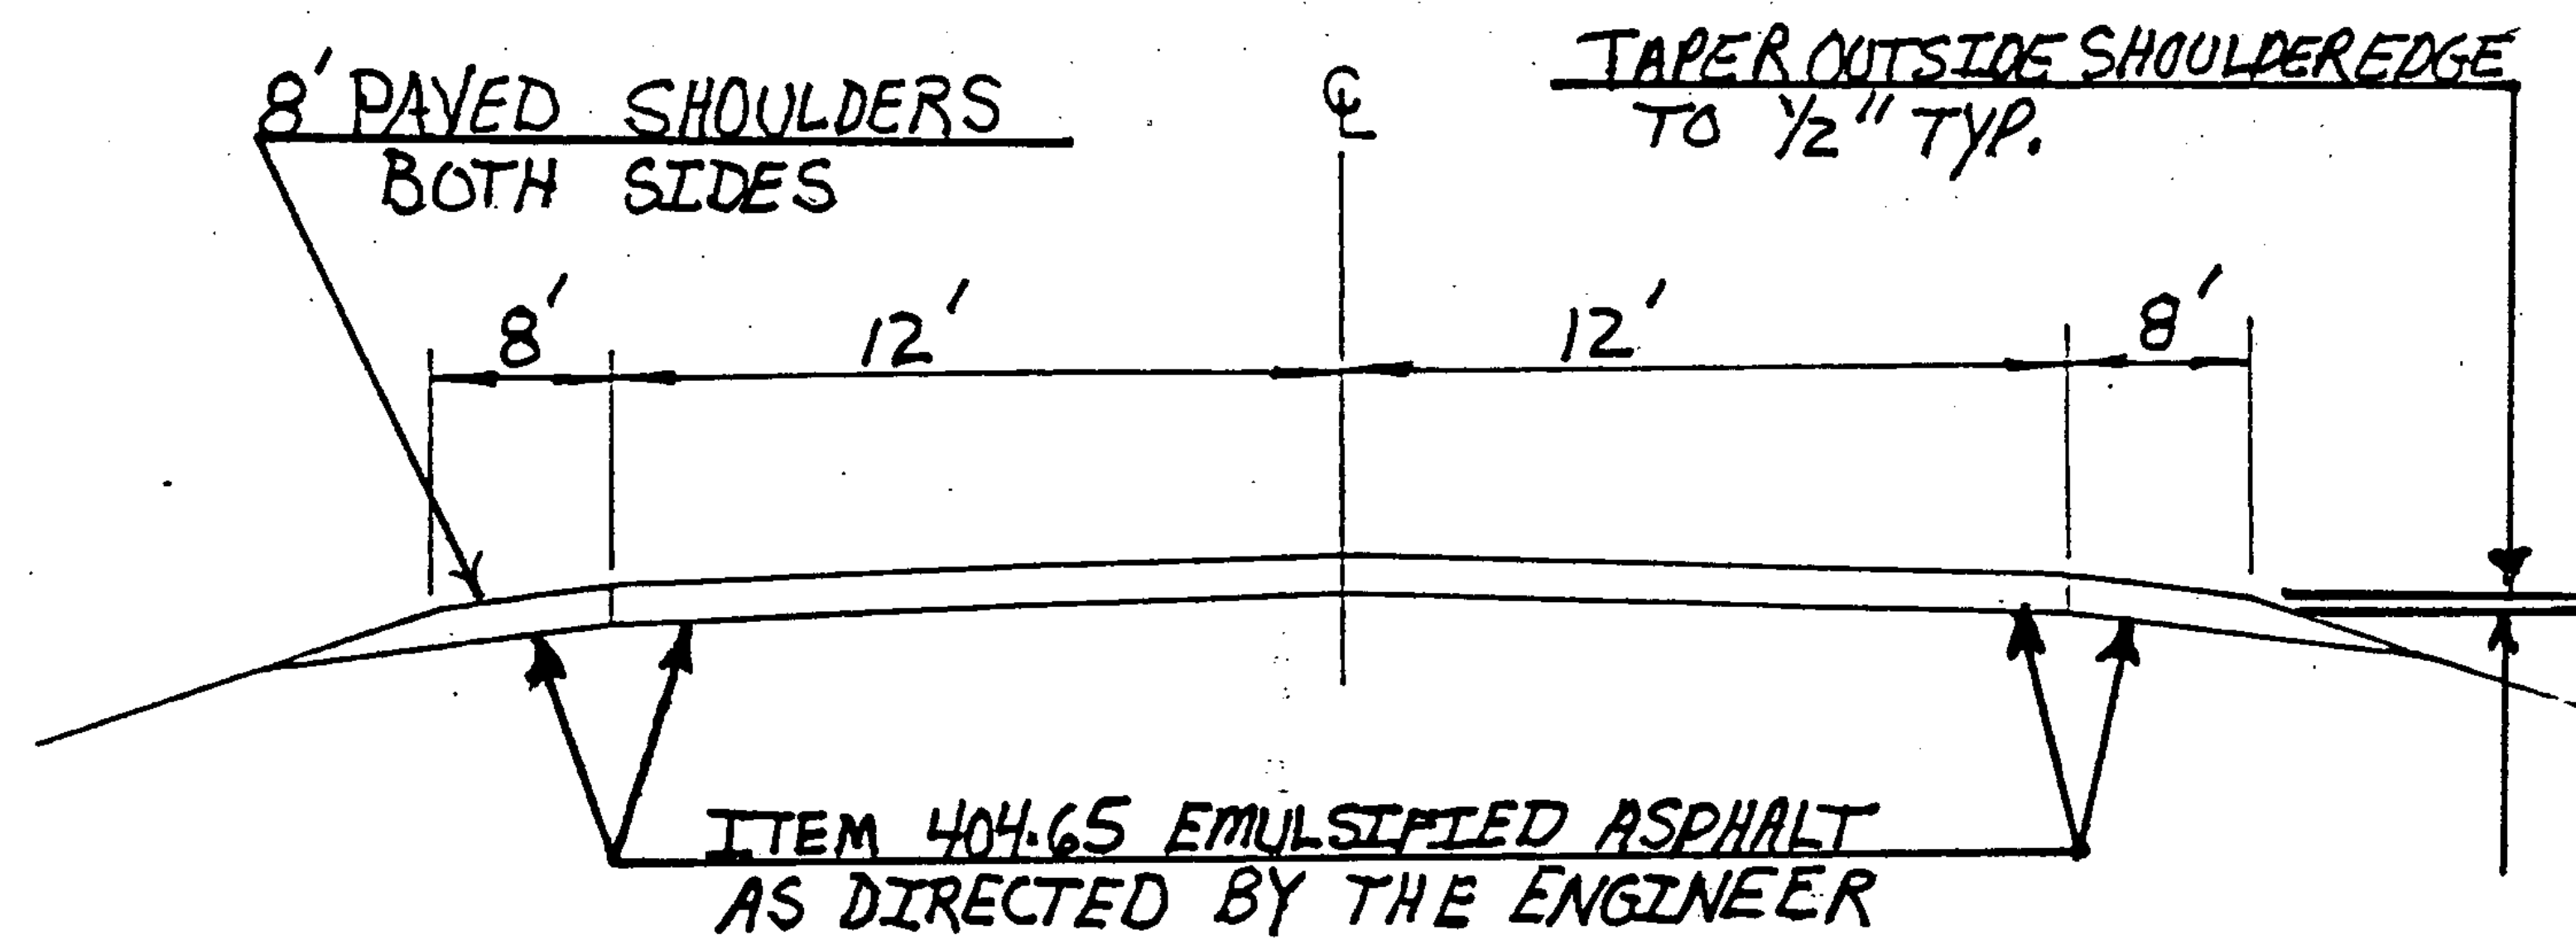

ALBURG mm 2.759 ~ mm 3.422

PROJECT ALBURG

NO. F028-1(14)S

SHEET 8 OF 18 SHEETS