


# PROJECT DESCRIPTION AND LOCATION

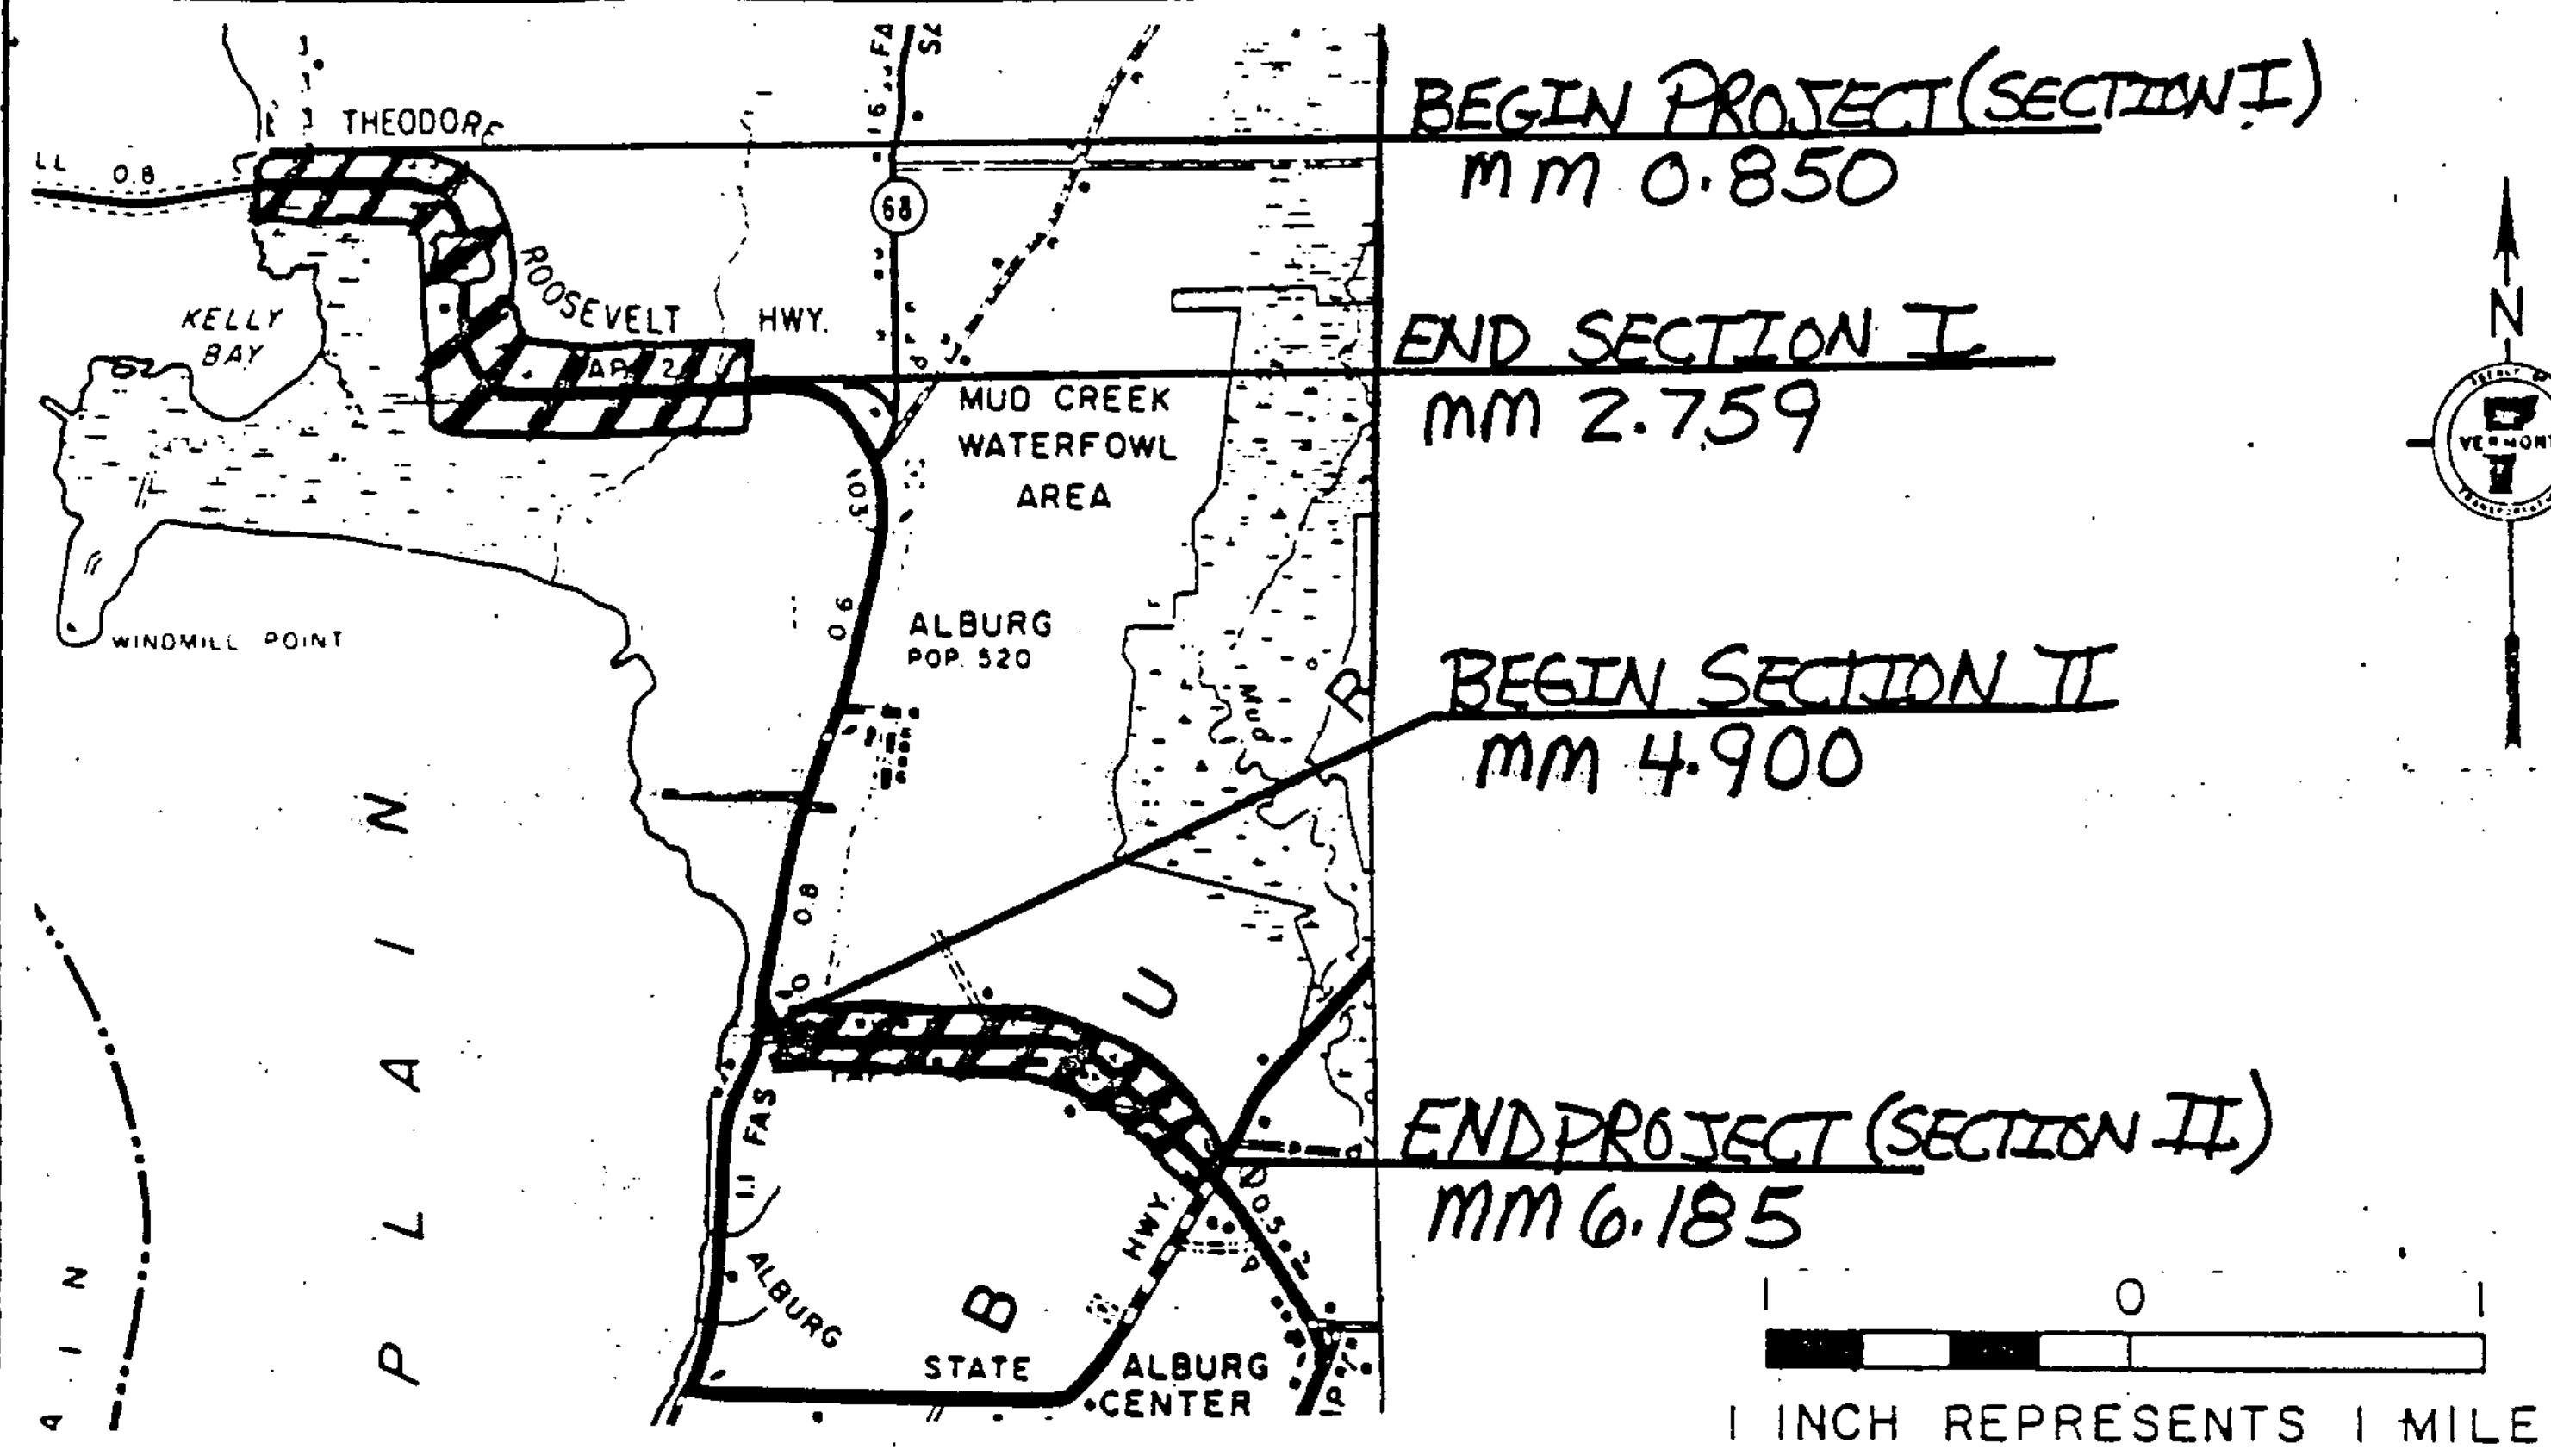

IN ALBURG, beginning at a point on US2 (sec I) (mm 0.850) 0.850 miles east of the Vt.-N.Y. state line and extending 1.909 miles to mm 2.759. SEC. II beginning at a point on US2 (mm 4.900) at the easterly village line and extending easterly for 1.285 miles to the junction of Vt. 78 and US 2 (mm 6.185)

TRAFFIC DATA  
1982 ADT = 2730  
V = 50 MPH

LENGTH OF PROJECT: (SEC. I) 1.909 miles  
10079 FEET  
(SEC. II) 1.285 miles  
6785 FEET

TOTAL 3.194 miles  
16864 FEET

PROJECT ALBURG

NO. HMA 2613

SHEET 11 OF 18 SHEETS