


TYPICAL SECTIONS & DESIGN DATA

ITEM 406.25 BITUMINOUS CONCRETE PAVEMENT
LEVELING COURSE, TYPE III OR IV (22' WIDE @ 300 TONS/mi.)
AS DIRECTED BY THE ENGINEER (22' WIDE @ 250 TONS/mi.)
1" WEARING COURSE, TYPE III

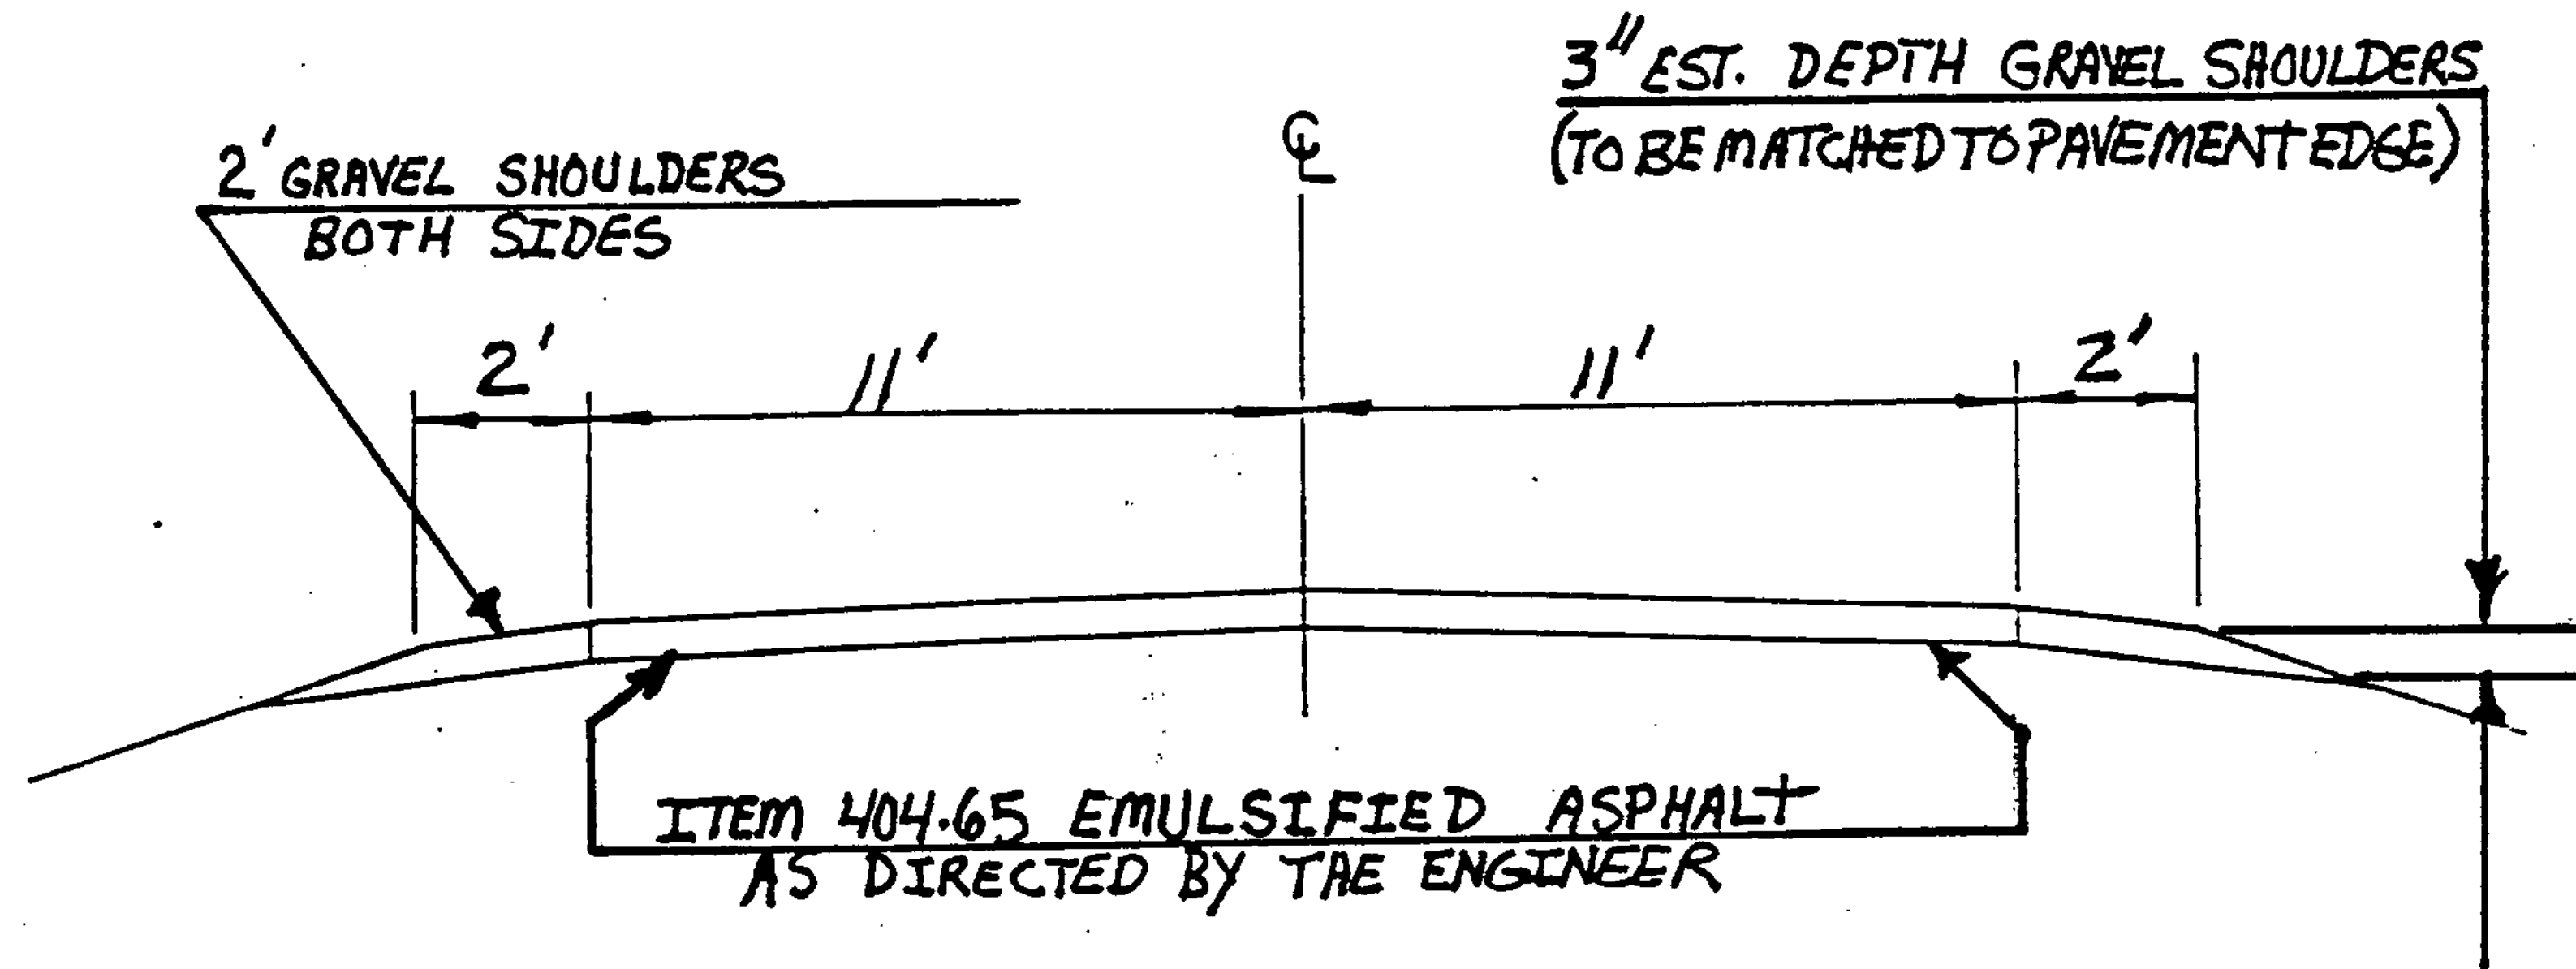

ALBURG m m. 0.850 ~ mm 2.759
mm 4.900 ~ mm 6.185

PROJECT ALBURG

NO. HMA 2613

SHEET 12 OF 18 SHEETS