


ITEM 406.25 BITUMINOUS CONCRETE PAVEMENT  
LEVELING COURSE TYPE III OR IV 1/2"  
AS DIRECTED BY THE ENGINEER  
1 1/2" WEARING COURSE TYPE III ( $\pm 1/4$ "

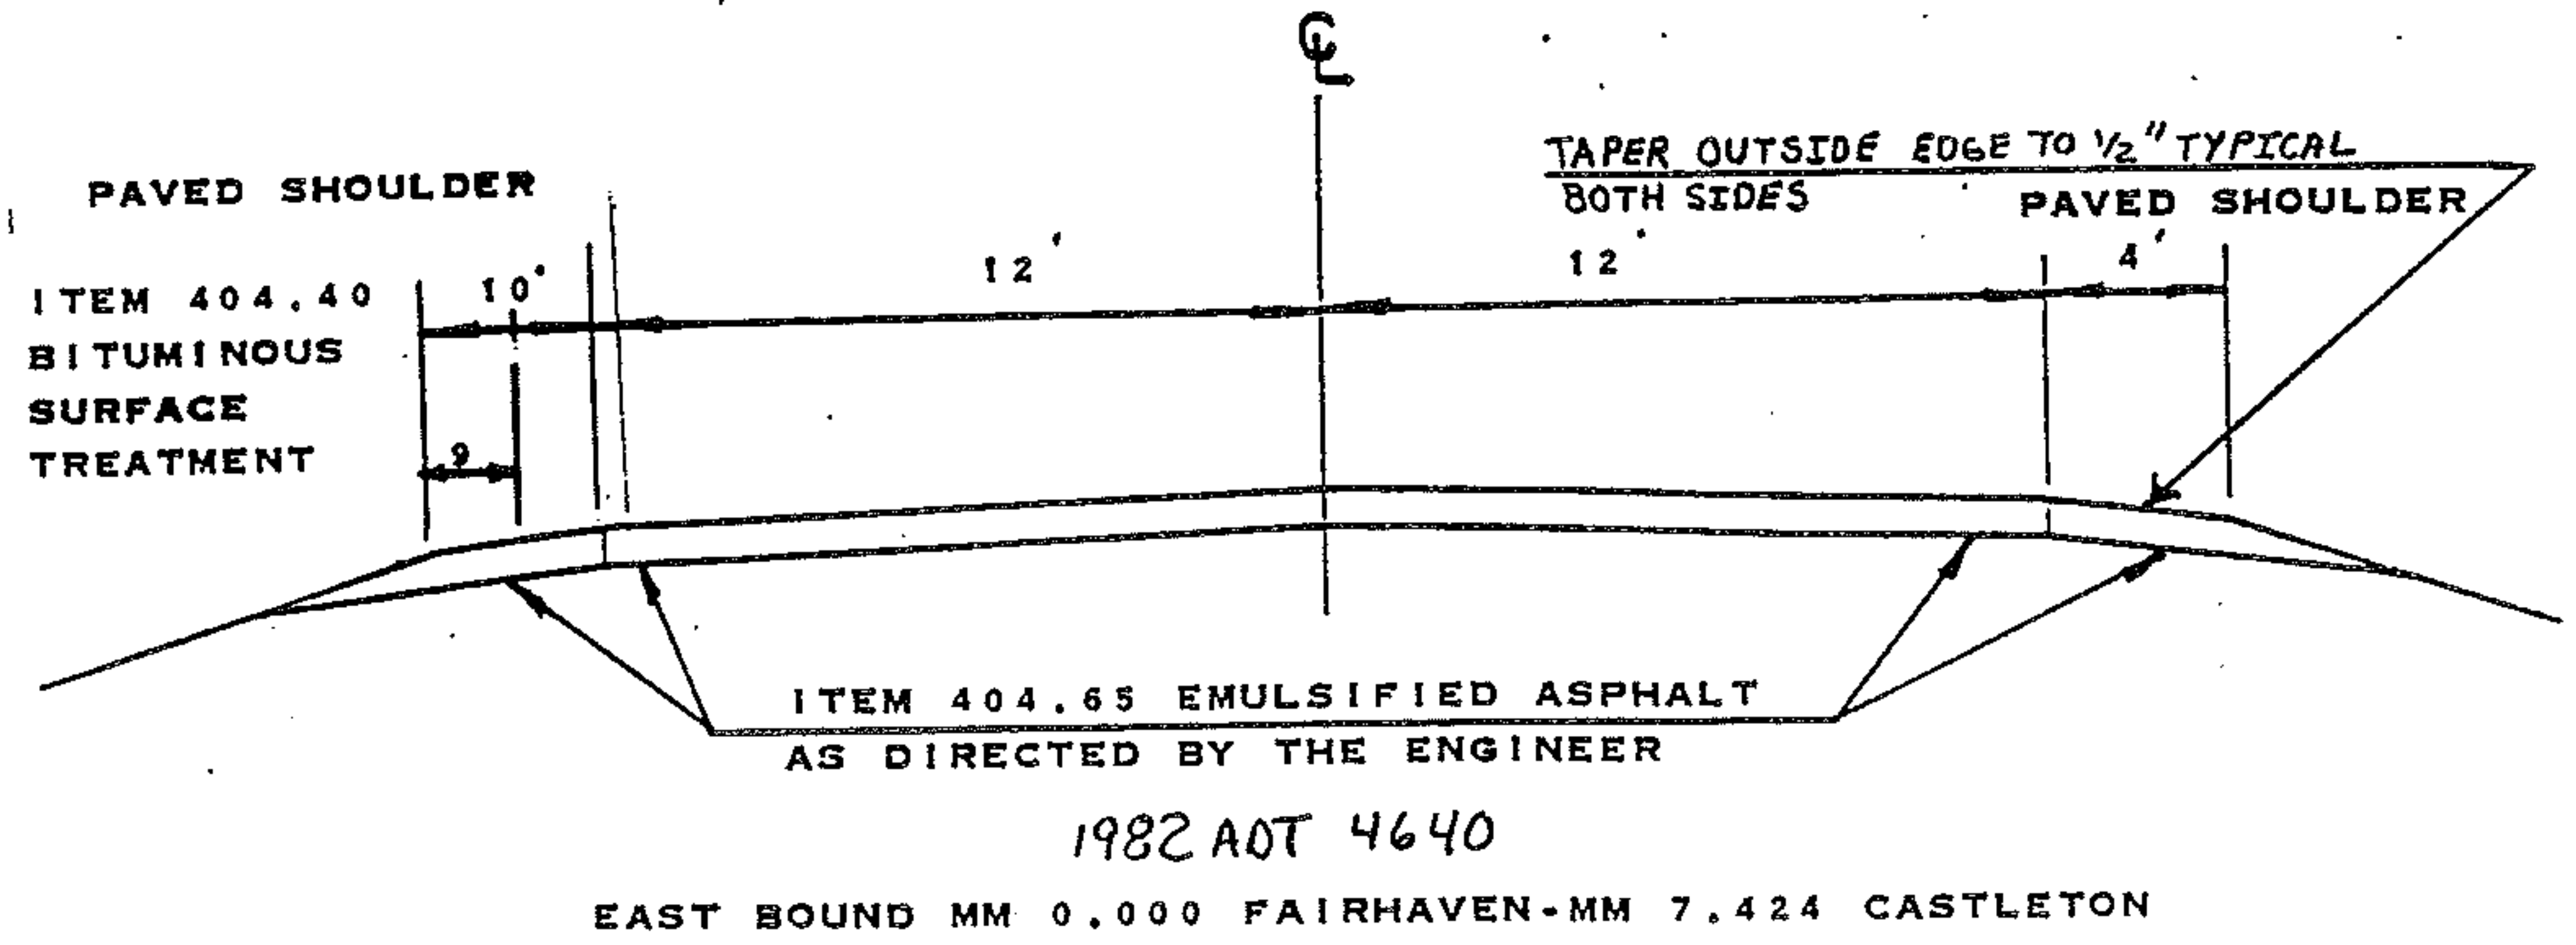

Note: Topsoil, Item 653.10 to be applied as directed by the Engineer.  
Seed, Fertilizer, Limestone and Mulch Items to be applied as required,  
payment to be subsidiary to the Topsoil item.